


SECTION

TOWNSHIP 33 S., RANGE 4 W., W. M.

North

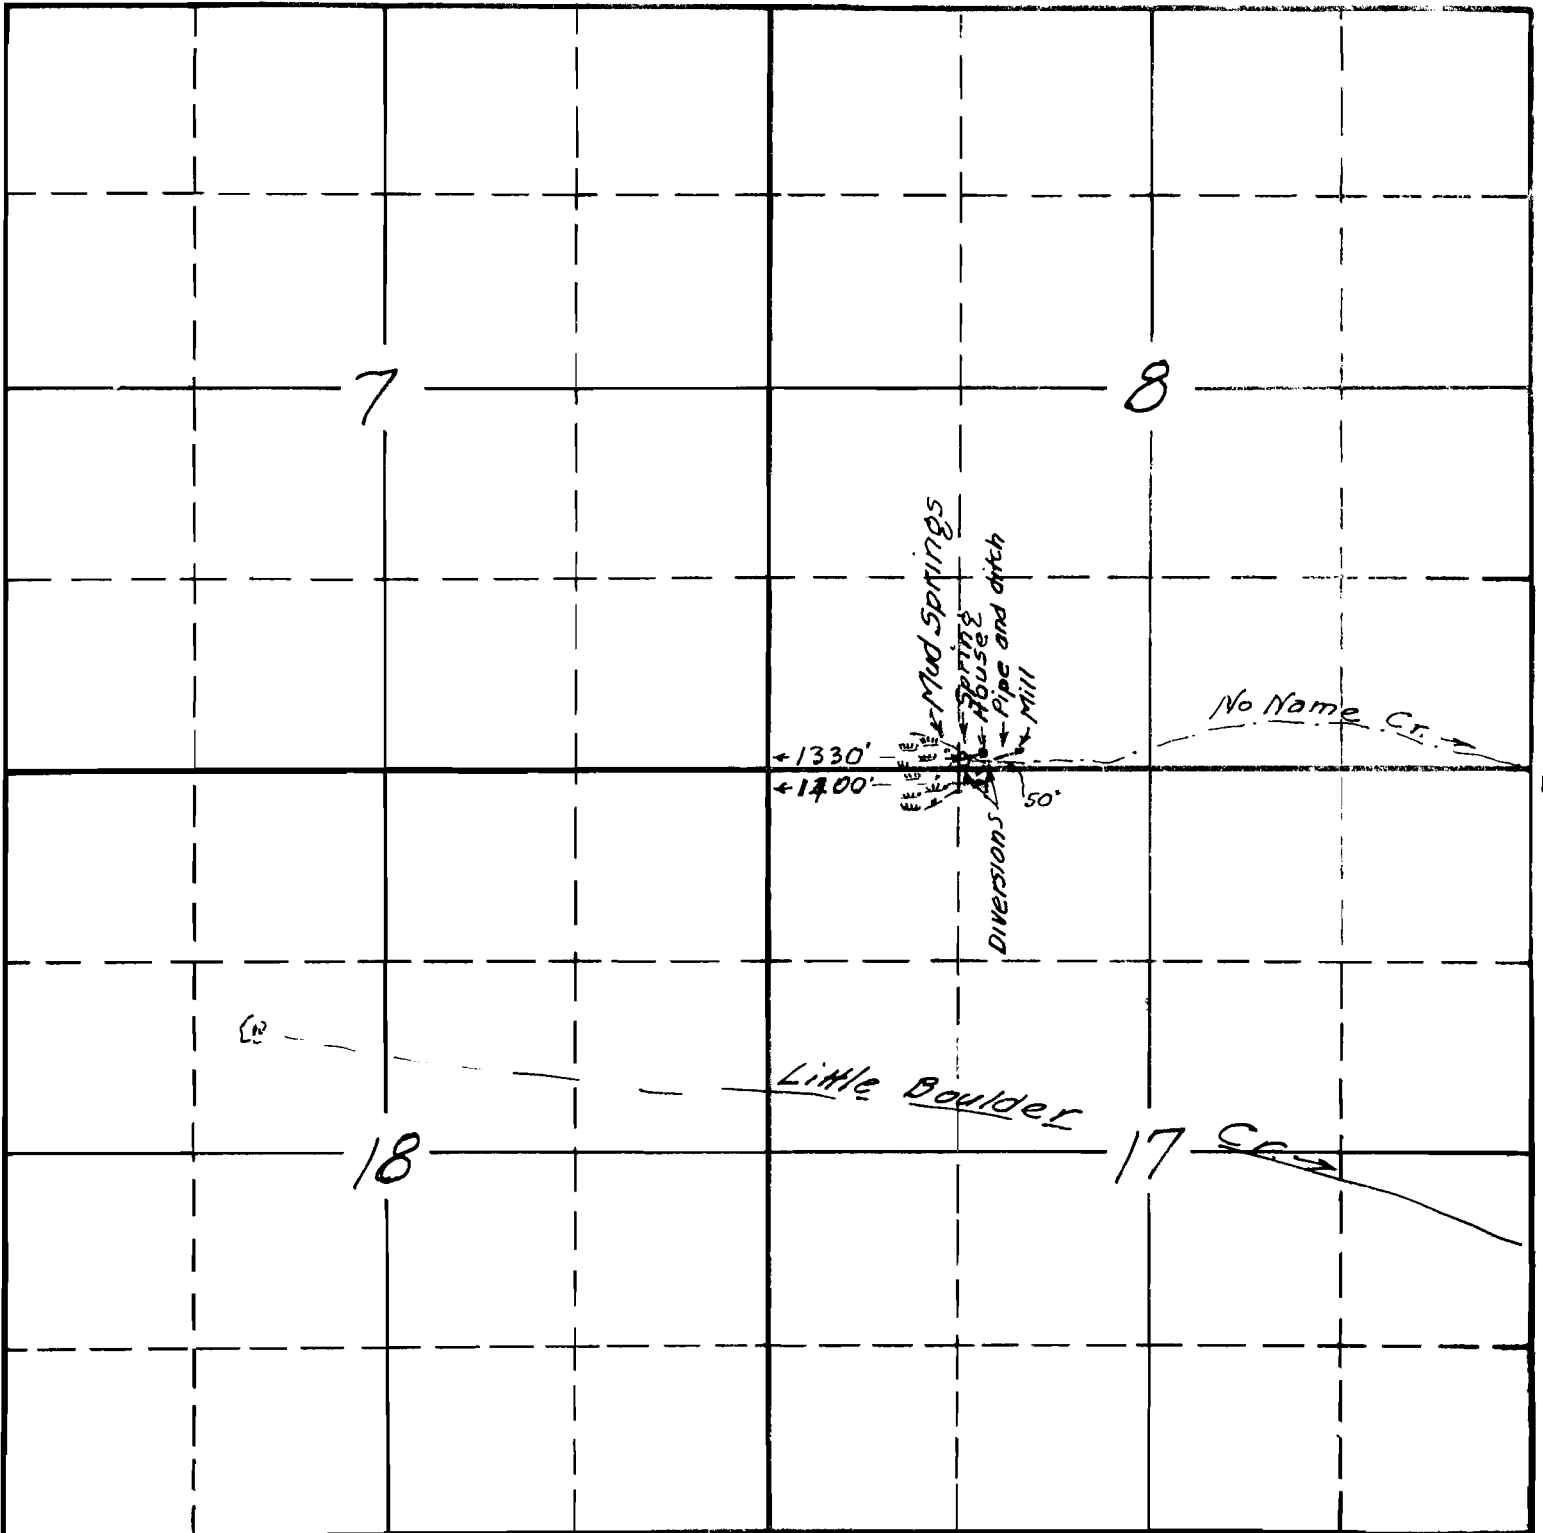

South

Bert McTimmonds and Roy H. Edwards
April 1937

APPLICATION No. 16862
PERMIT No. 12622