


Surveyed June 29 1940 C.A.C

App. 16870  
Permit 12627

SECTION

TOWNSHIP 22 S, RANGE 9 W, W. M.

North

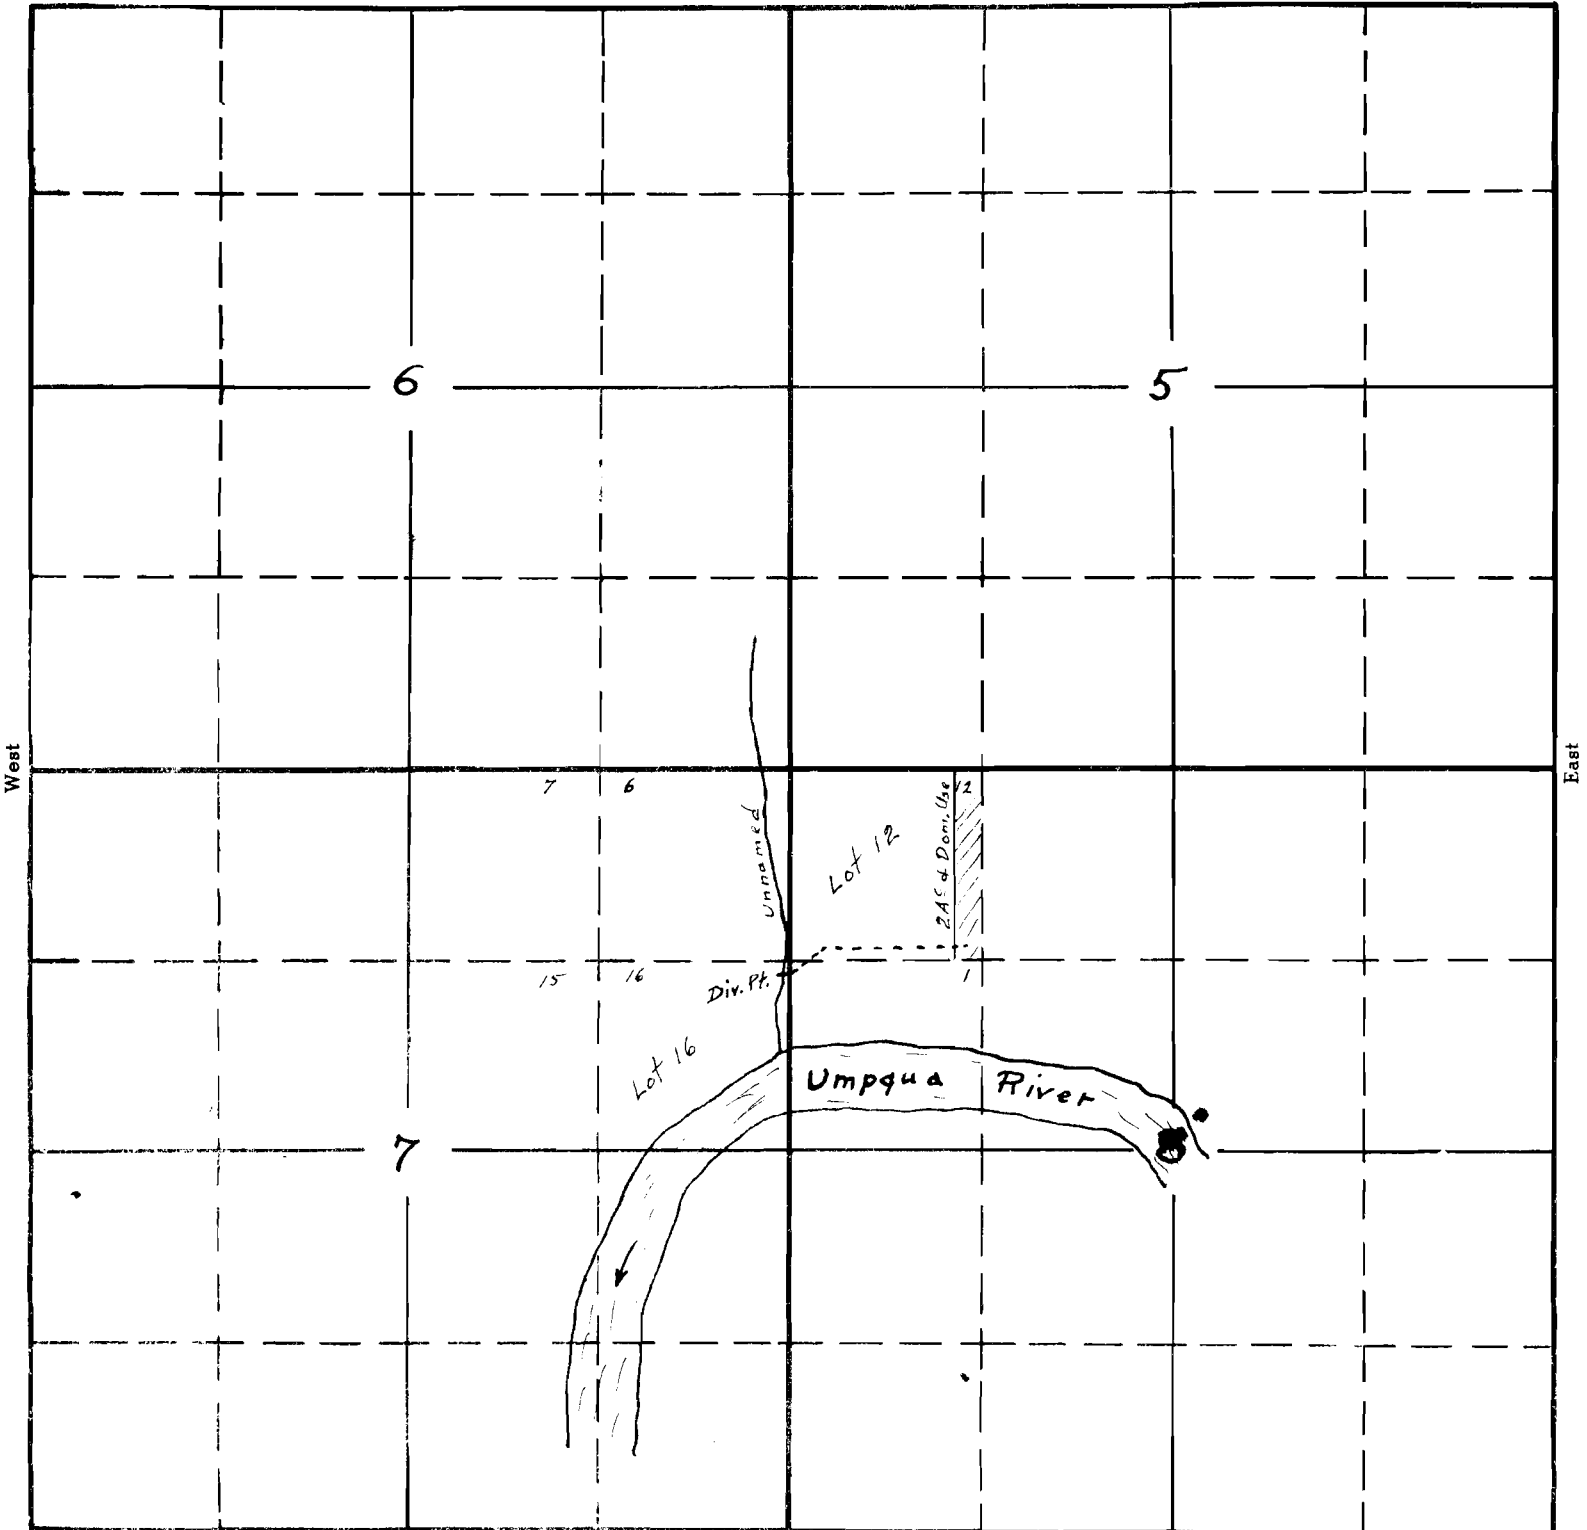

South

Copied from applicant's sketch - 5/19/37.

APPLICATION No. 16870  
PERMIT No. 12627