


SECTION

TOWNSHIP 25, RANGE 9 10, W. M.

North

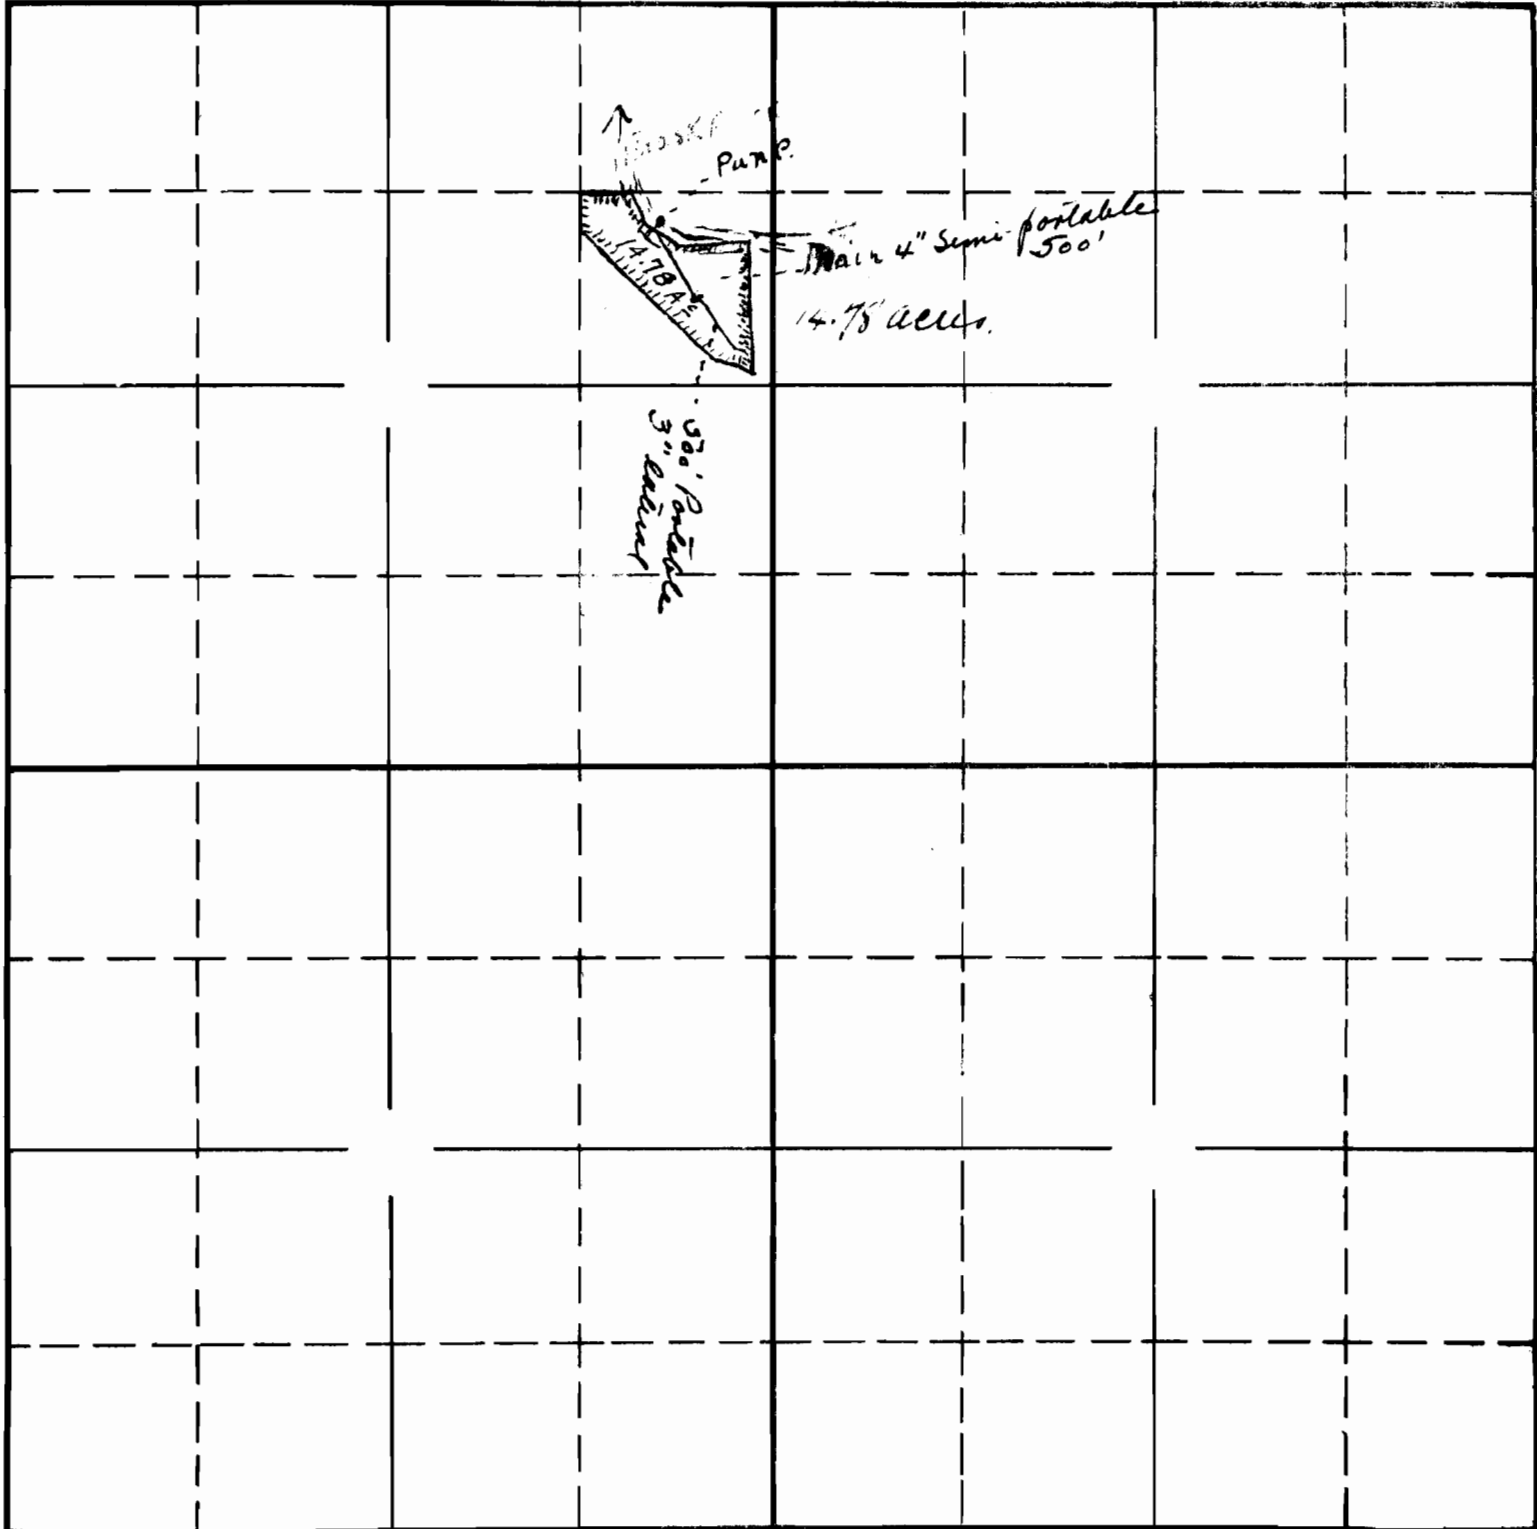

South

1-19-16873  
APPLICATION No. 16873  
PERMIT No. 12630