


SECTION

TOWNSHIP 38S, RANGE 3W, W. M.

North

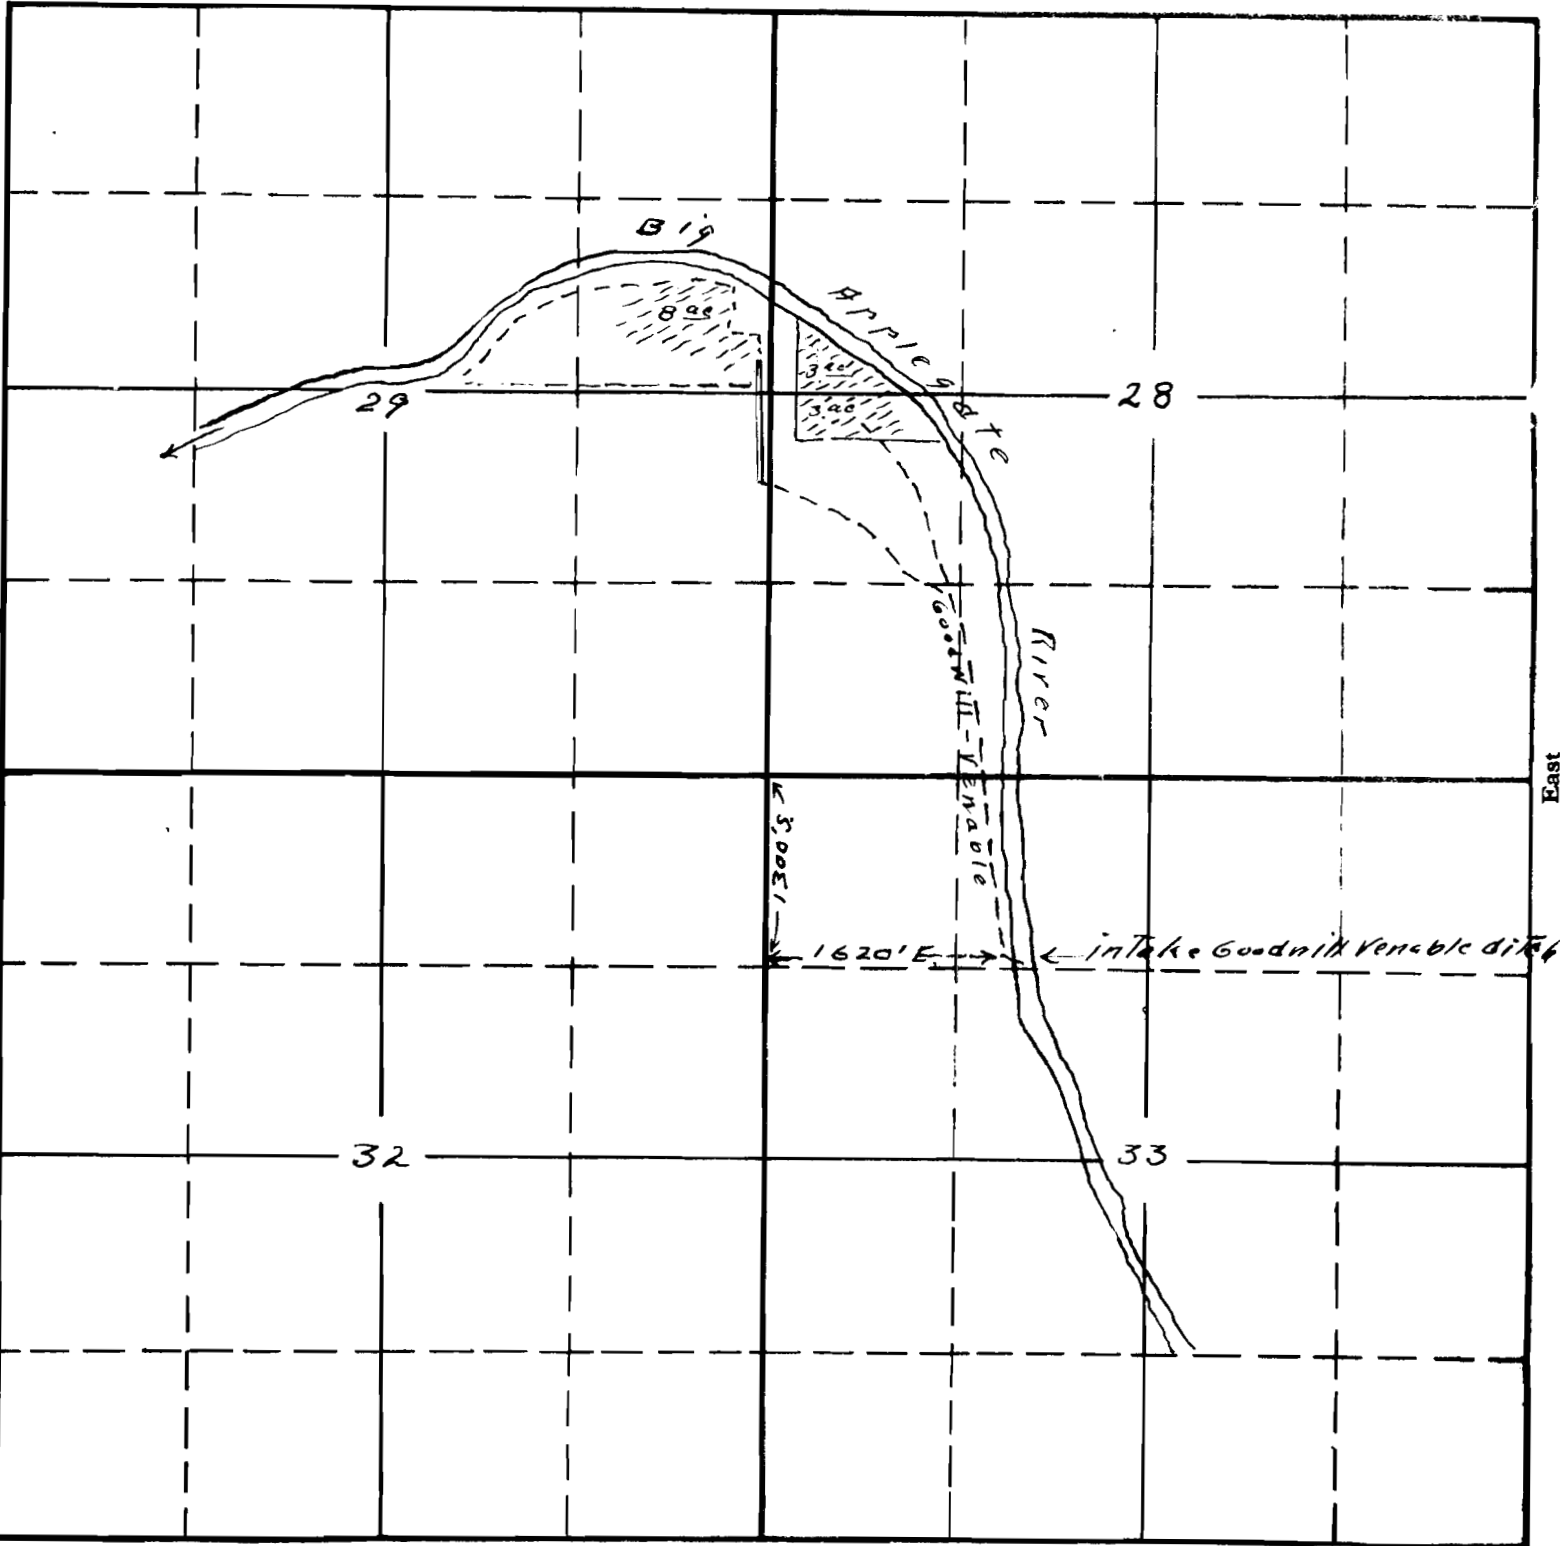

Sketch to accompany application of W. M. Smith for use of the waters of the Big Applegate River for irrigation purposes

APPLICATION No. 16882

PERMIT No. 12639