SECTION 8

TOWNSHIP 36-S, RANGE 1 W, W. M.

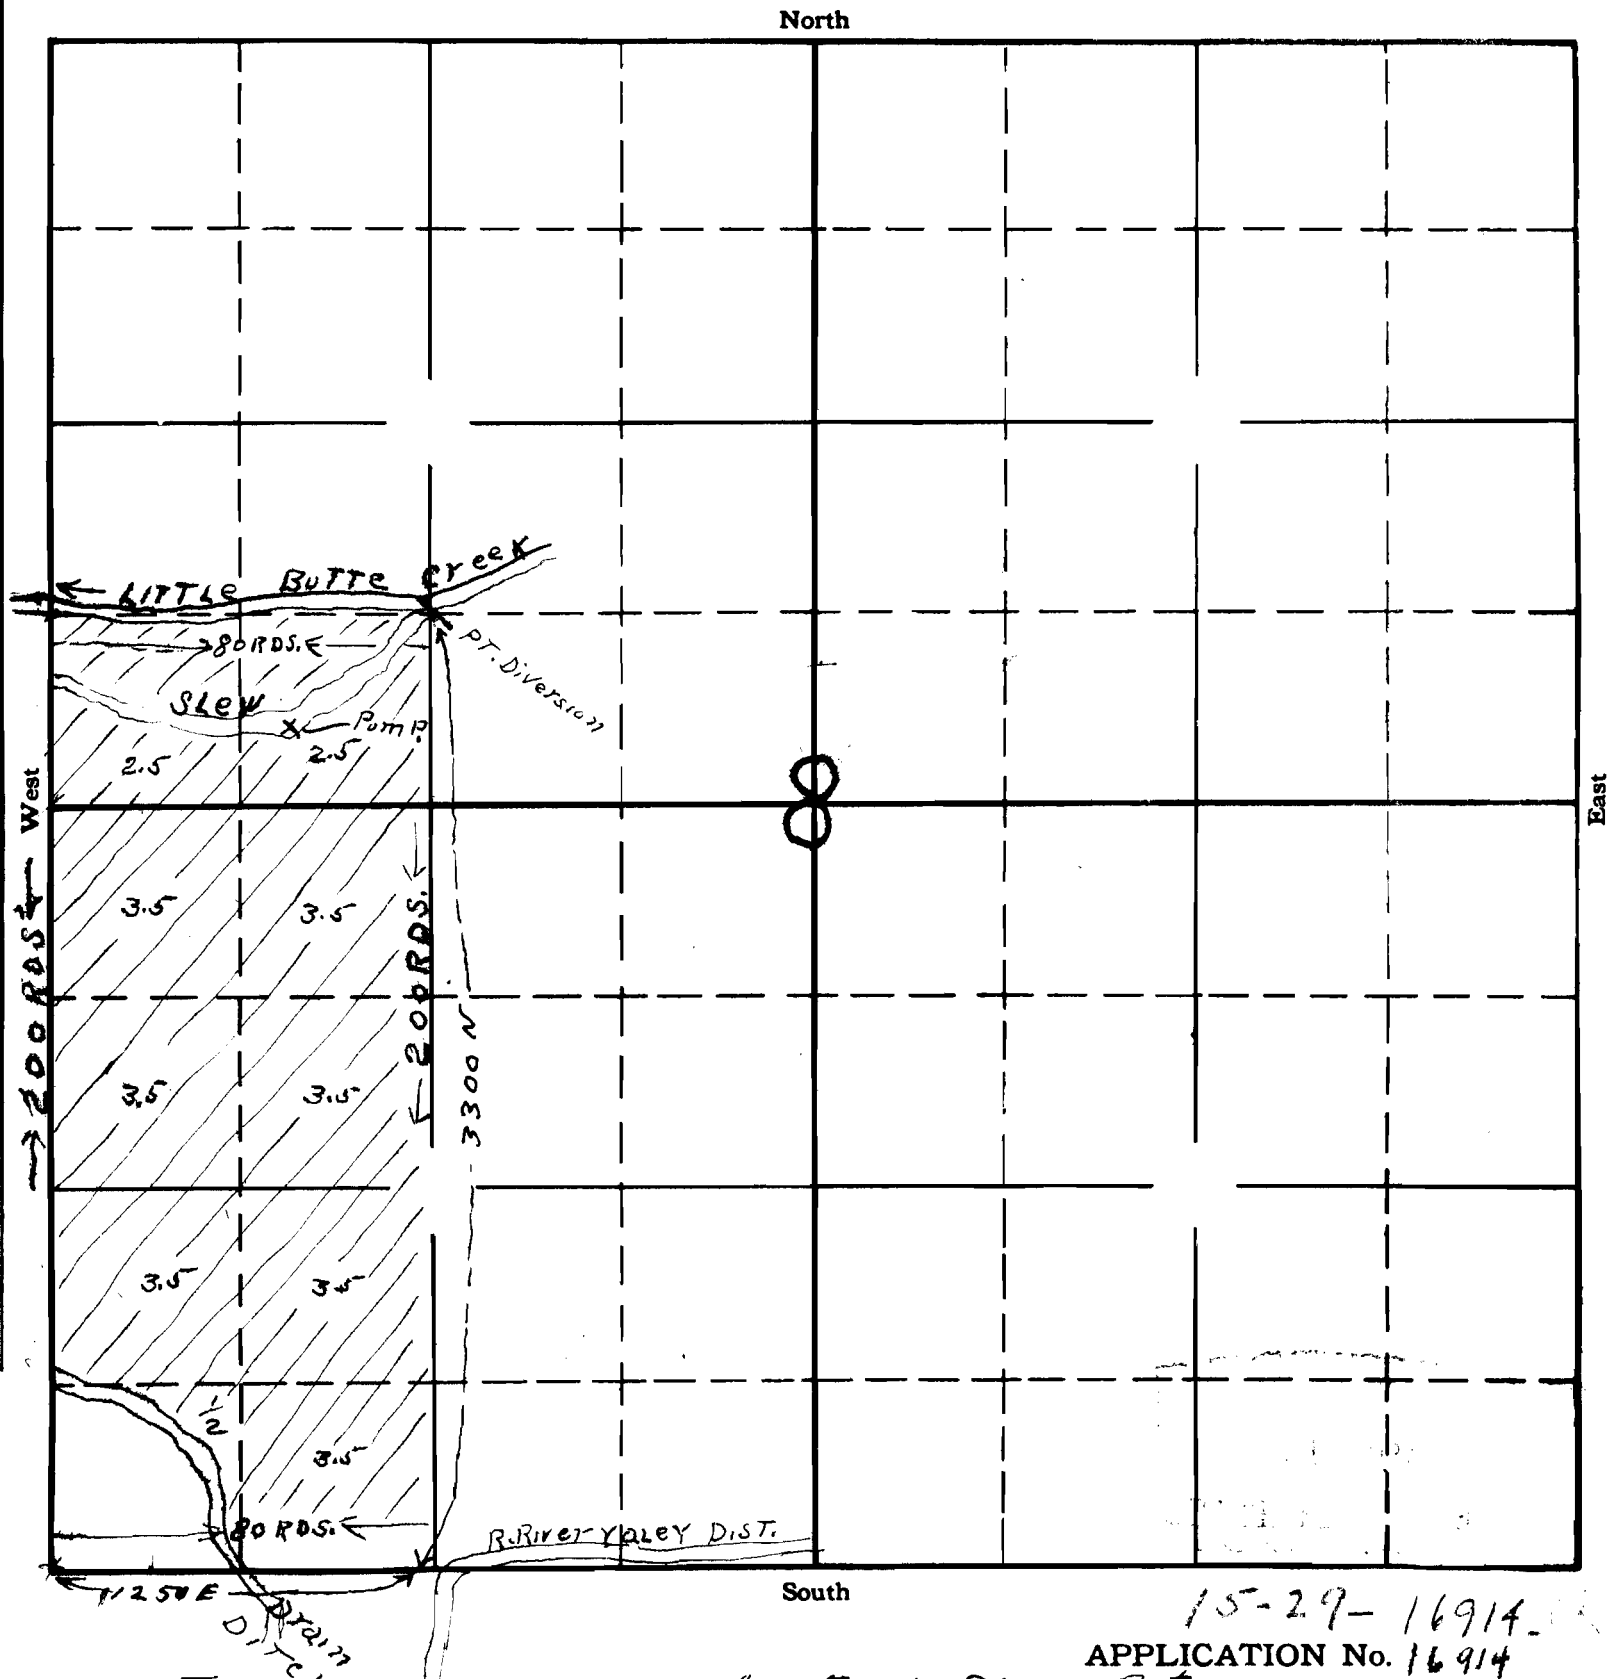


15-29-16914

APPLICATION No. 16914

PERMIT No. 12672

Sketch made by Ed Nunn Mgr Eagle Pt. Irr Dist
To accompany application of Howard C and
Thelma M Short to appropriate the waters
of Little Butte through a slough for irrigation