


SECTION

TOWNSHIP 25, RANGE 44 E, W. M.

North

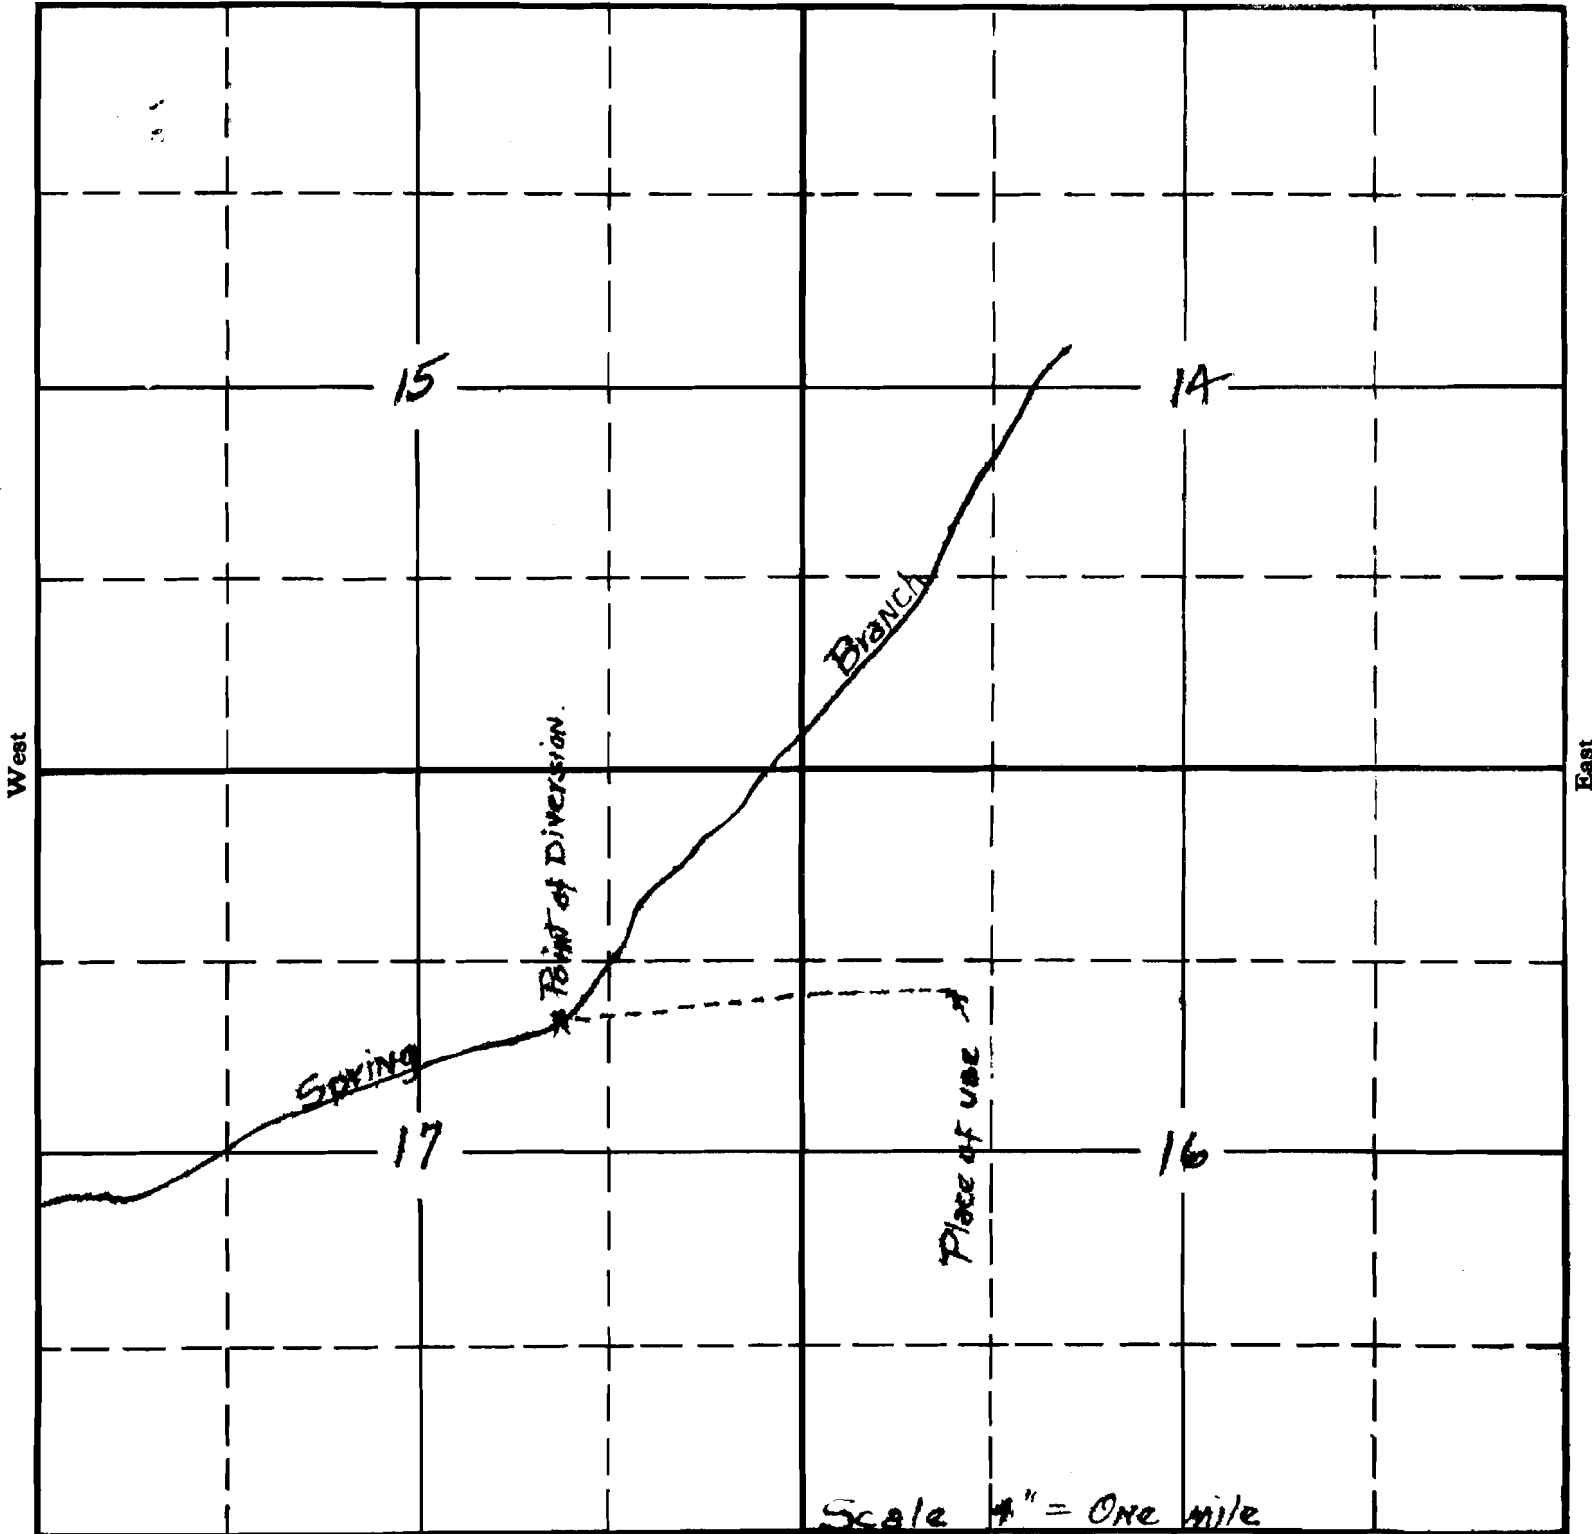

Scale 1" = One mile

South

8-35-16925-41
 APPLICATION No. 16925
 PERMIT No. 12682

JUN 7 1937
 REGISTERED