

SECTION


14

TOWNSHIP 6S., RANGE 5W., W. M.

North

West

East

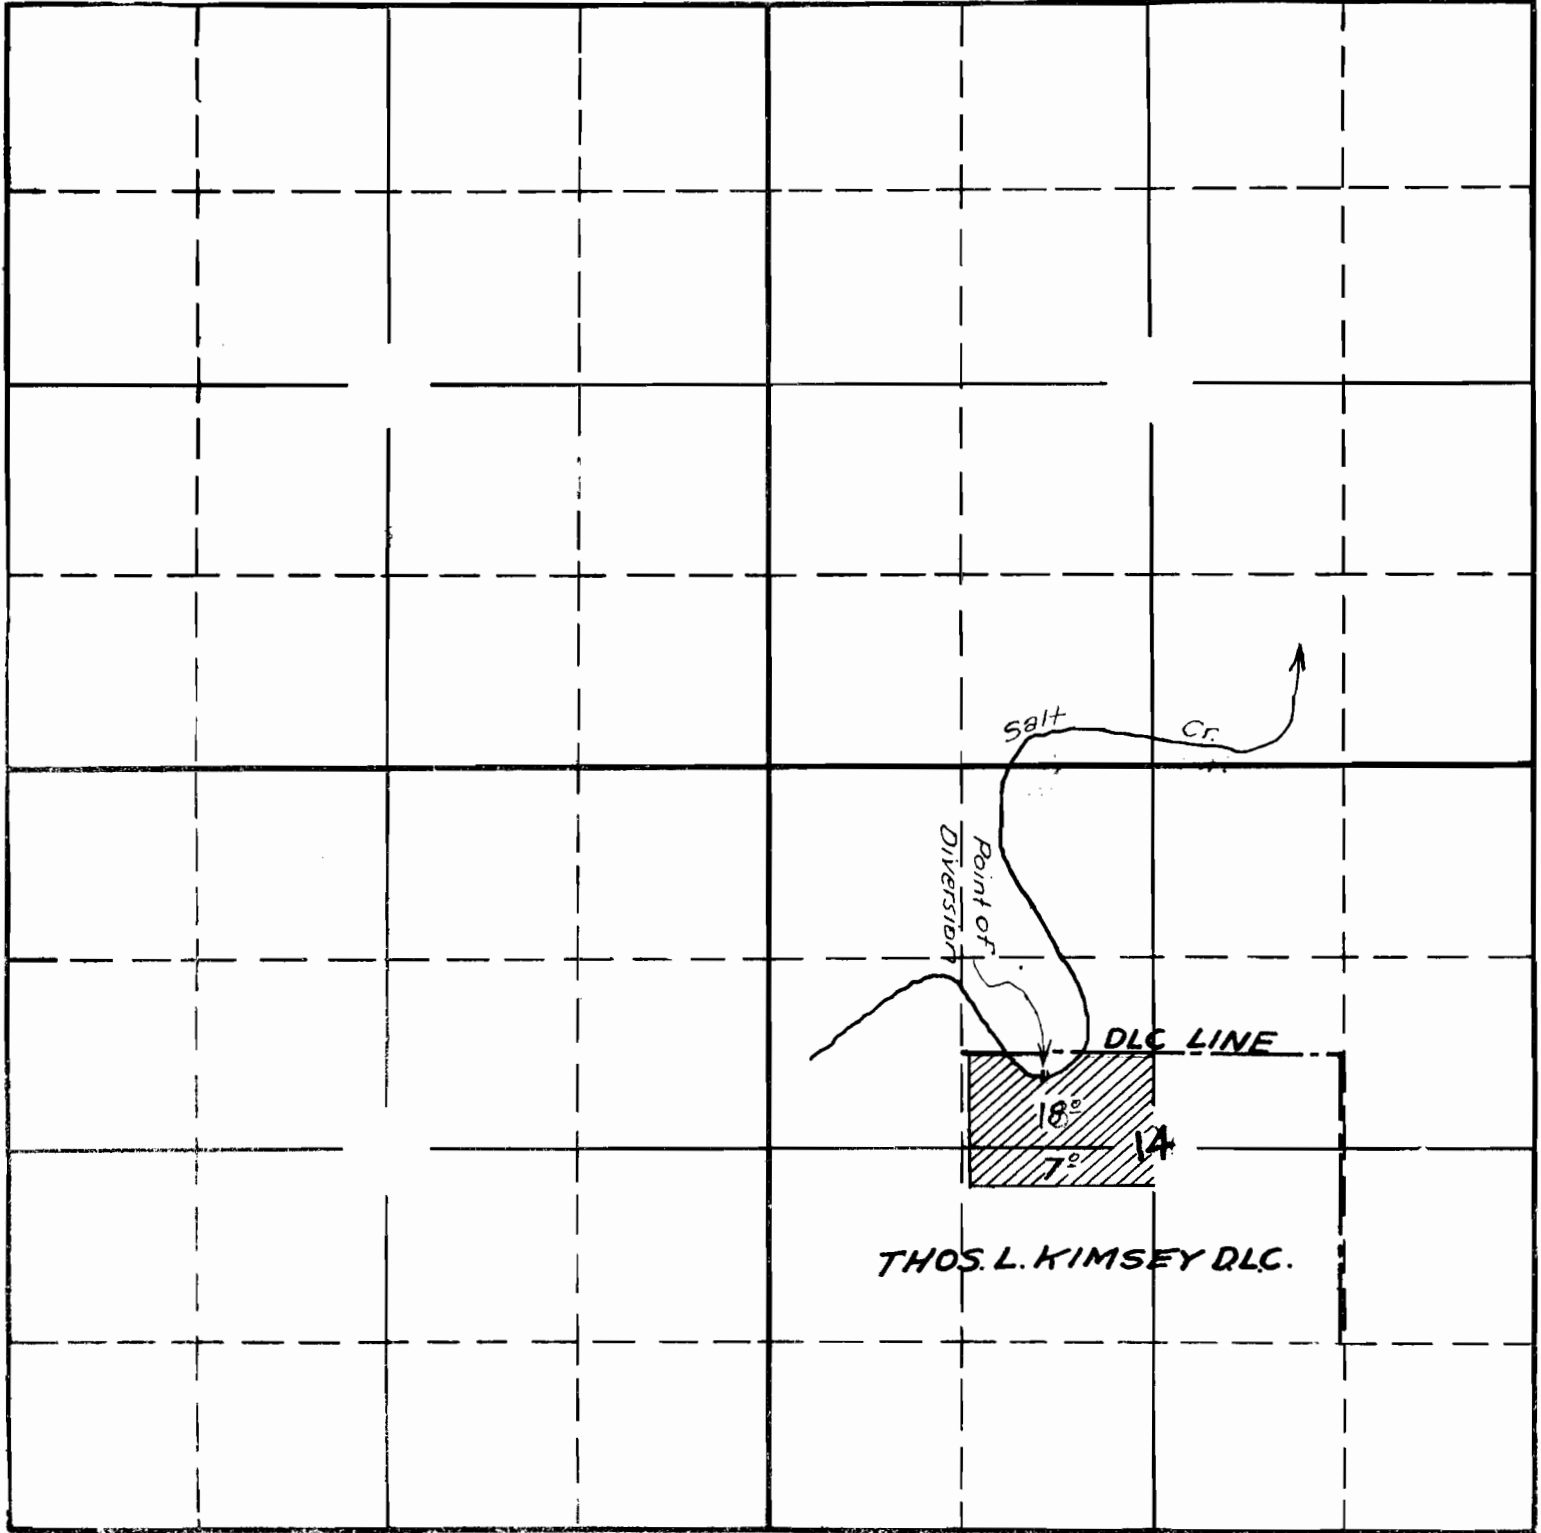


South

2-90B-16938
 APPLICATION No. 16938
 PERMIT No. 12688

SECTI

TOWNSHIP 65, RANGE 5W., W. M.

North

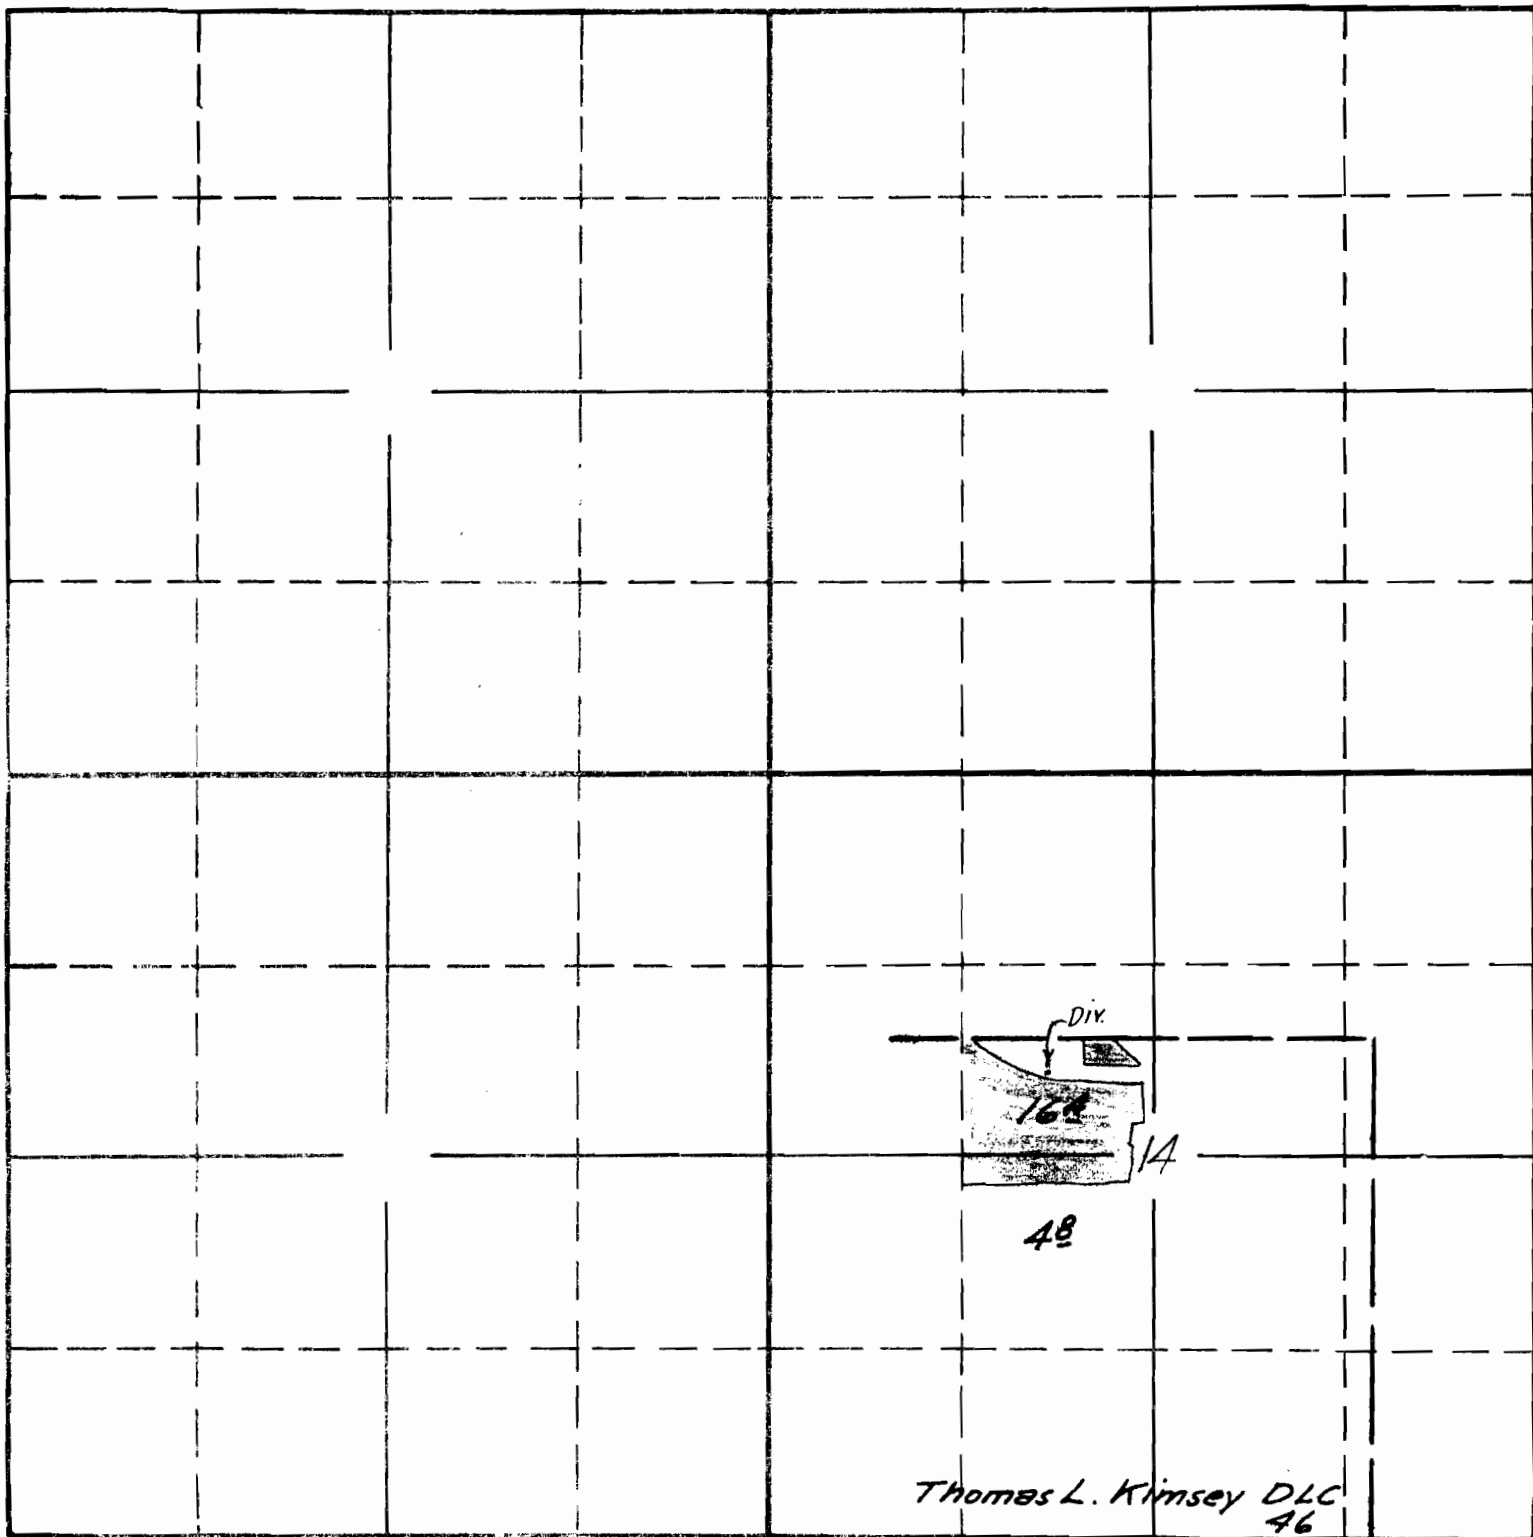

Thomas L. Kimsey DLC
46

Surveyed June 1 1940 C.A.C.

South

APPLICATION No. 16938

PERMIT No. 12688