


SECTION

# Conflict of Rights

Permit: S 12719  
Volume: 5  
Strm: JUMPOFF JOE CR  
Trib: ROGUE R  
Priority: 7/06/37

TOWNSHIP 35 S., RANGE 6 W.

North

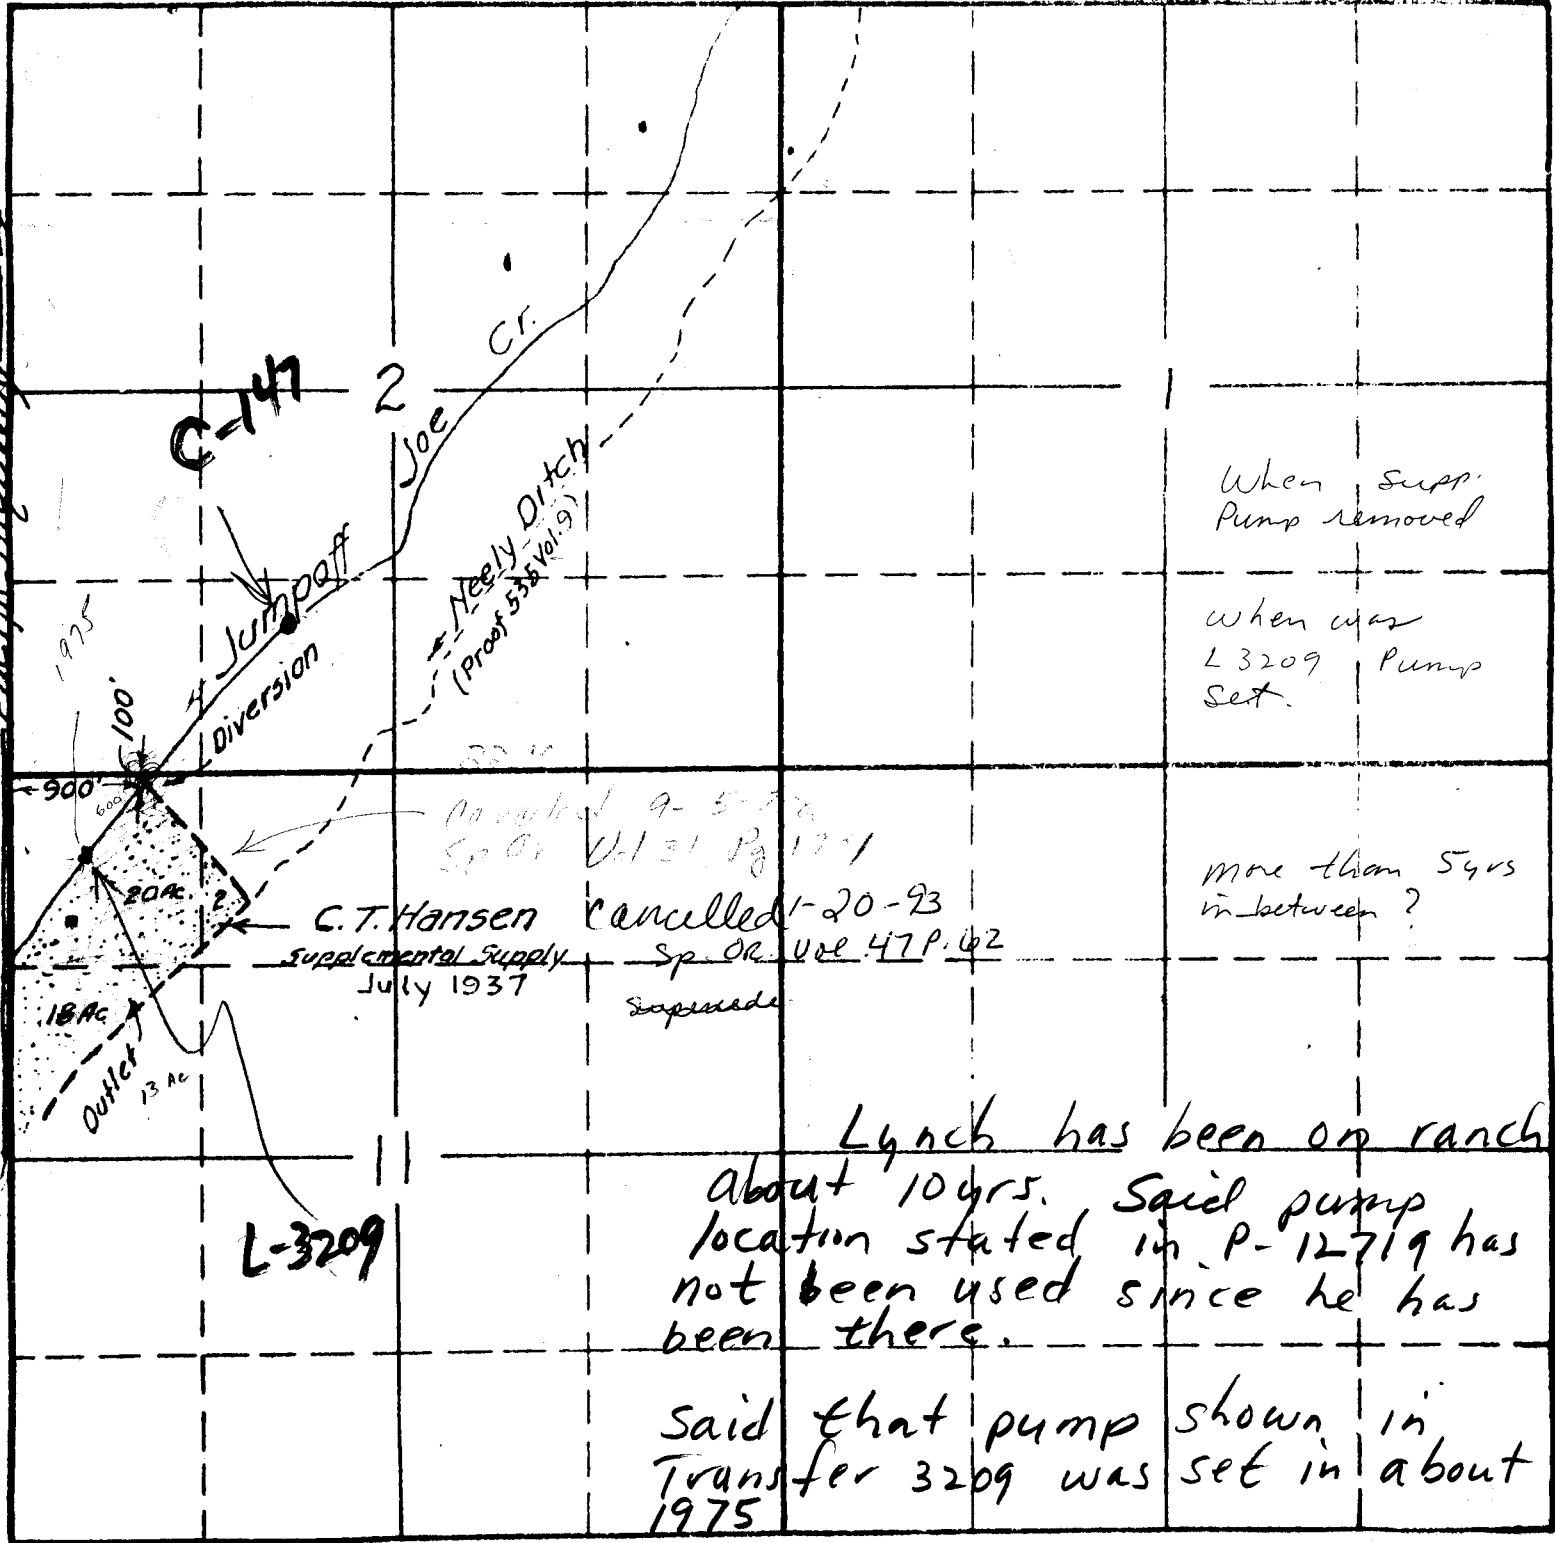

When Supp. Pump removed

When was L3209 Pump Set.

more than 5 yrs in-between?

C.T. Hansen cancelled 1-20-93  
Supplemental Supply Sp. OR. Vol. 47 P. 62  
July 1937

Lynch has been on ranch about 10 yrs. Said pump location stated in P-12719 has not been used since he has been there.

Said that pump shown in Transfer 3209 was set in about 1975

South


C-147 FROM DITCH

APPLICATION No. 16765  
PERMIT No. 12719

L-3209 - ALL LANDS IN P. 11

TOWNSHIP 35 S., RANGE 6 W., W. M.

North

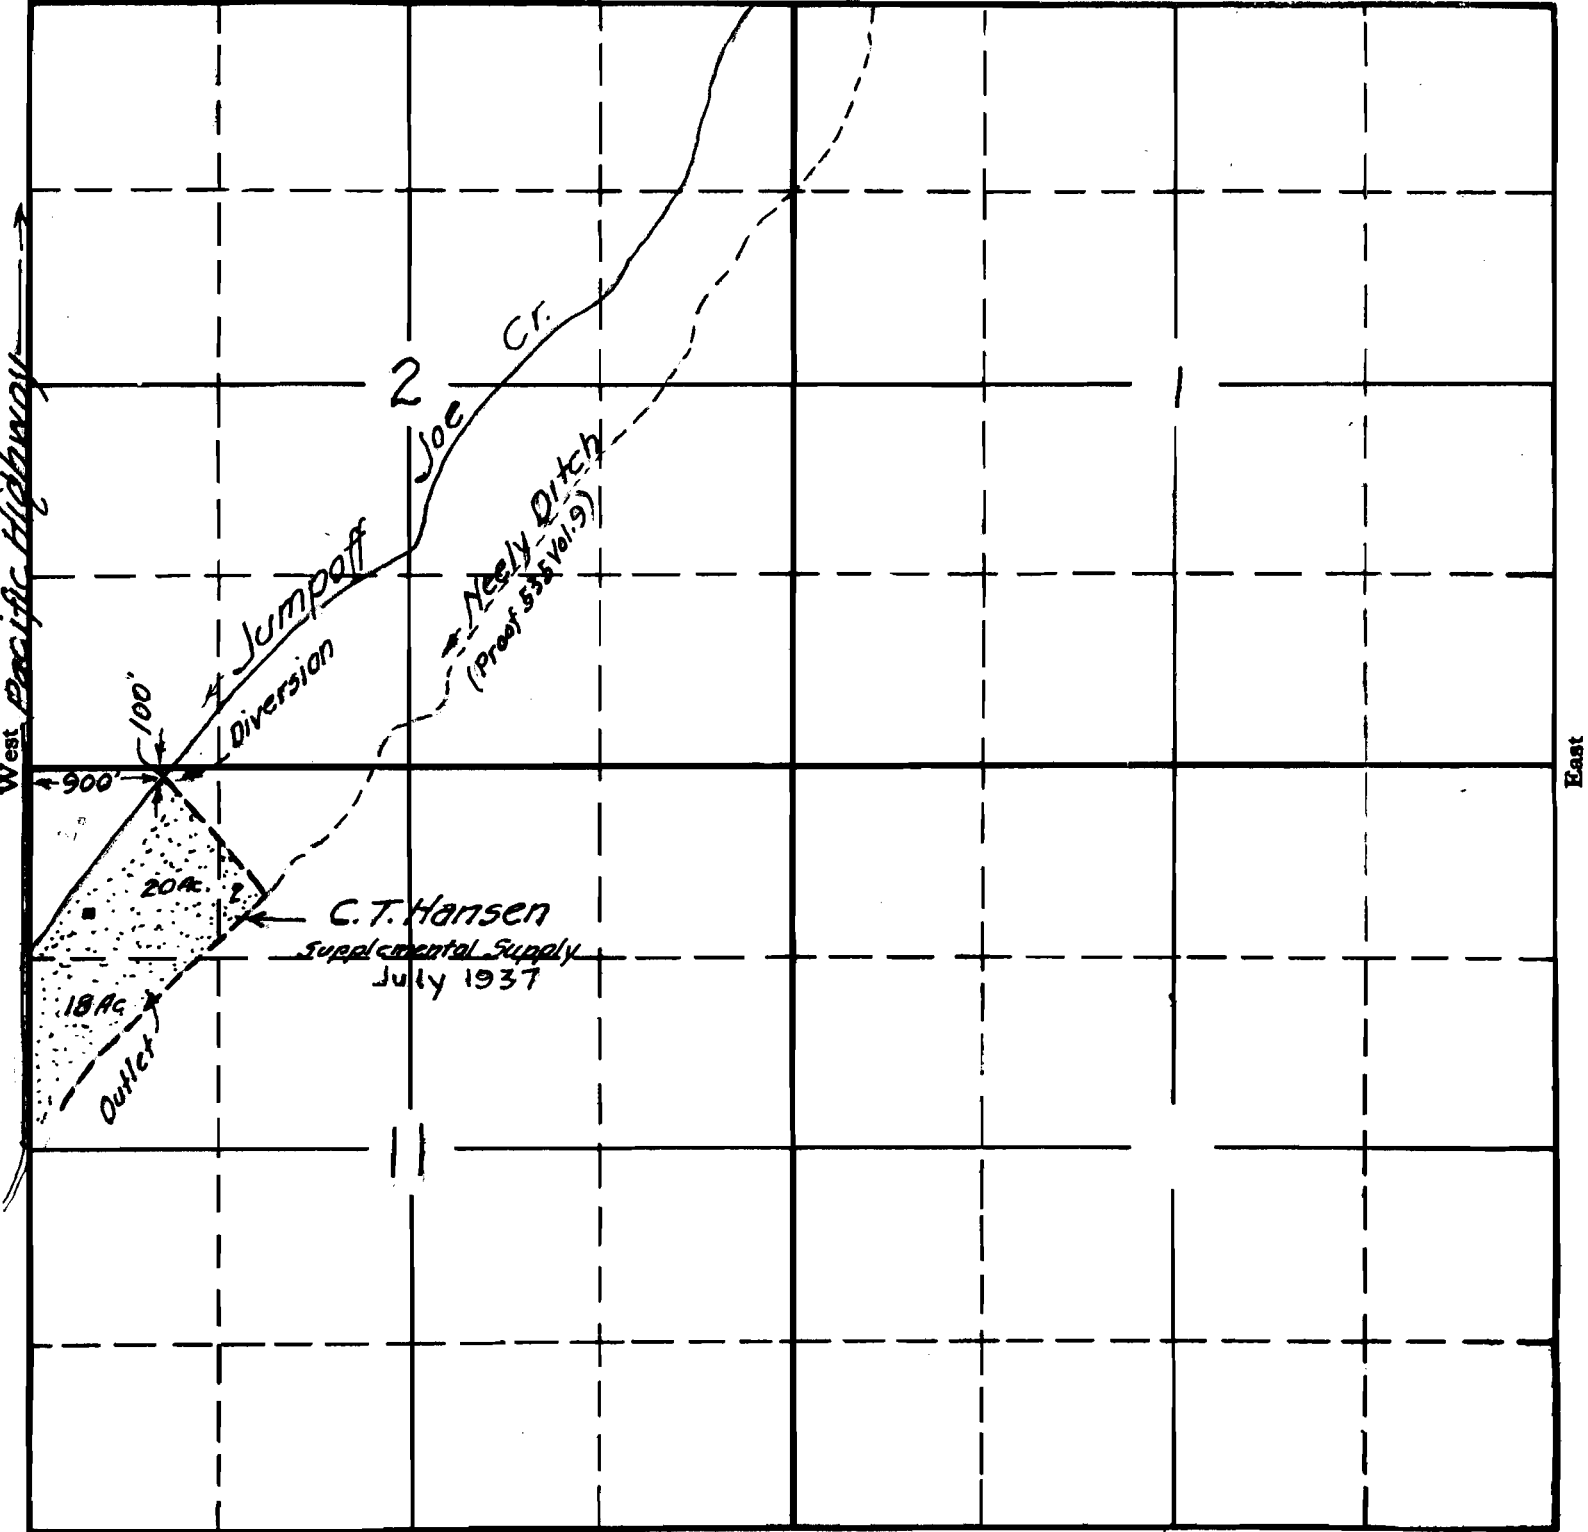

South 15P75

RECEIVED

JUL 6 1937

STATE ENGINEER SALEM, OREGON

RECEIVED

JUL 27 1937

STATE ENGINEER SALEM, OREGON

16767A  
APPLICATION No. 16965  
PERMIT No. 12719