


SECTION

TOWNSHIP 29 S, RANGE 4 W, W. M.

North

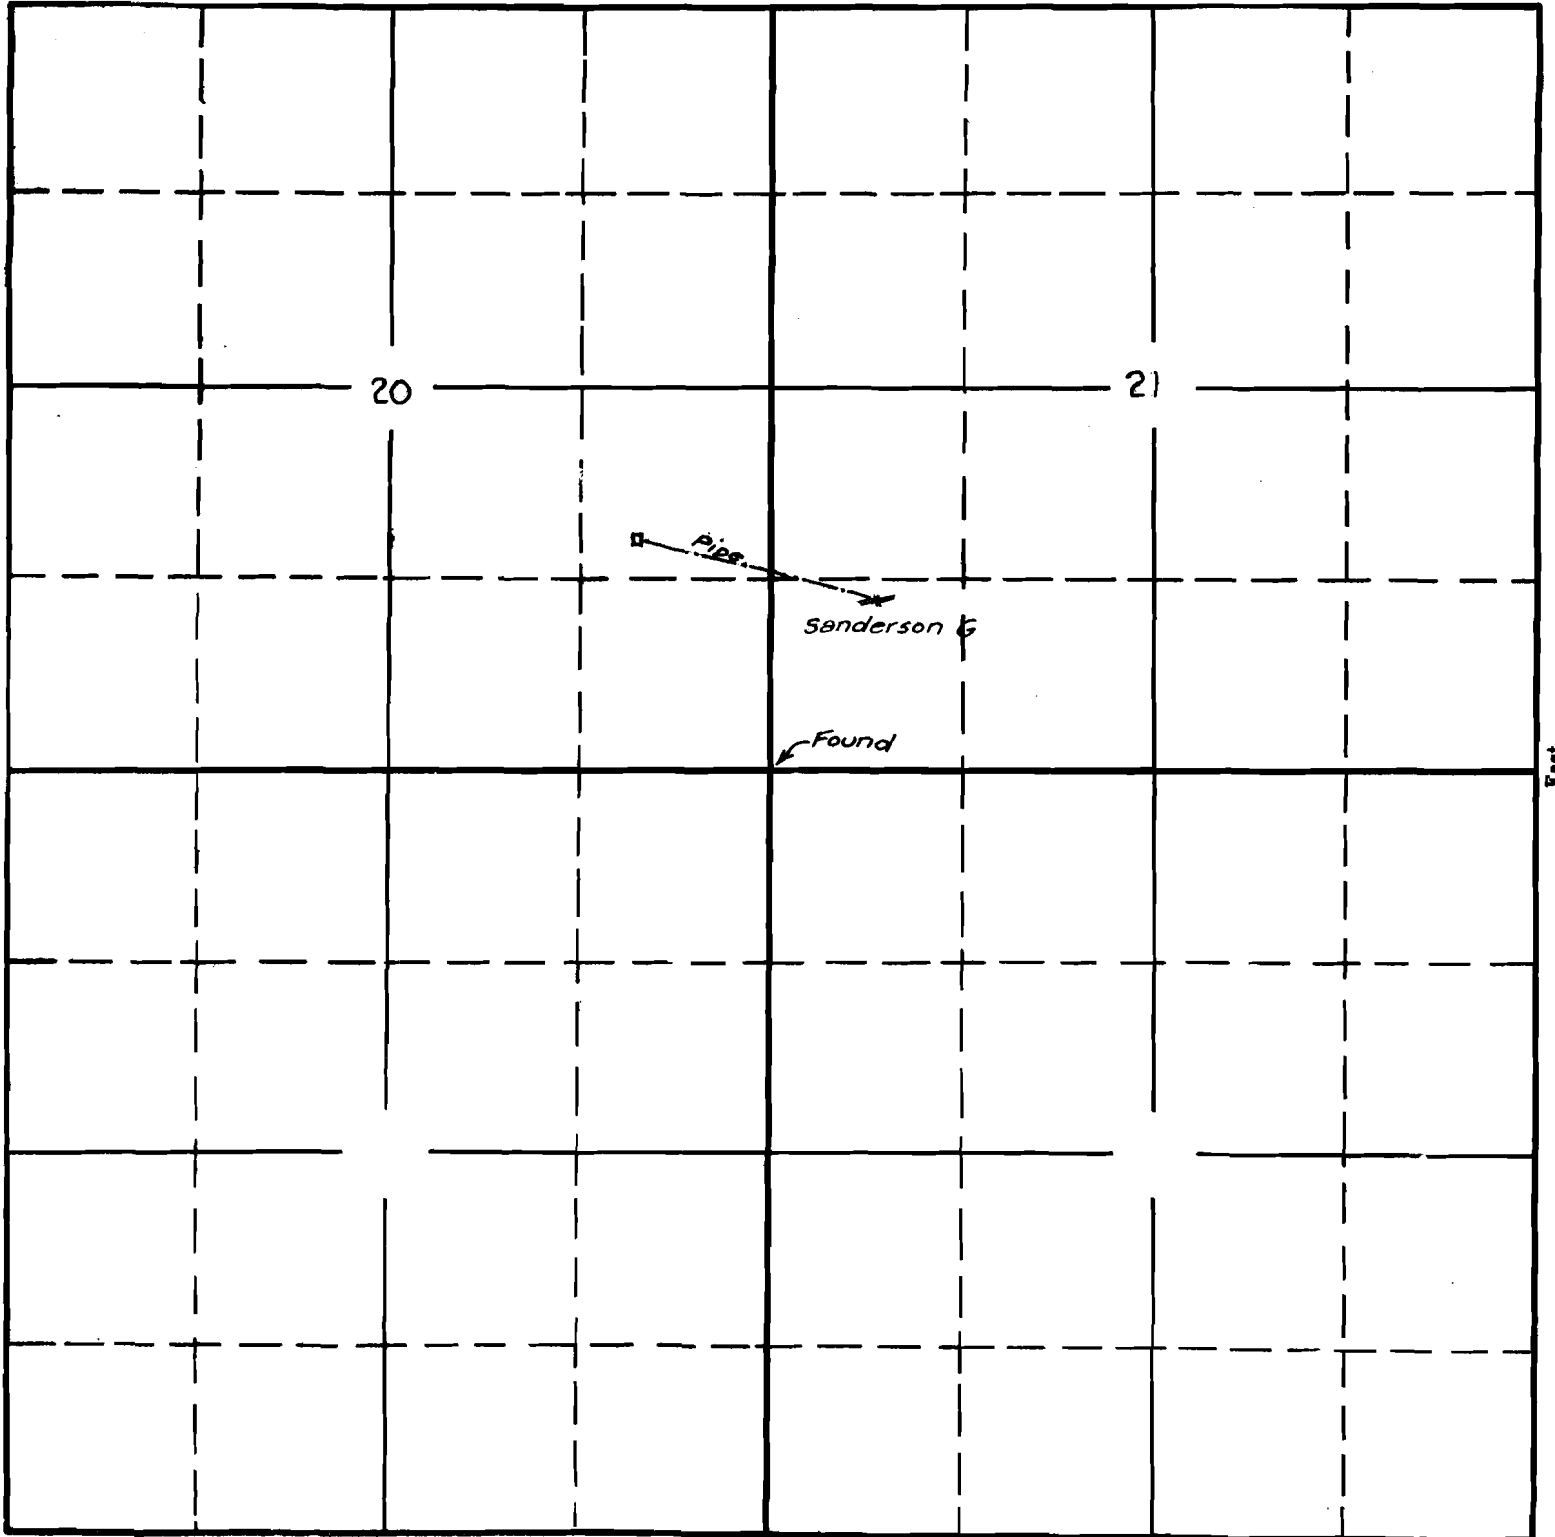

South


APPLICATION No. 16986

PERMIT No. 12735

SECTION

TOWNSHIP 29 S, RANGE 4 W, W. M.

North

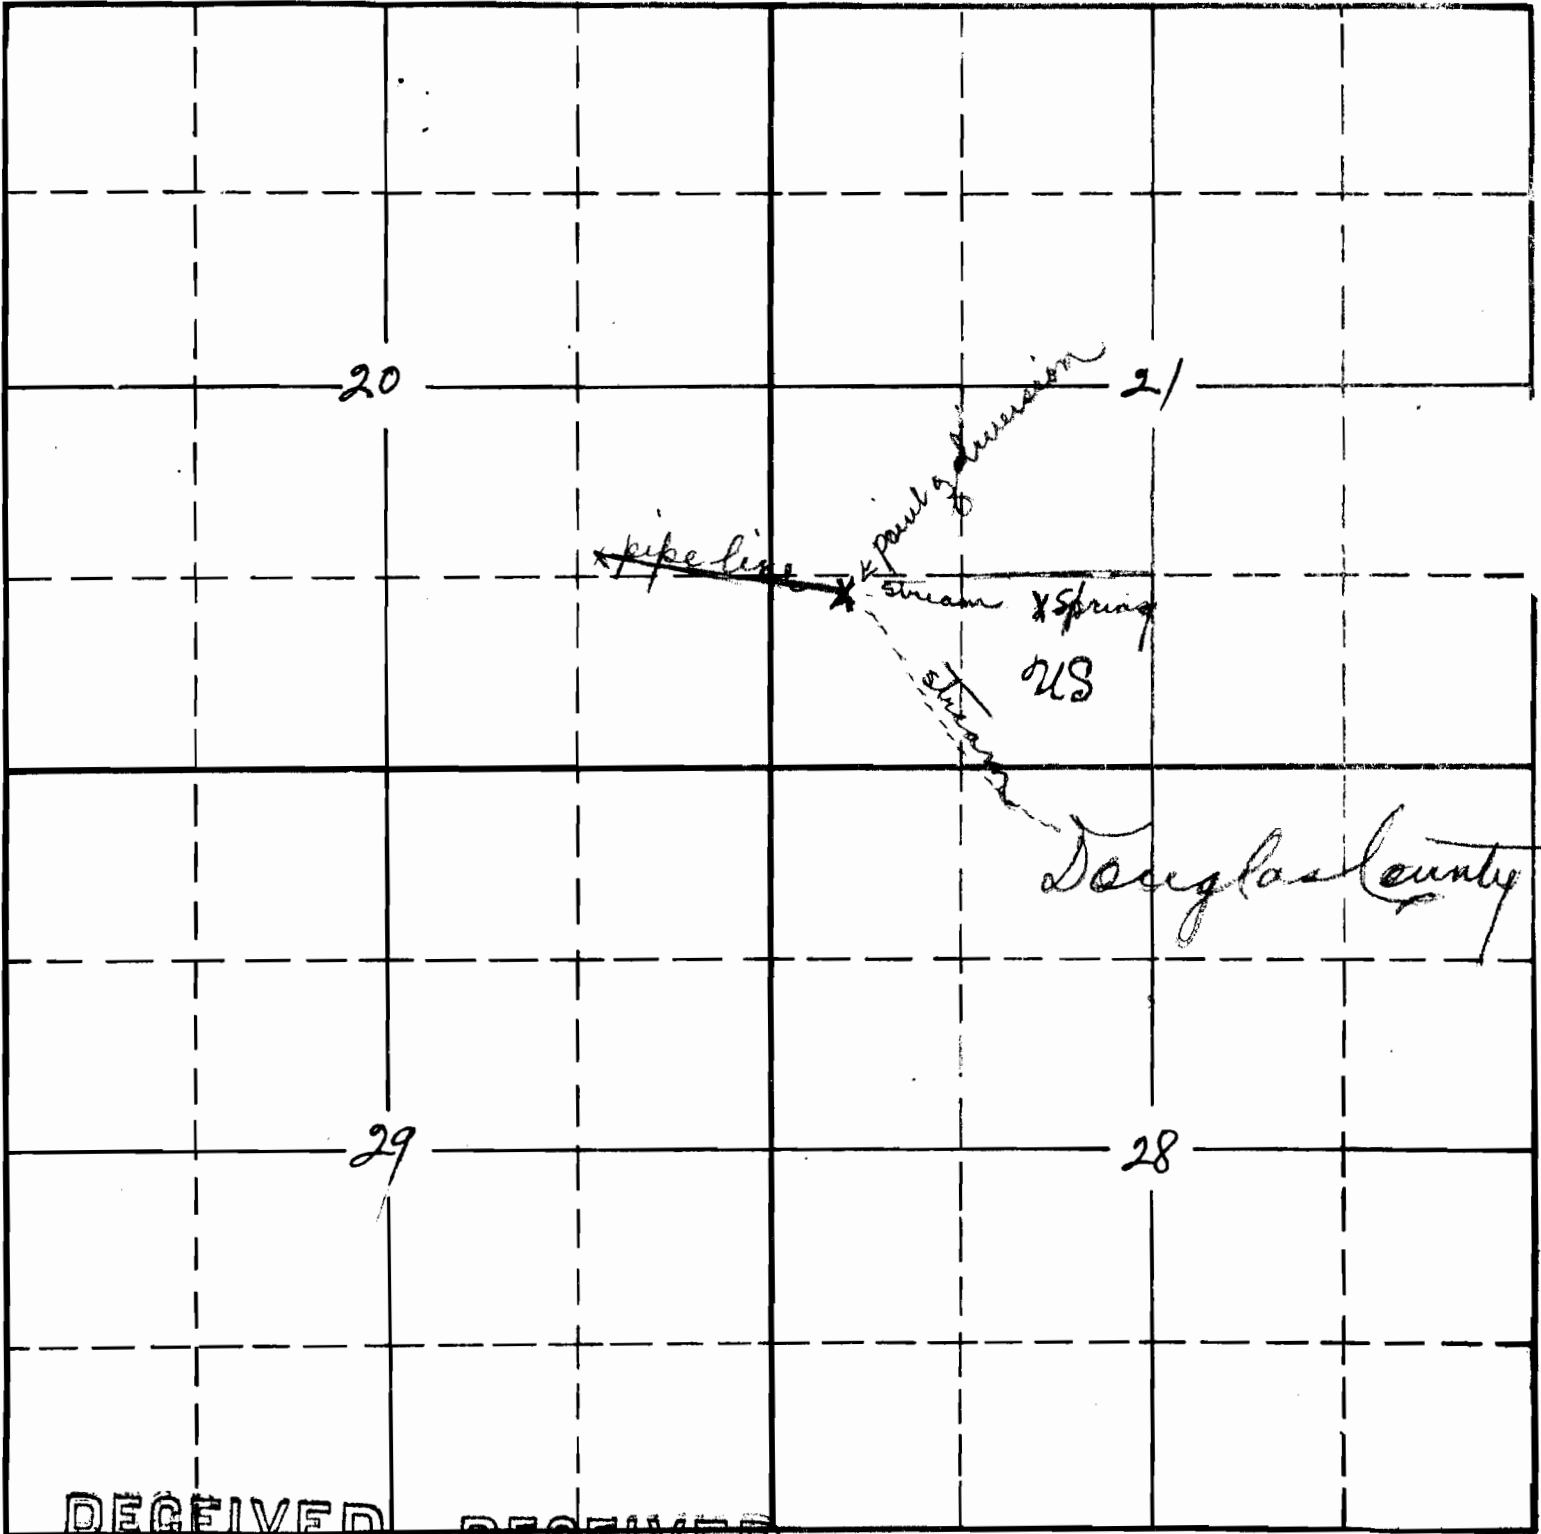

West

East

RECEIVED

JUL 17 1937
STATE ENGINEER
SALEM, OREGON

RECEIVED

JUL 24 1937
STATE ENGINEER
SALEM, OREGON

South

16-p35

16986 OK

APPLICATION No. 16986

PERMIT No. 12735