


SECTION

TOWNSHIP 2S, RANGE 3E, W. M.

North

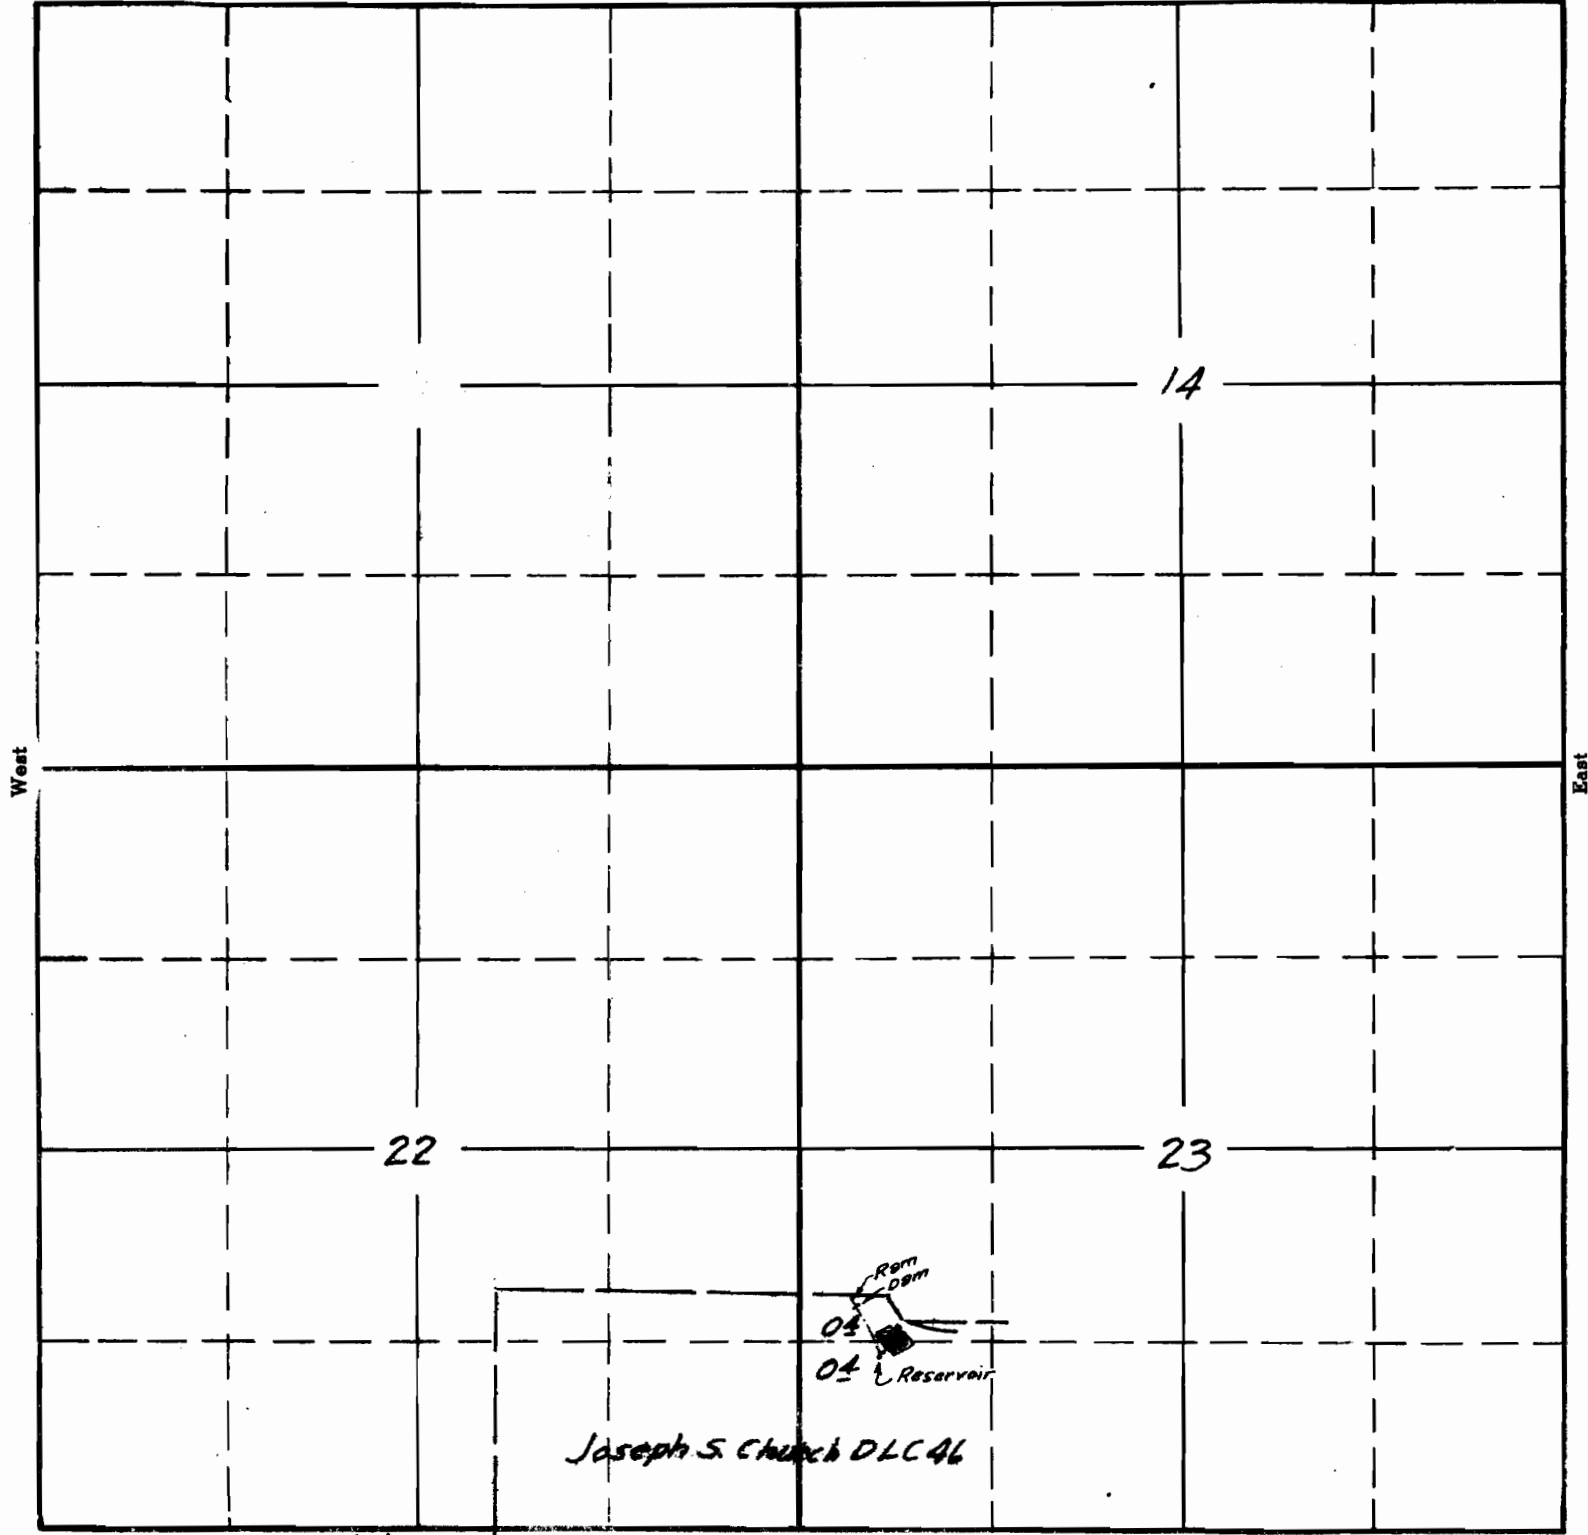

Surveyed June 17, 1940 CAC

South

APPLICATION No. 17020

PERMIT No. 12750

SECTION

\_\_\_\_\_  
\_\_\_\_\_  
\_\_\_\_\_  
\_\_\_\_\_

TOWNSHIP 25 , RANGE 3 E , W. M.

North

West


East

15

14

22

23

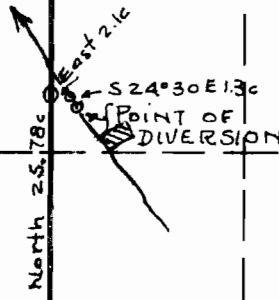

South

APPLICATION No. 17020  
PERMIT No. 12750