


TOWNSHIP 39 S, RANGE 5 W., W. M.

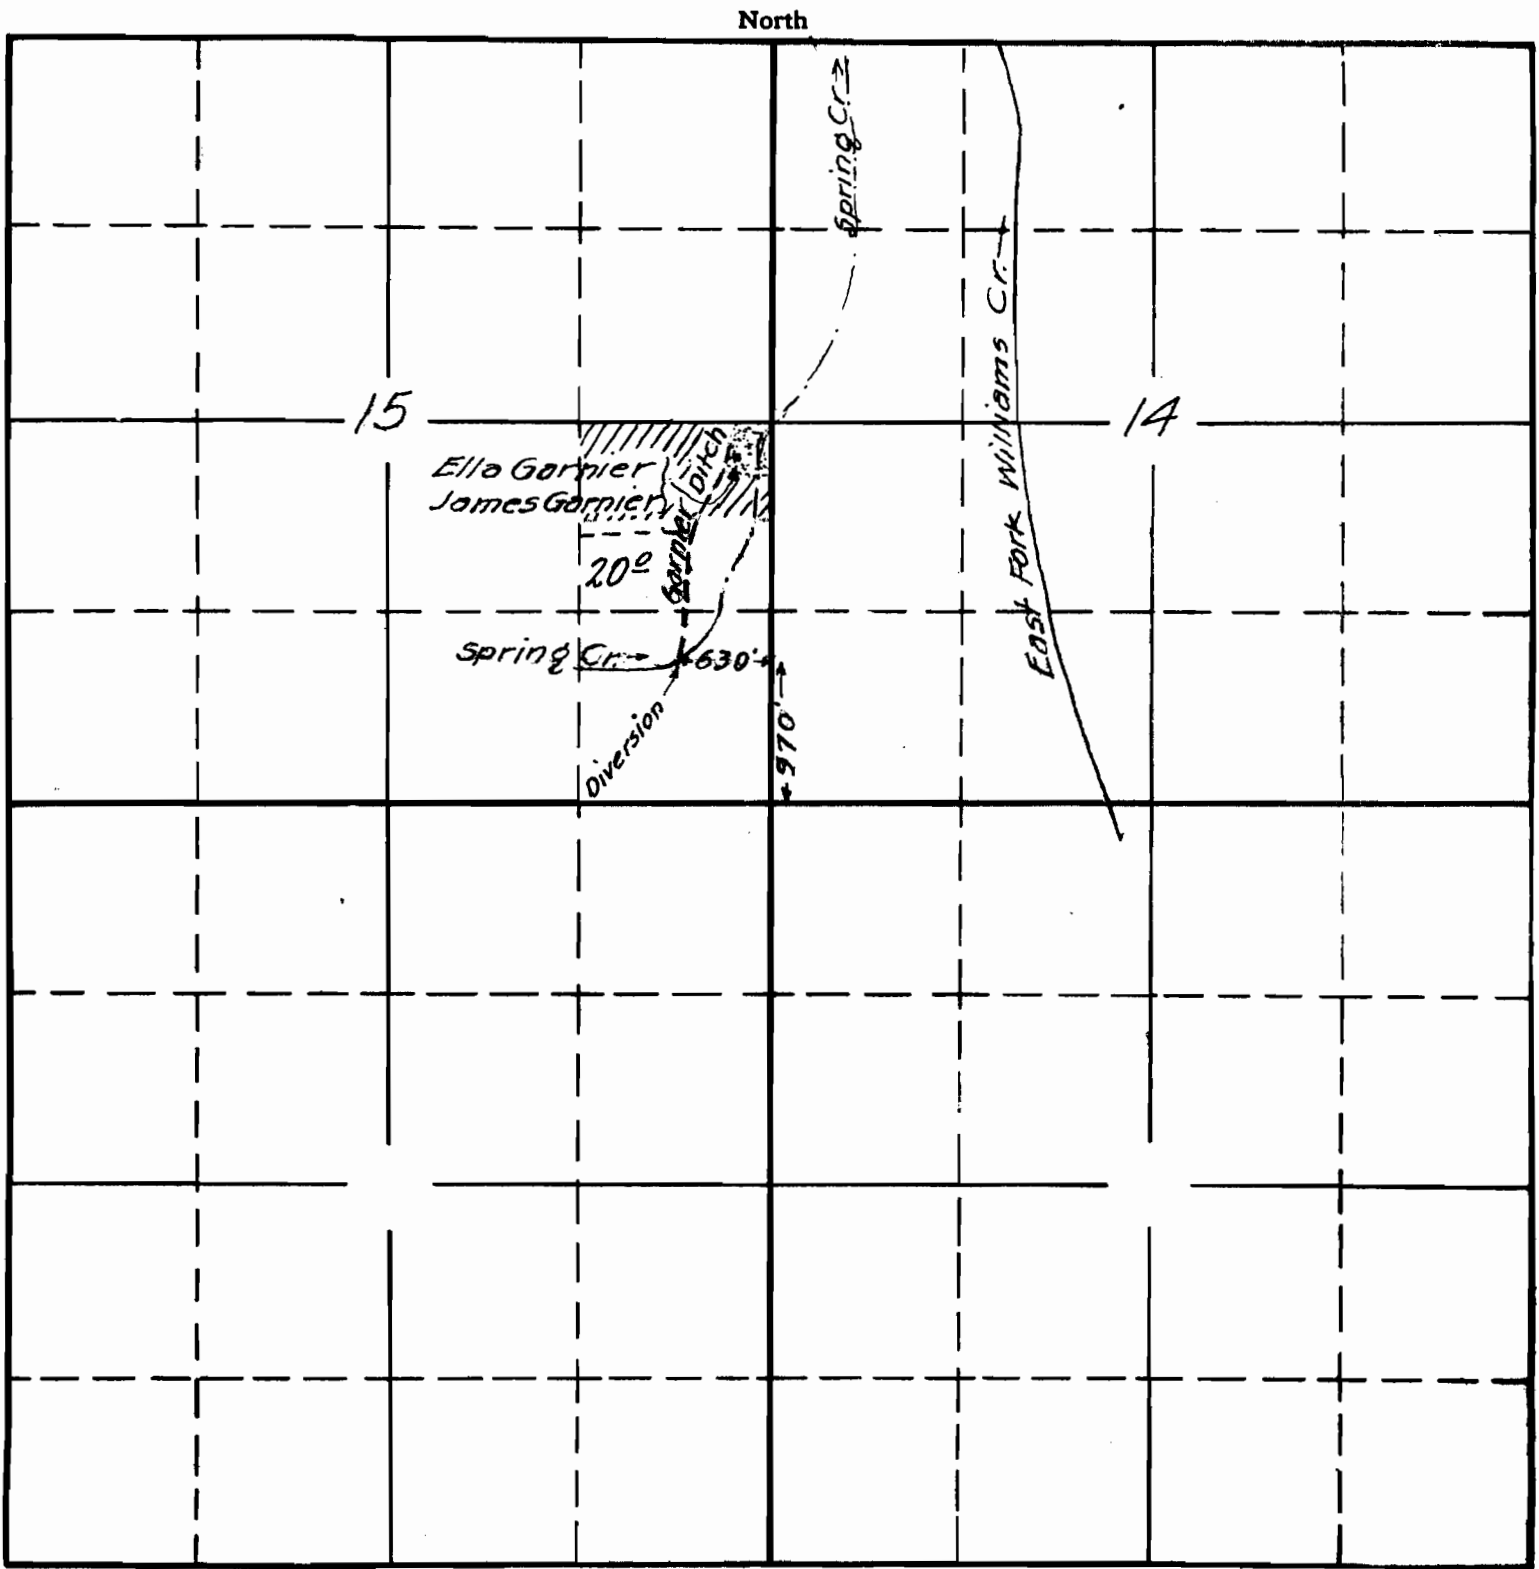

RECEIVED  
8:00 AM  
AUG 9 1937  
STATE ENGINEER  
SALEM, OREGON

South  
Aug 1937

15 P

17024  
APPLICATION No. 17024  
PERMIT No. 12773