


SECTION

22

TOWNSHIP 7 S., RANGE 3 W., W. M.

North

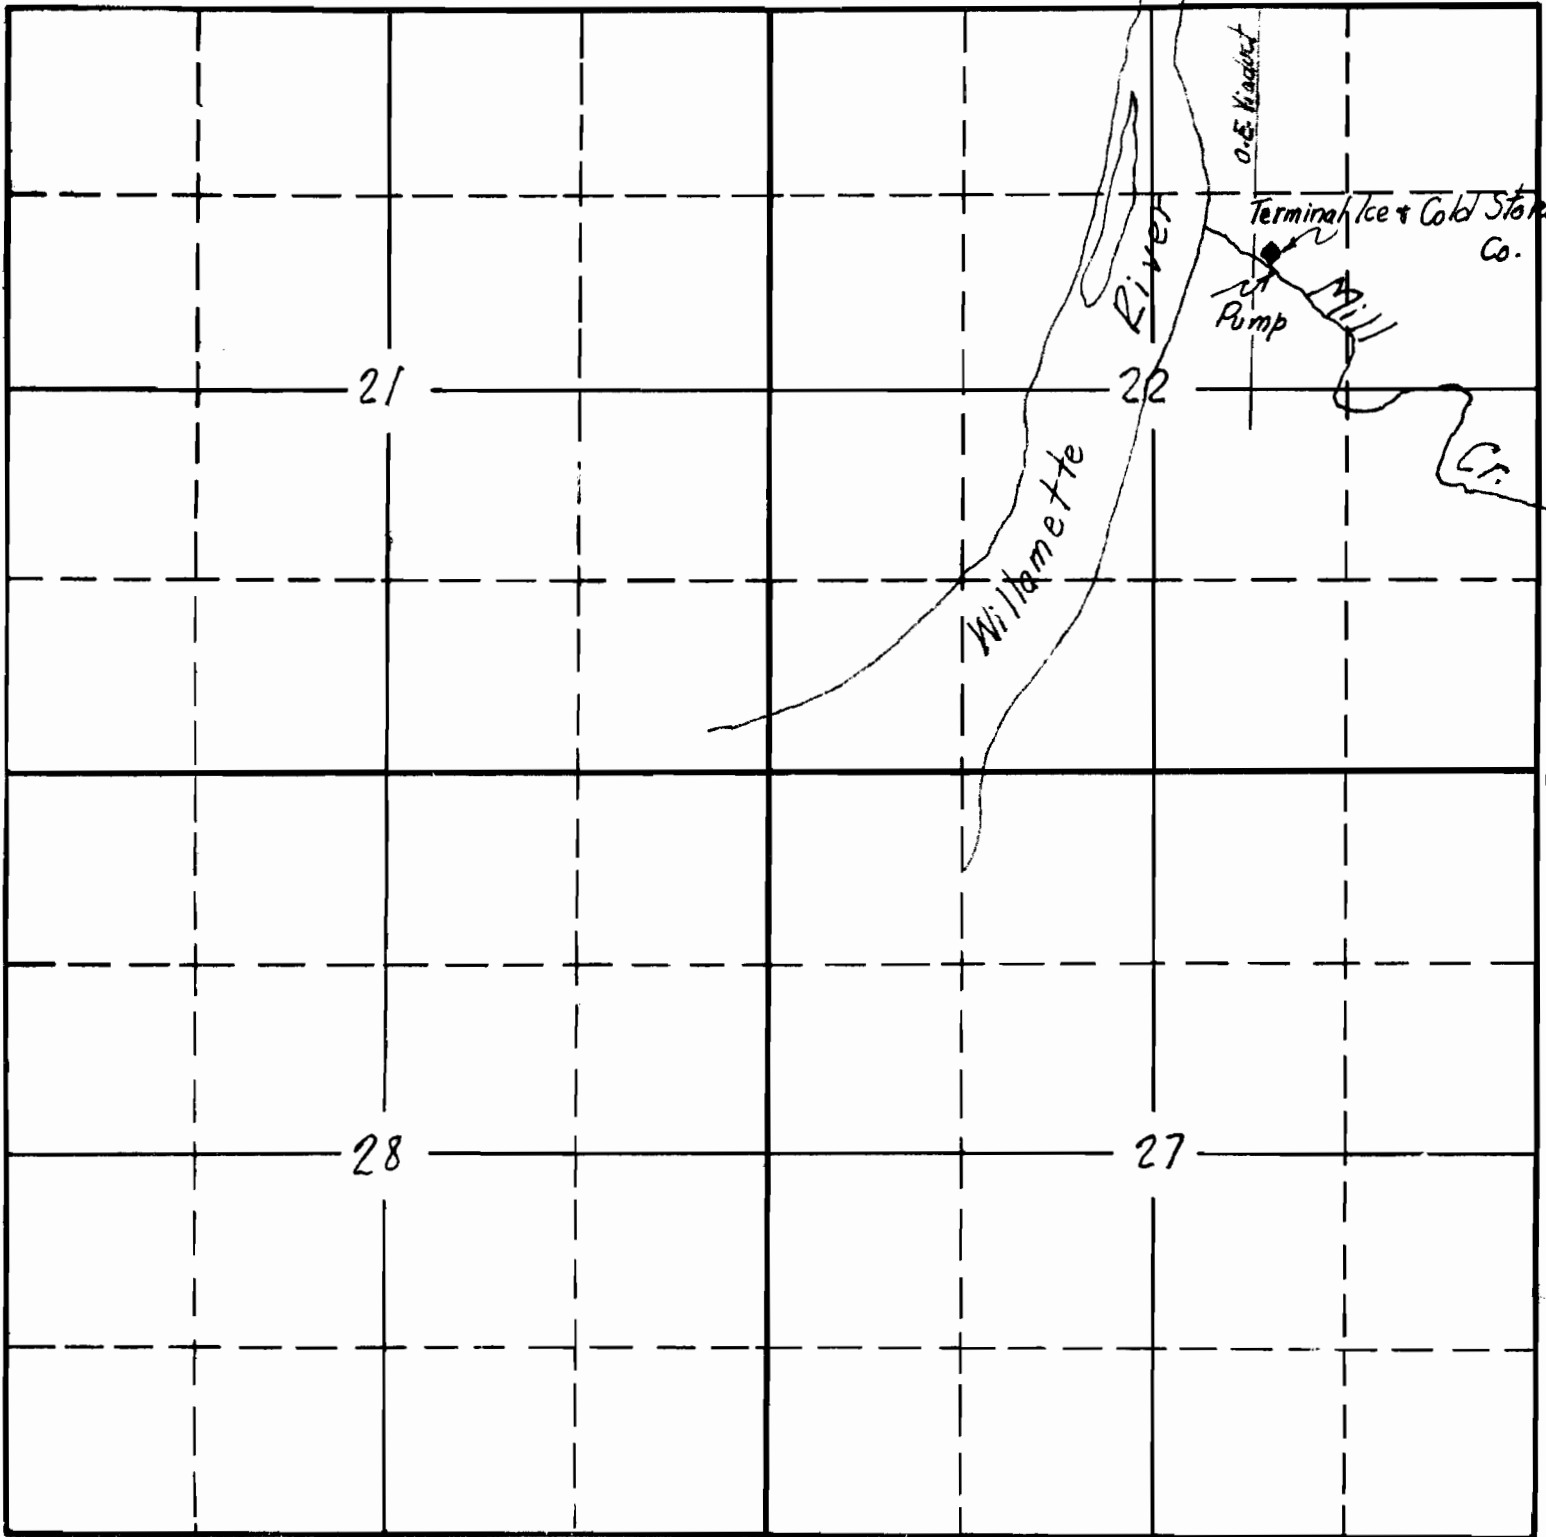

South

EP 76 C

APPLICATION No. 17035


PERMIT No. 12782

SECTION

\_\_\_\_\_  
\_\_\_\_\_  
\_\_\_\_\_  
\_\_\_\_\_

TOWNSHIP 7S, RANGE 3W, W. M.

North

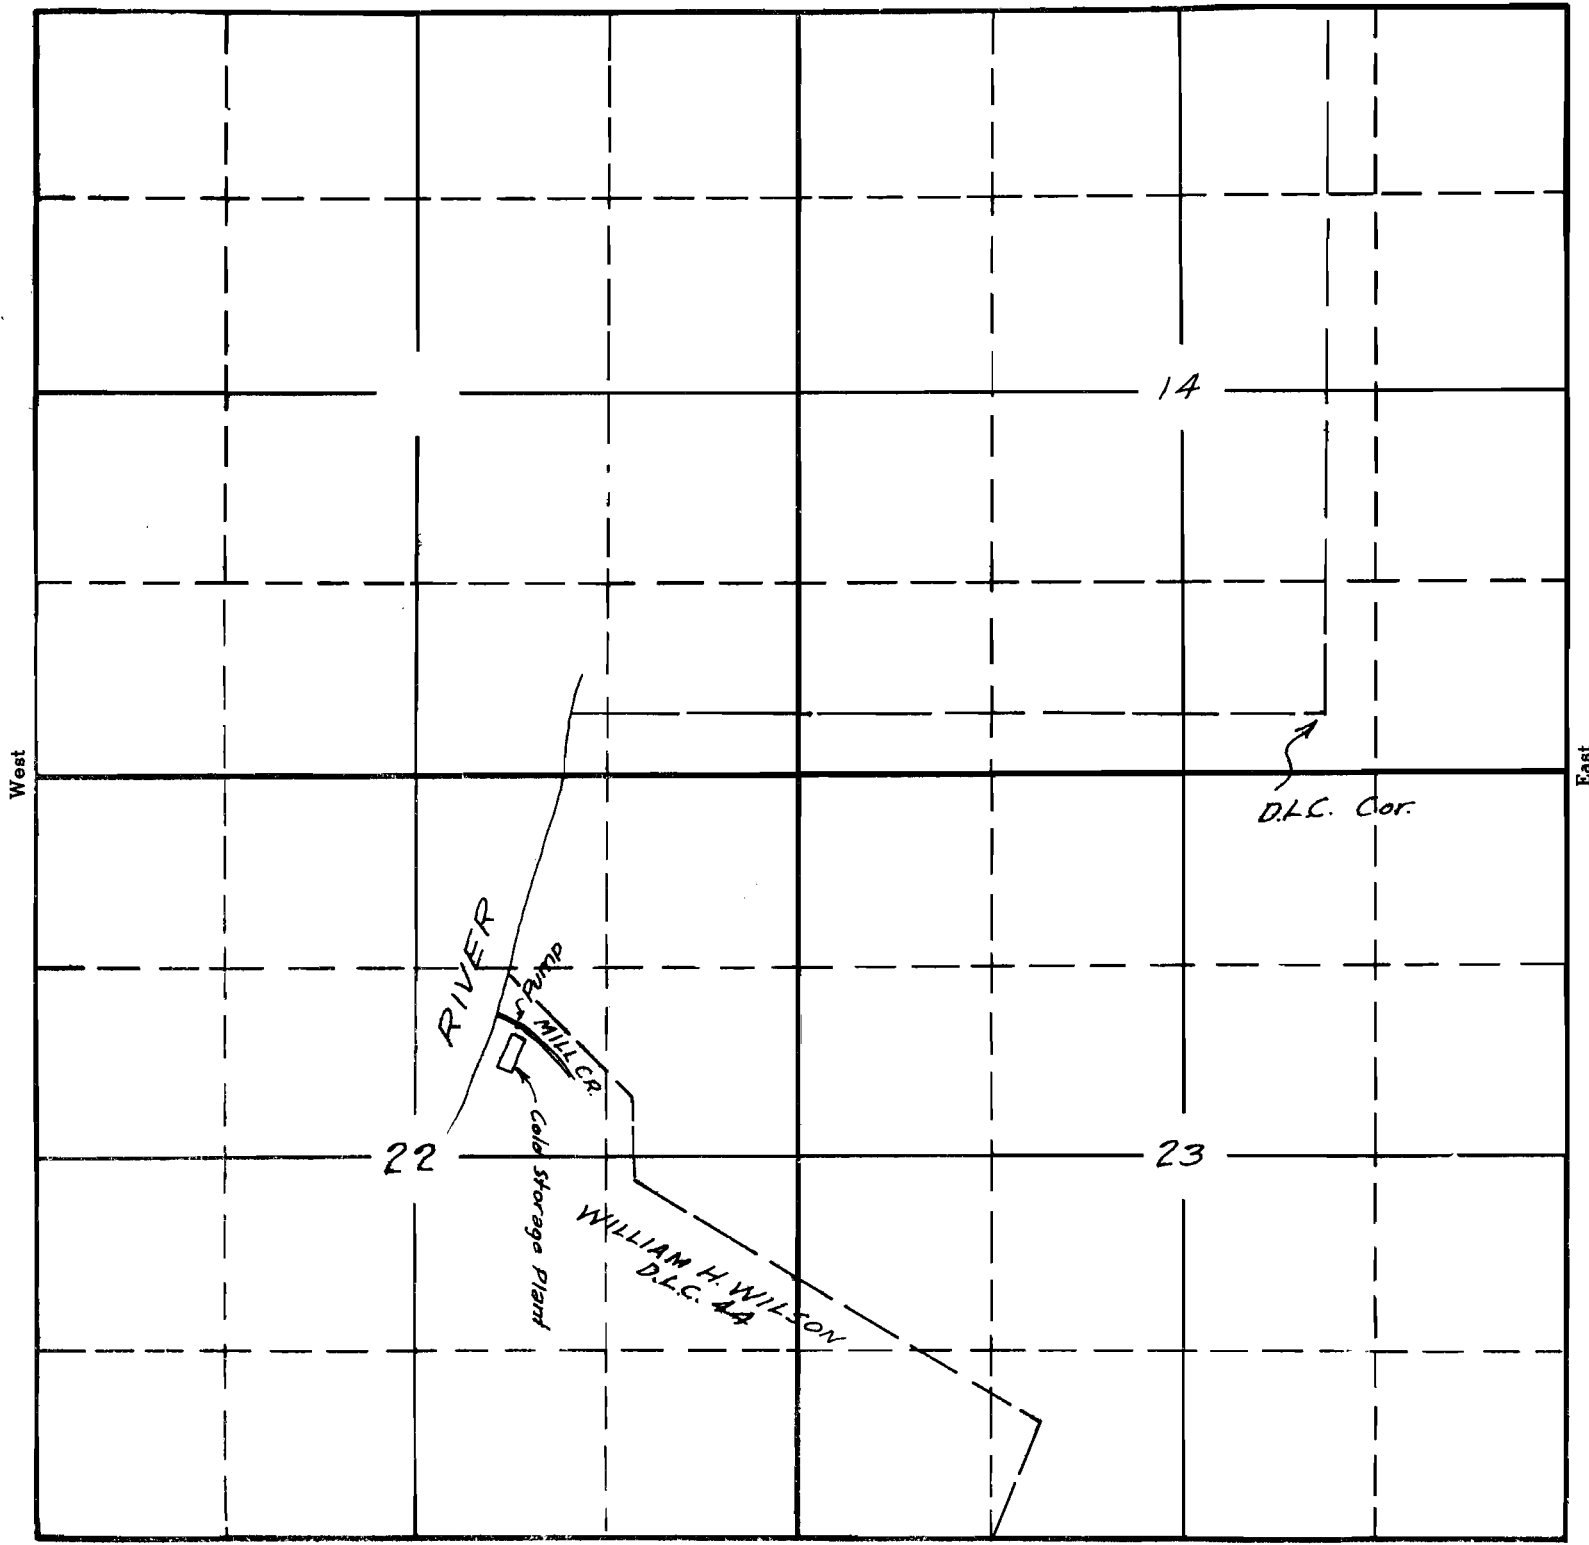

South

APPLICATION No. 17035  
PERMIT No. 12782