

SECTION

\_\_\_\_\_


\_\_\_\_\_

\_\_\_\_\_

\_\_\_\_\_

TOWNSHIP 35, RANGE R40E W. M.

North

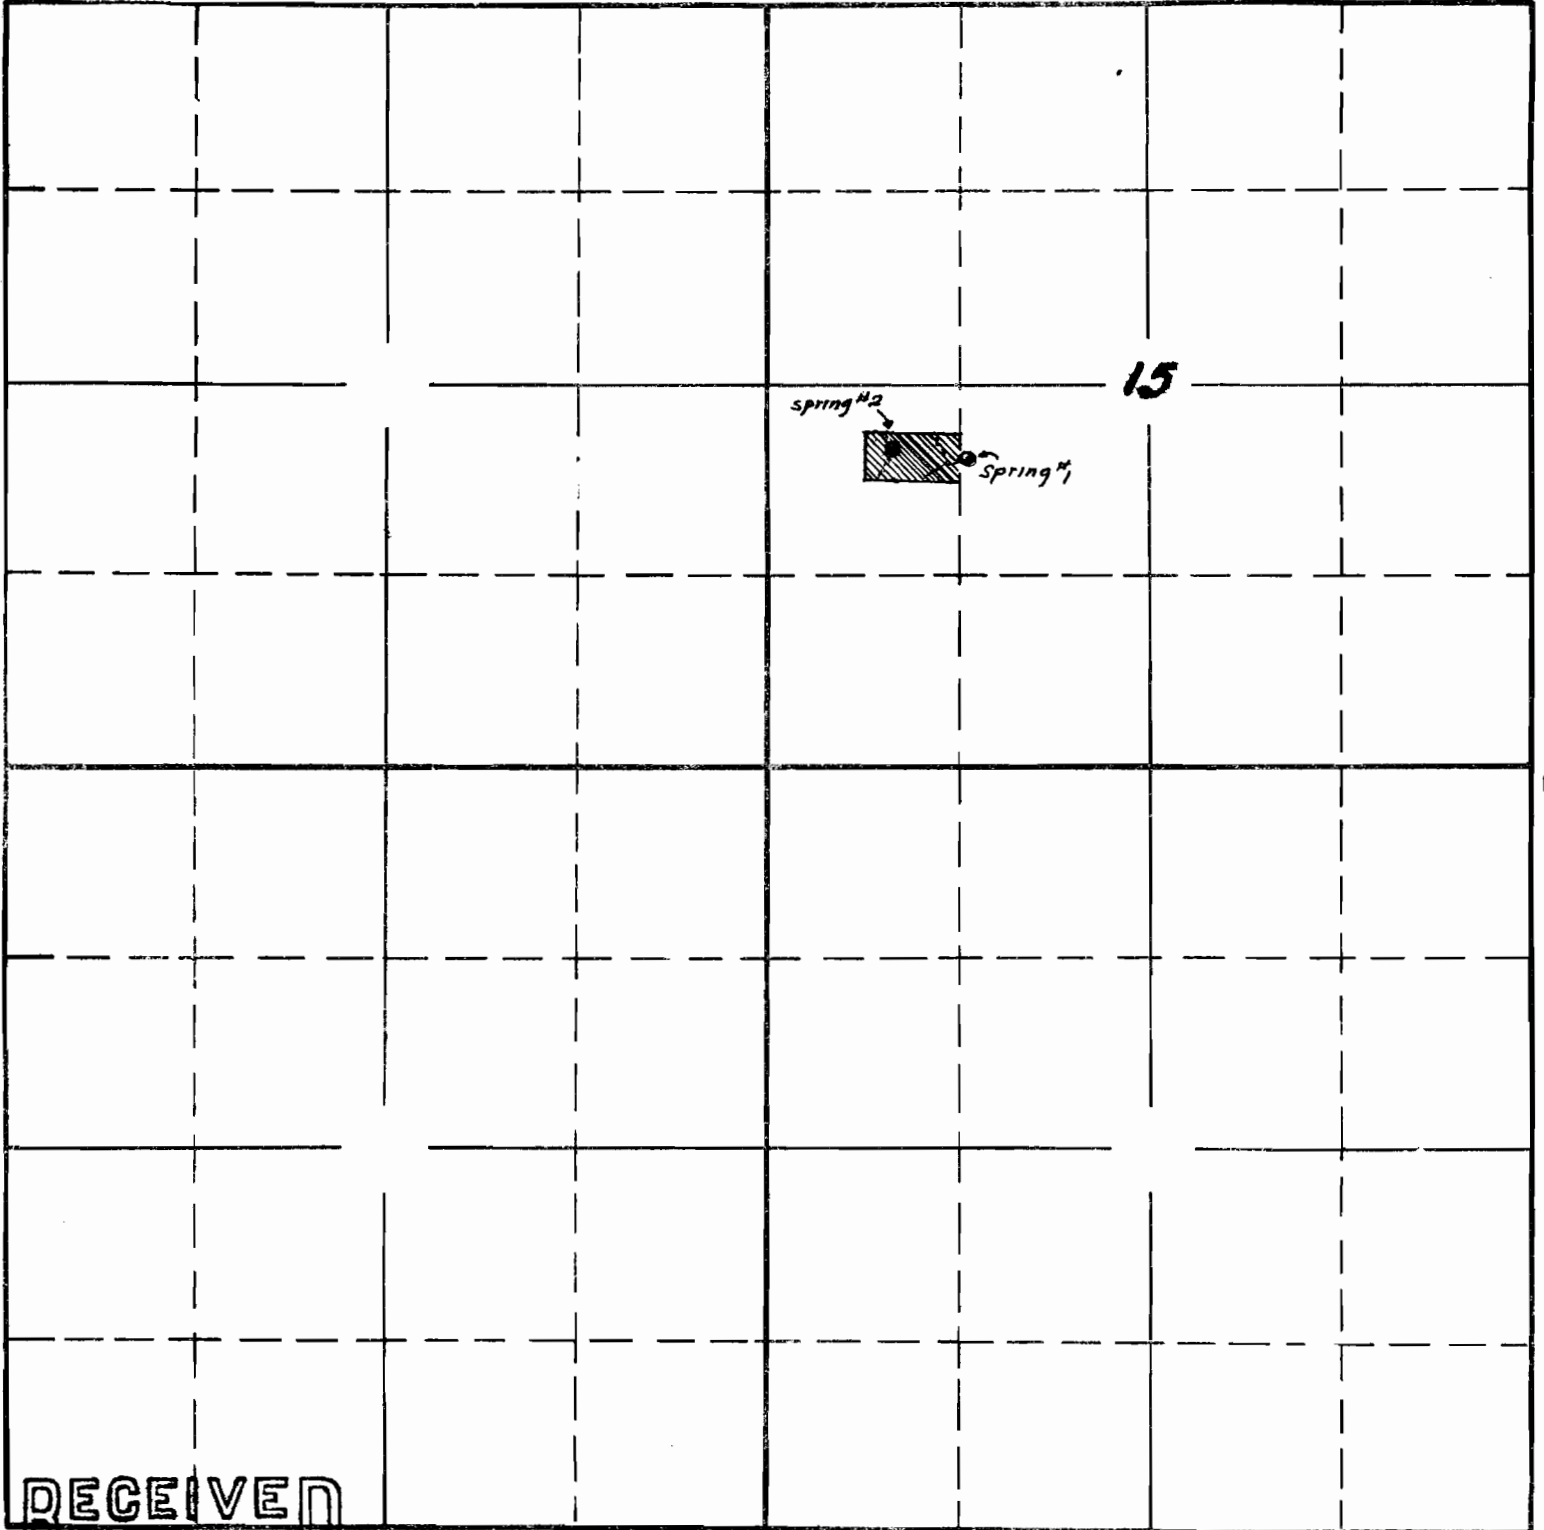

**RECEIVED**

AUG 13 1937

STATE ENGINEER  
SALEM, OREGON

South

8-417

17036 075

APPLICATION No. 17036

PERMIT No. 12783