


SECTION

TOWNSHIP 385, RANGE 3W, W. M.

North

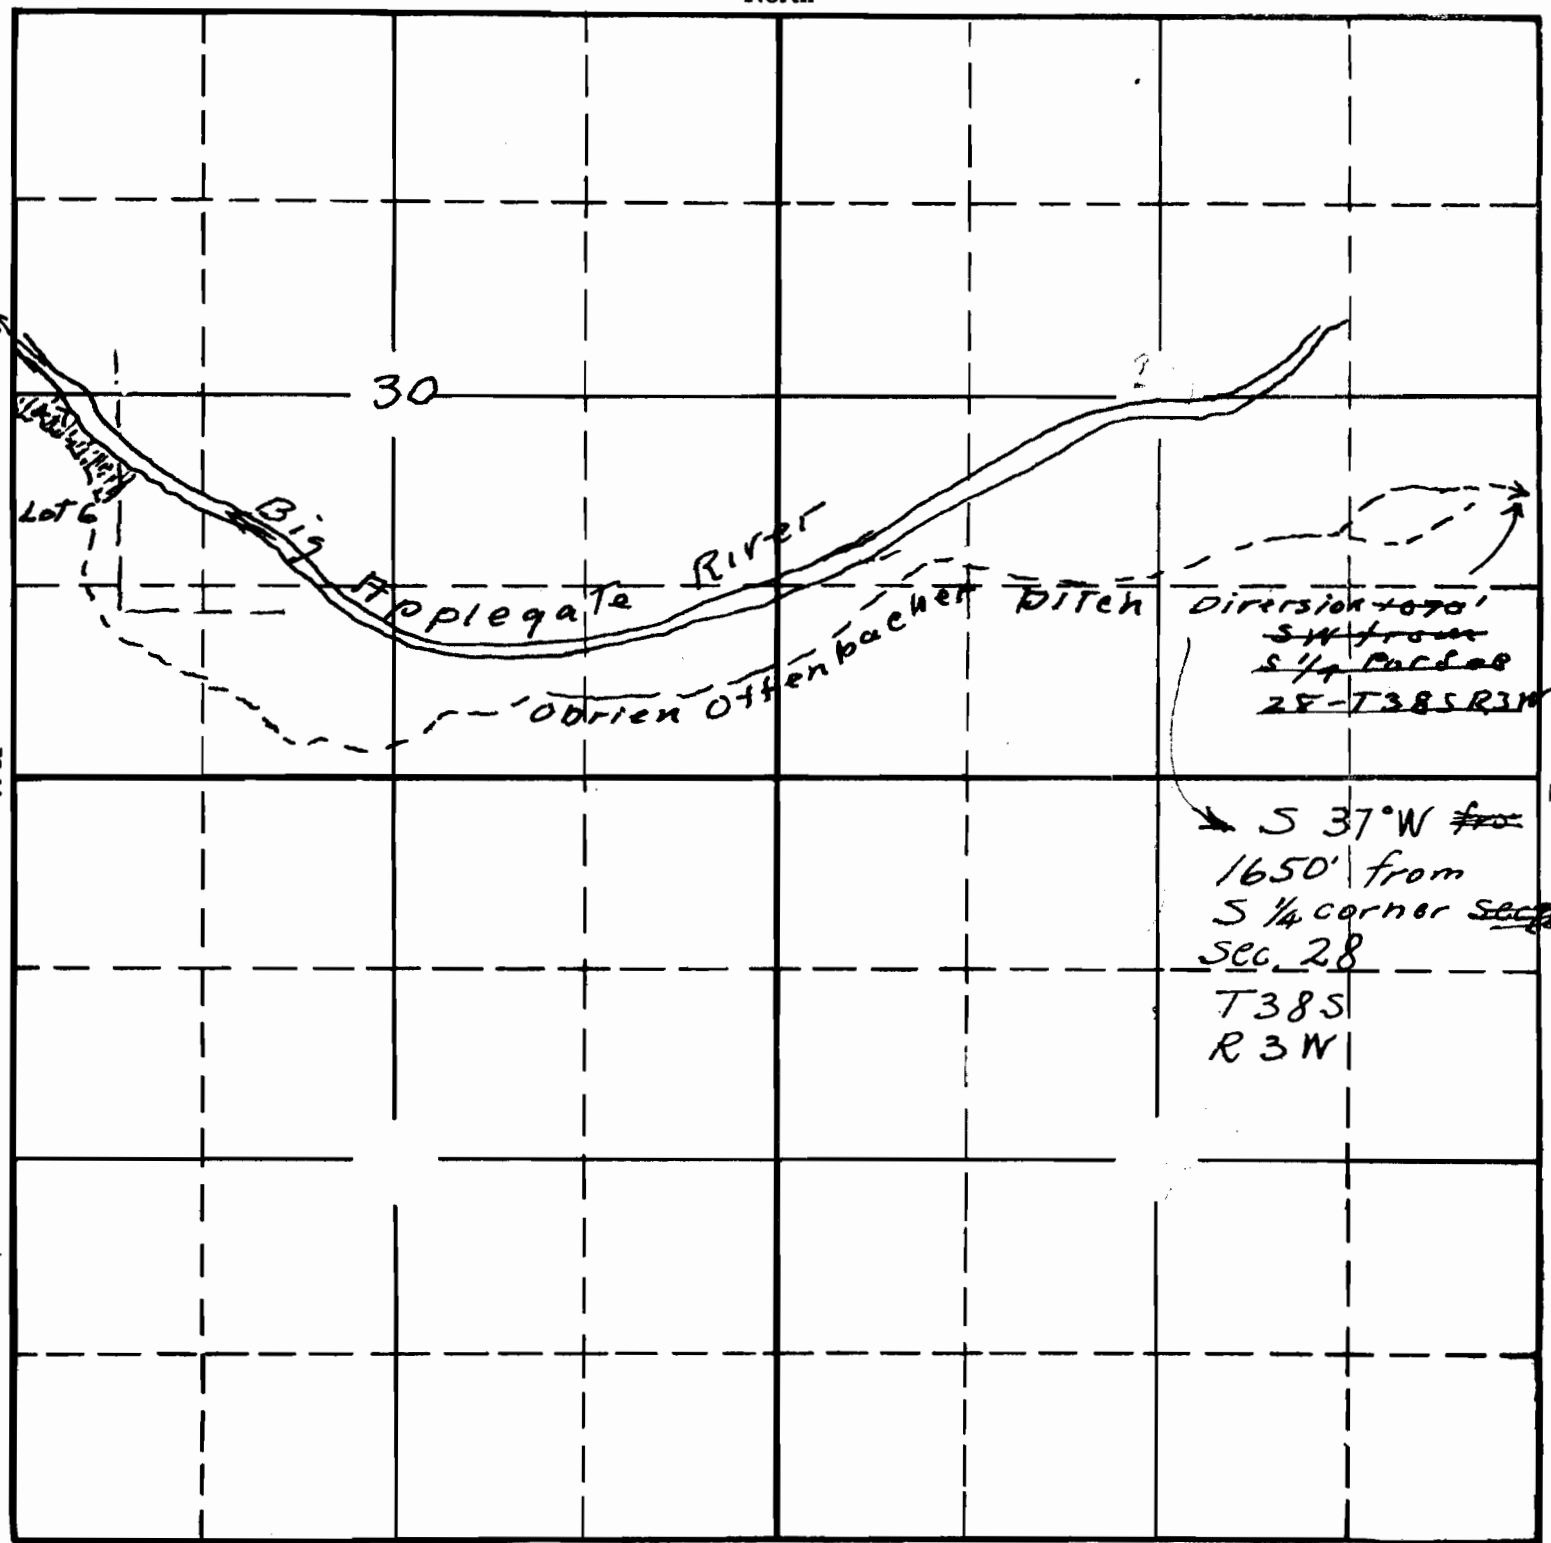

South

RECEIVED
 AUG 17 1937
 STATE ENGINEER
 SALEM, OREGON

APPLICATION No. 17041
 PERMIT No. 12787