


SECTION

TOWNSHIP 15 , RANGE 3E , W. M.

North

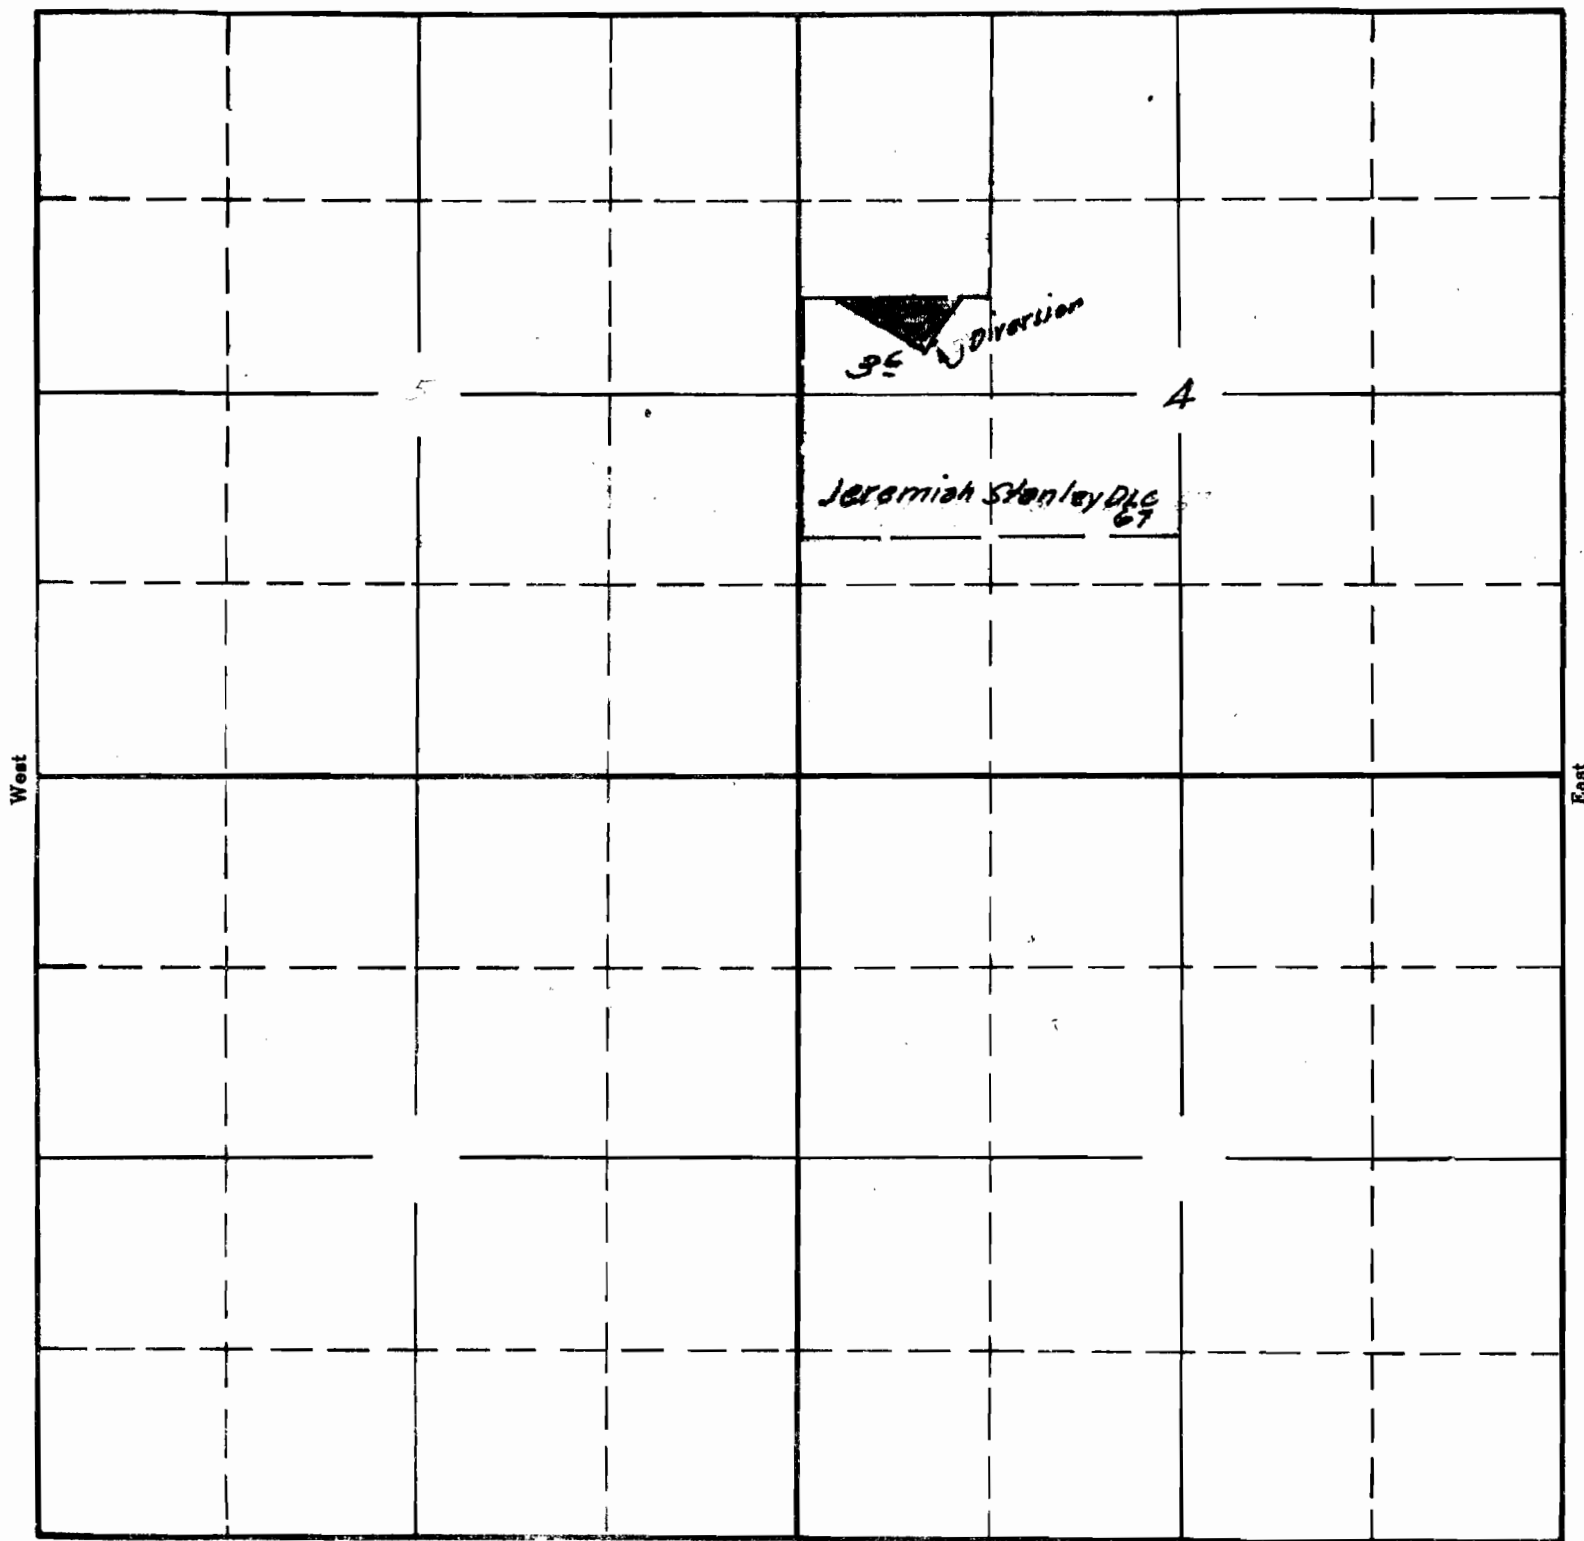

Surveyed June 18, 1940 C.A.B.

South

APPLICATION No. 17042


PERMIT No. 12788

SECTION

4

TOWNSHIP 15, RANGE 3E, W. M.

North

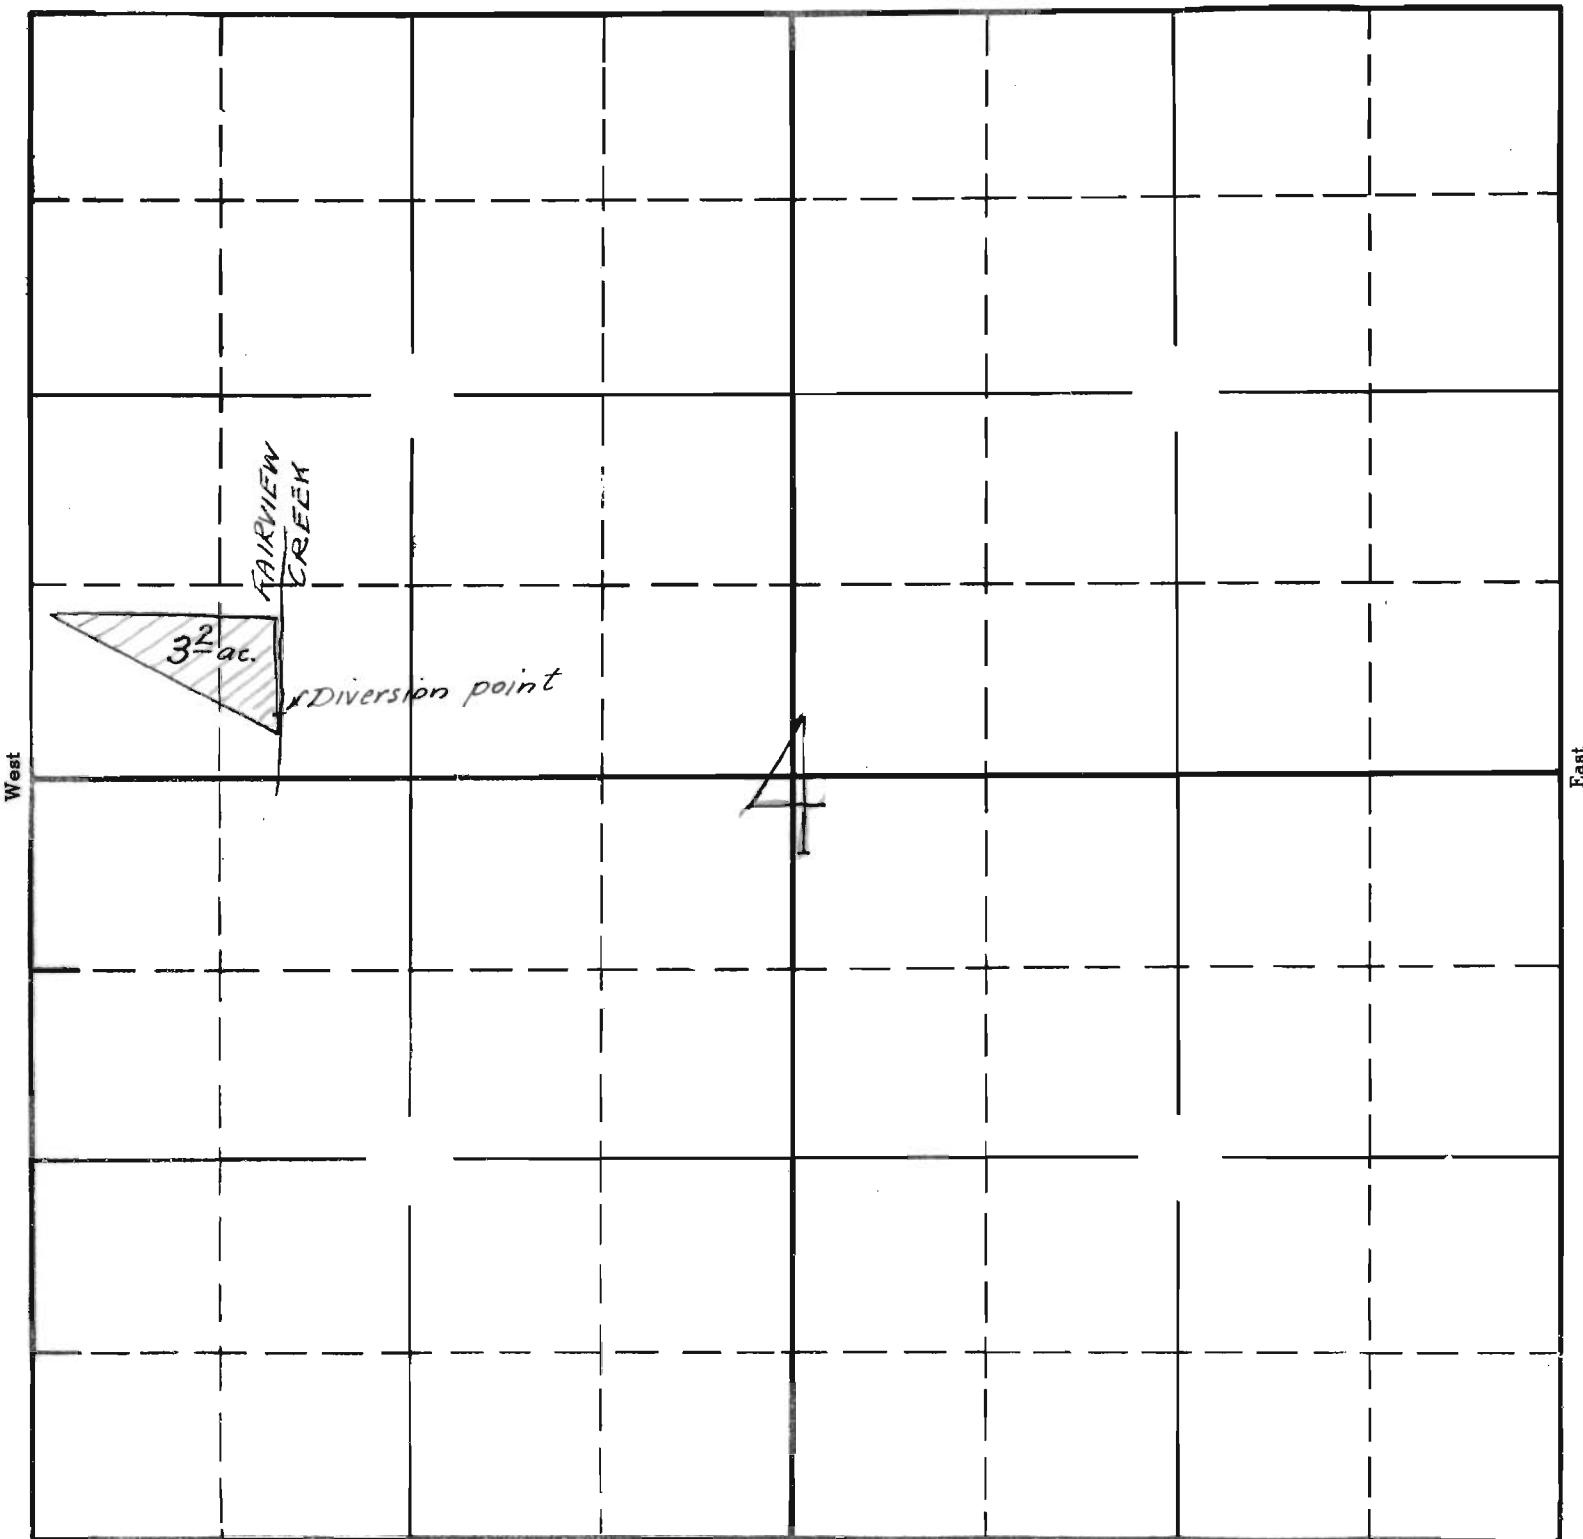

South

Map prepared from information
furnished by applicant, in
office of State Engineer.

APPLICATION No. 17042
PERMIT No. 12788