


TOWNSHIP 39, RANGE 45E, W. M.

North

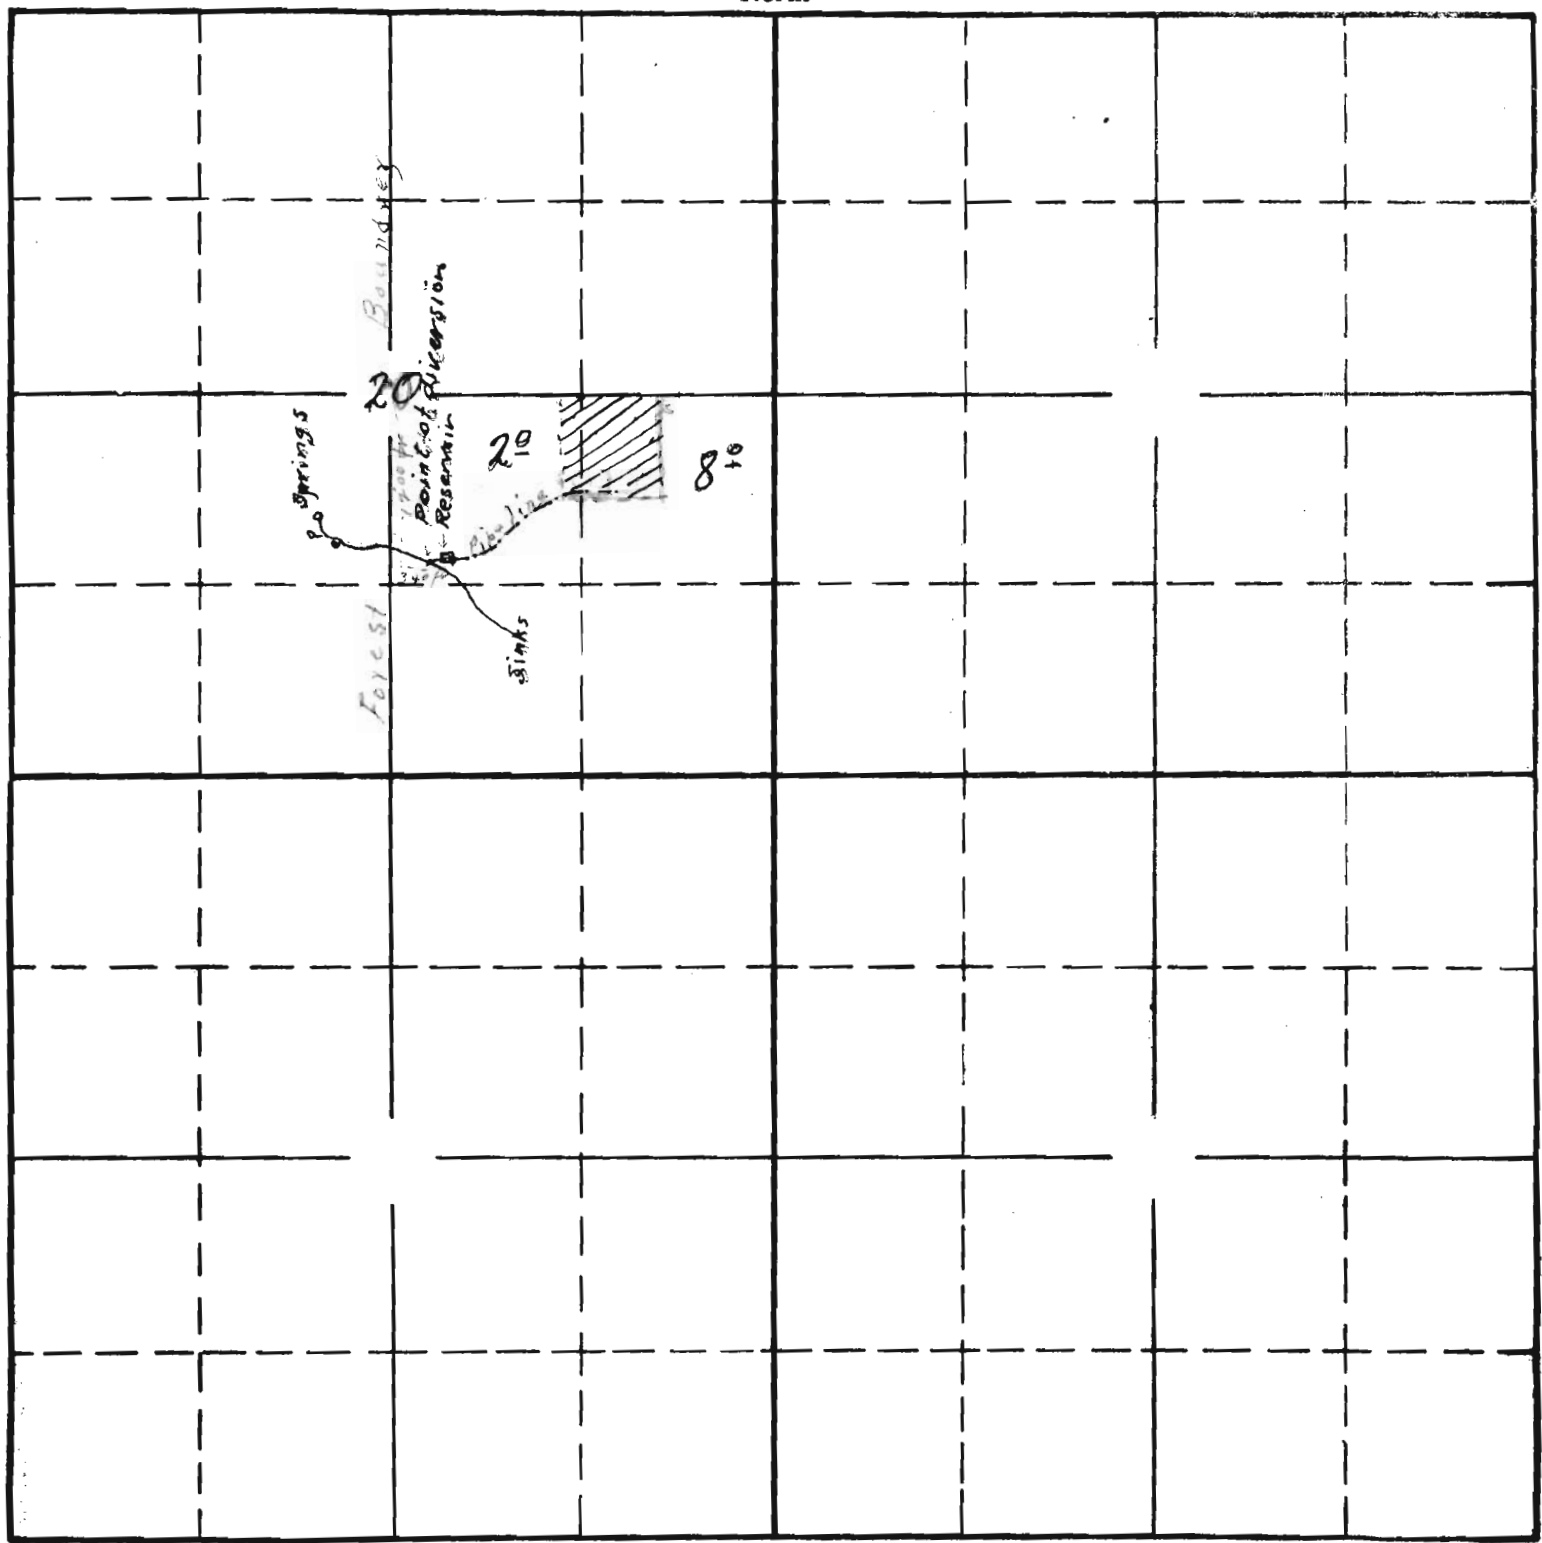

South

8-36

17056 OK

APPLICATION No. 17056  
PERMIT No. 12795

RECEIVED  
AUG 23 1937  
STATE ENGINEER  
SALEM, OREGON

RECEIVED  
SEP 7 1937  
STATE ENGINEER  
SALEM, OREGON