


18

TOWNSHIP 40S, RANGE 3W, W. M.

North

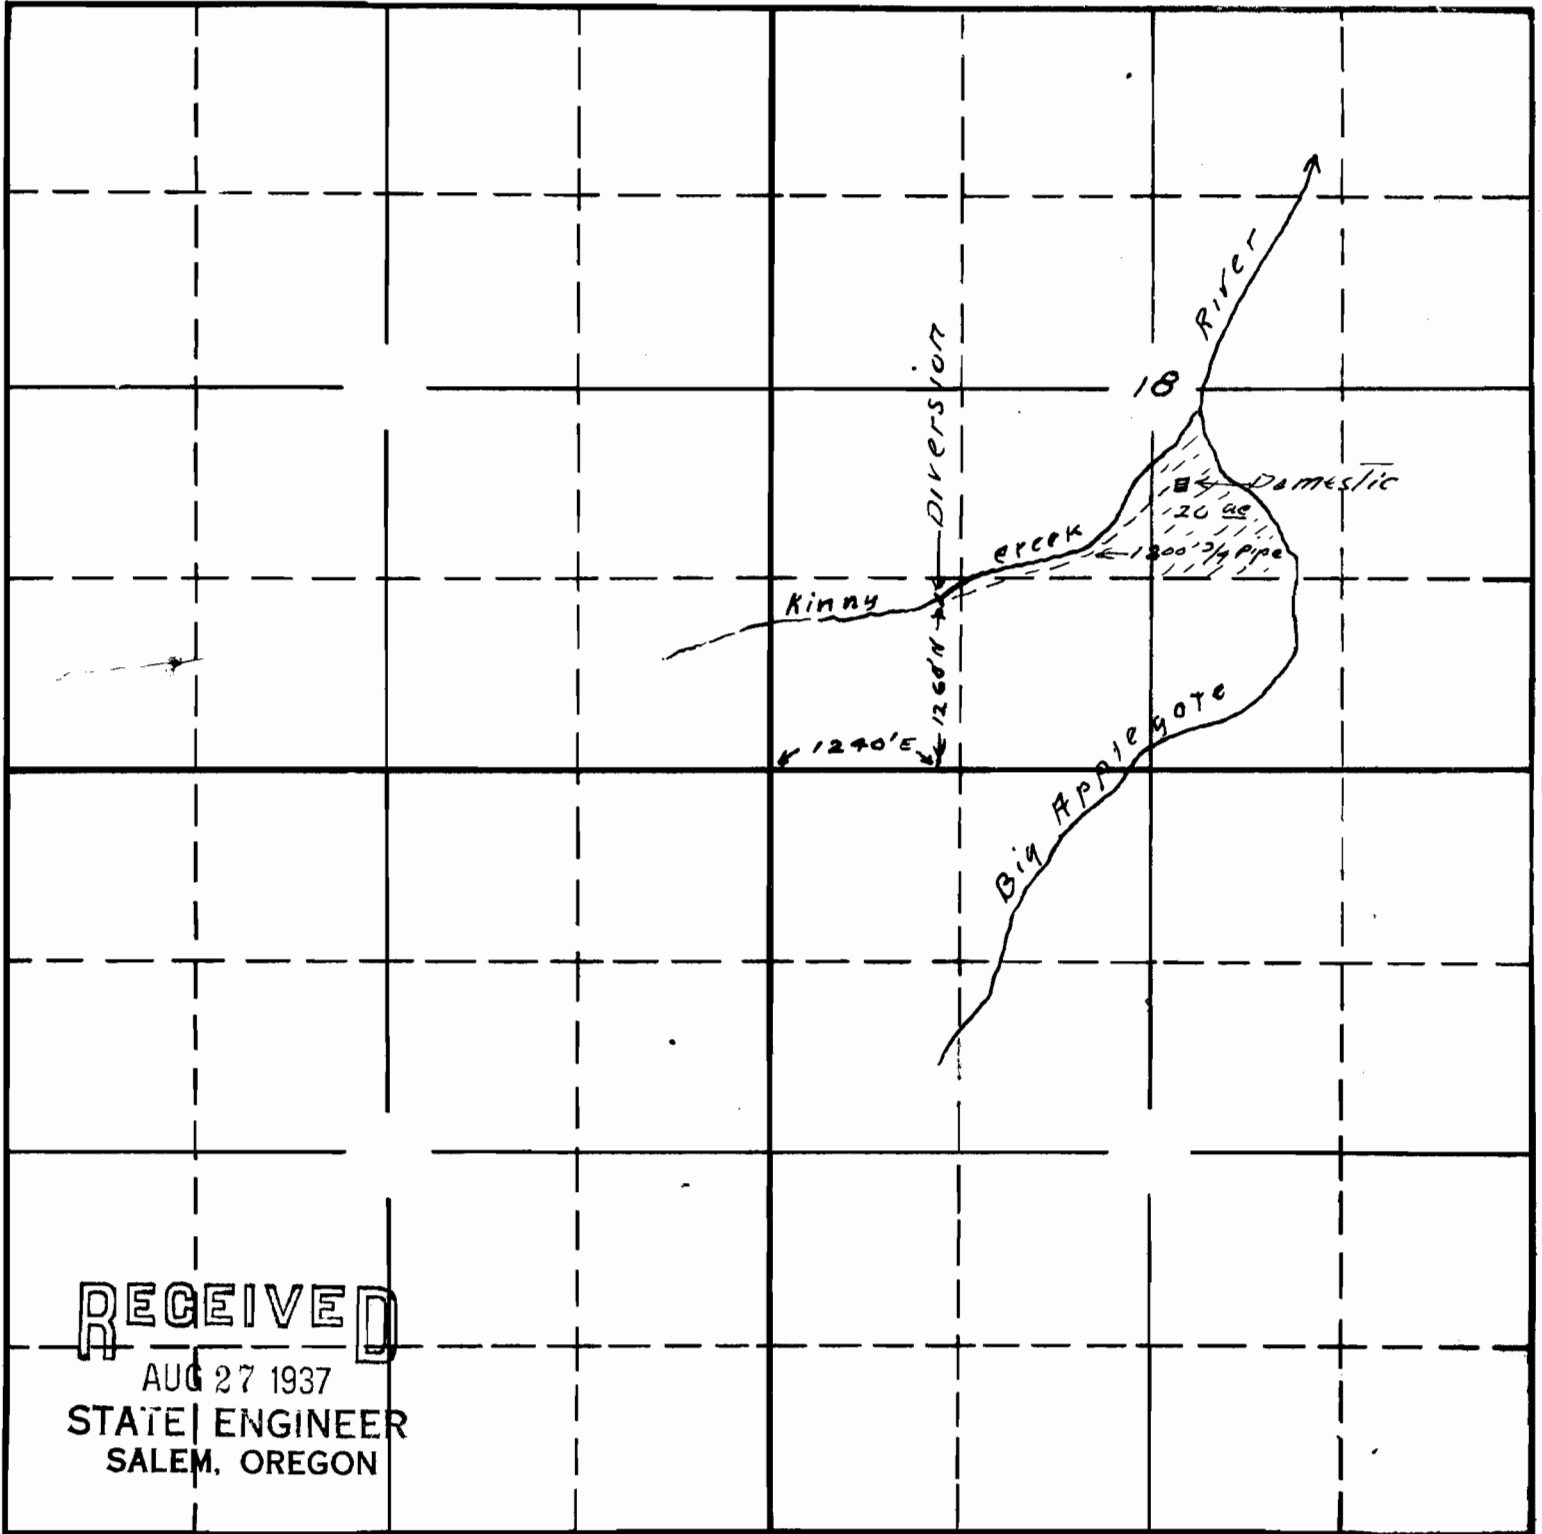

RECEIVED

AUG 27 1937  
STATE ENGINEER  
SALEM, OREGON

South

Sketch to accompany application of  
CWColy for use of the waters of Kinny  
Creek for domestic - and irrigation  
supplimental supply for irrigation

17066

APPLICATION No. 17066  
PERMIT No. 12800