


SECTION

TOWNSHIP 34S, RANGE 1W, W. M.

North

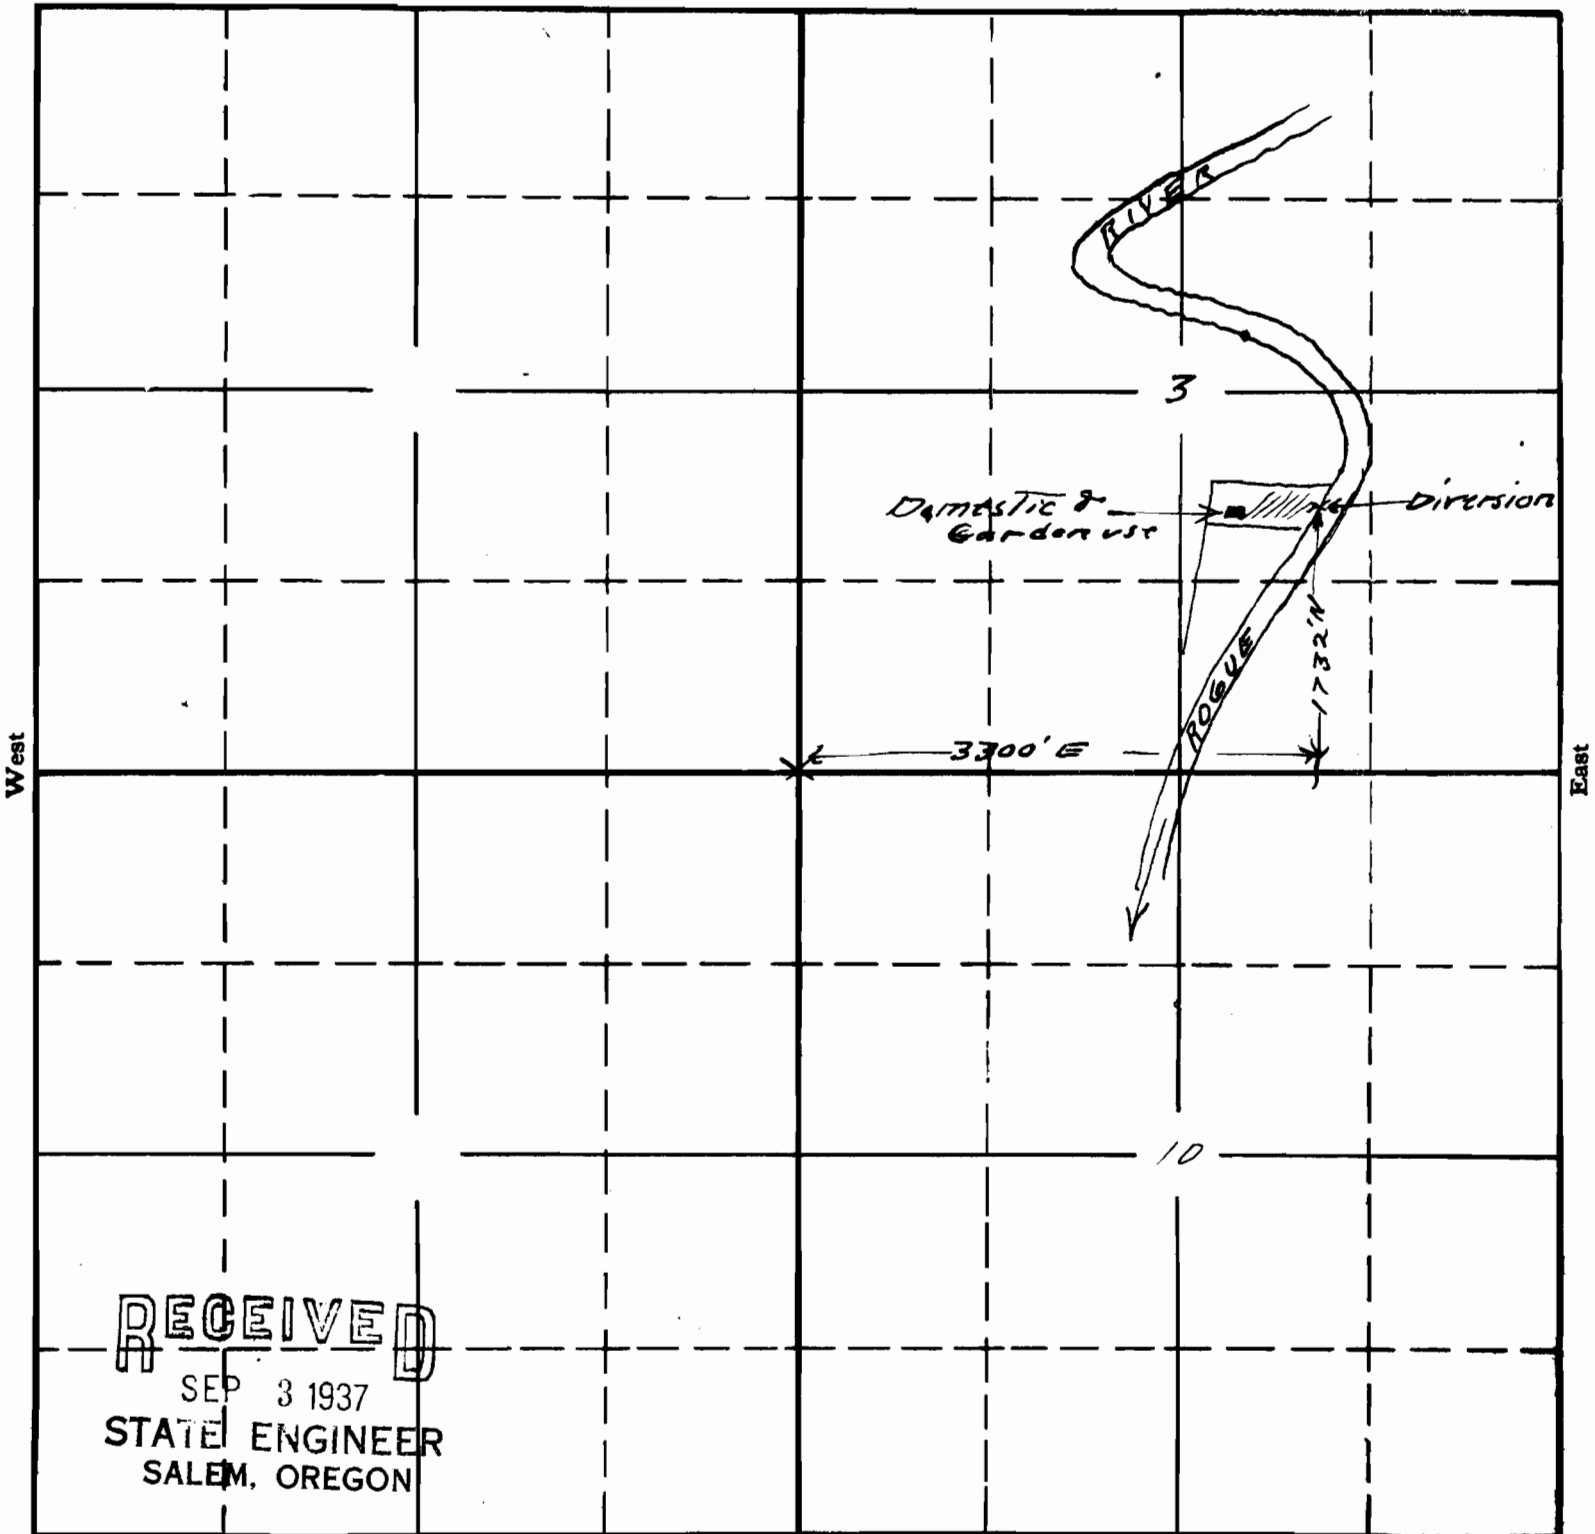

RECEIVED

SEP 3 1937  
STATE ENGINEER  
SALEM, OREGON

Sketch made to accompany South application of Earnests and Zuba Gates for pumping from Rogue River - Domestic-Garden use.

17077  
APPLICATION No. 17077  
PERMIT No. 12808

15-60