


SECTION

29

TOWNSHIP 38 S, RANGE 3 W, W. M.

North

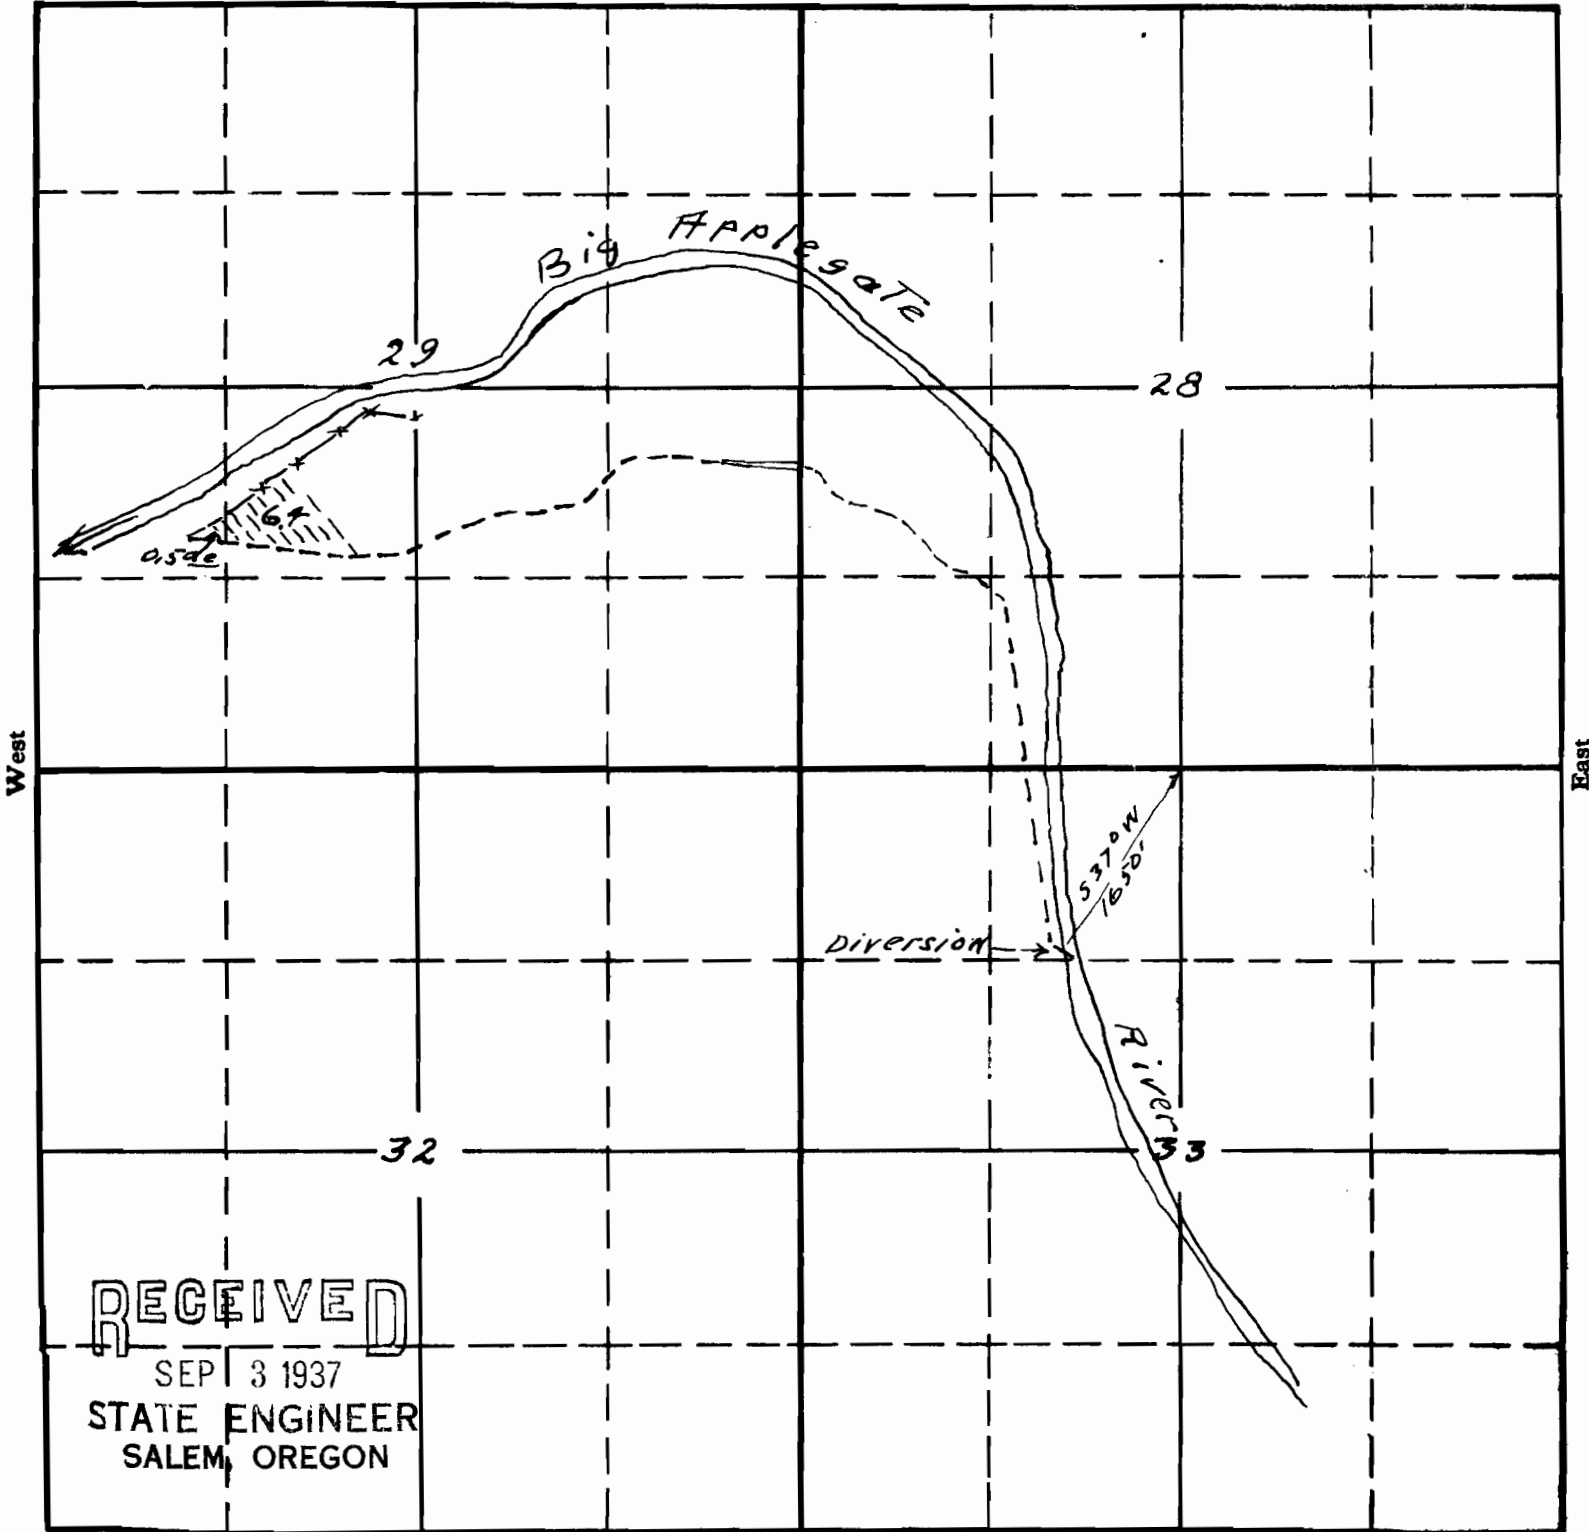

RECEIVED

SEP 3 1937
STATE ENGINEER
SALEM, OREGON

South

Sketch showing place of use and diversion for application to the use of waters of Big Applegate for irrigation purposes. by Ray Ottenbacher.

17078
APPLICATION No. 17078
PERMIT No. 12809