


SECTION 13

13


TOWNSHIP _____, RANGE _____, W. M.

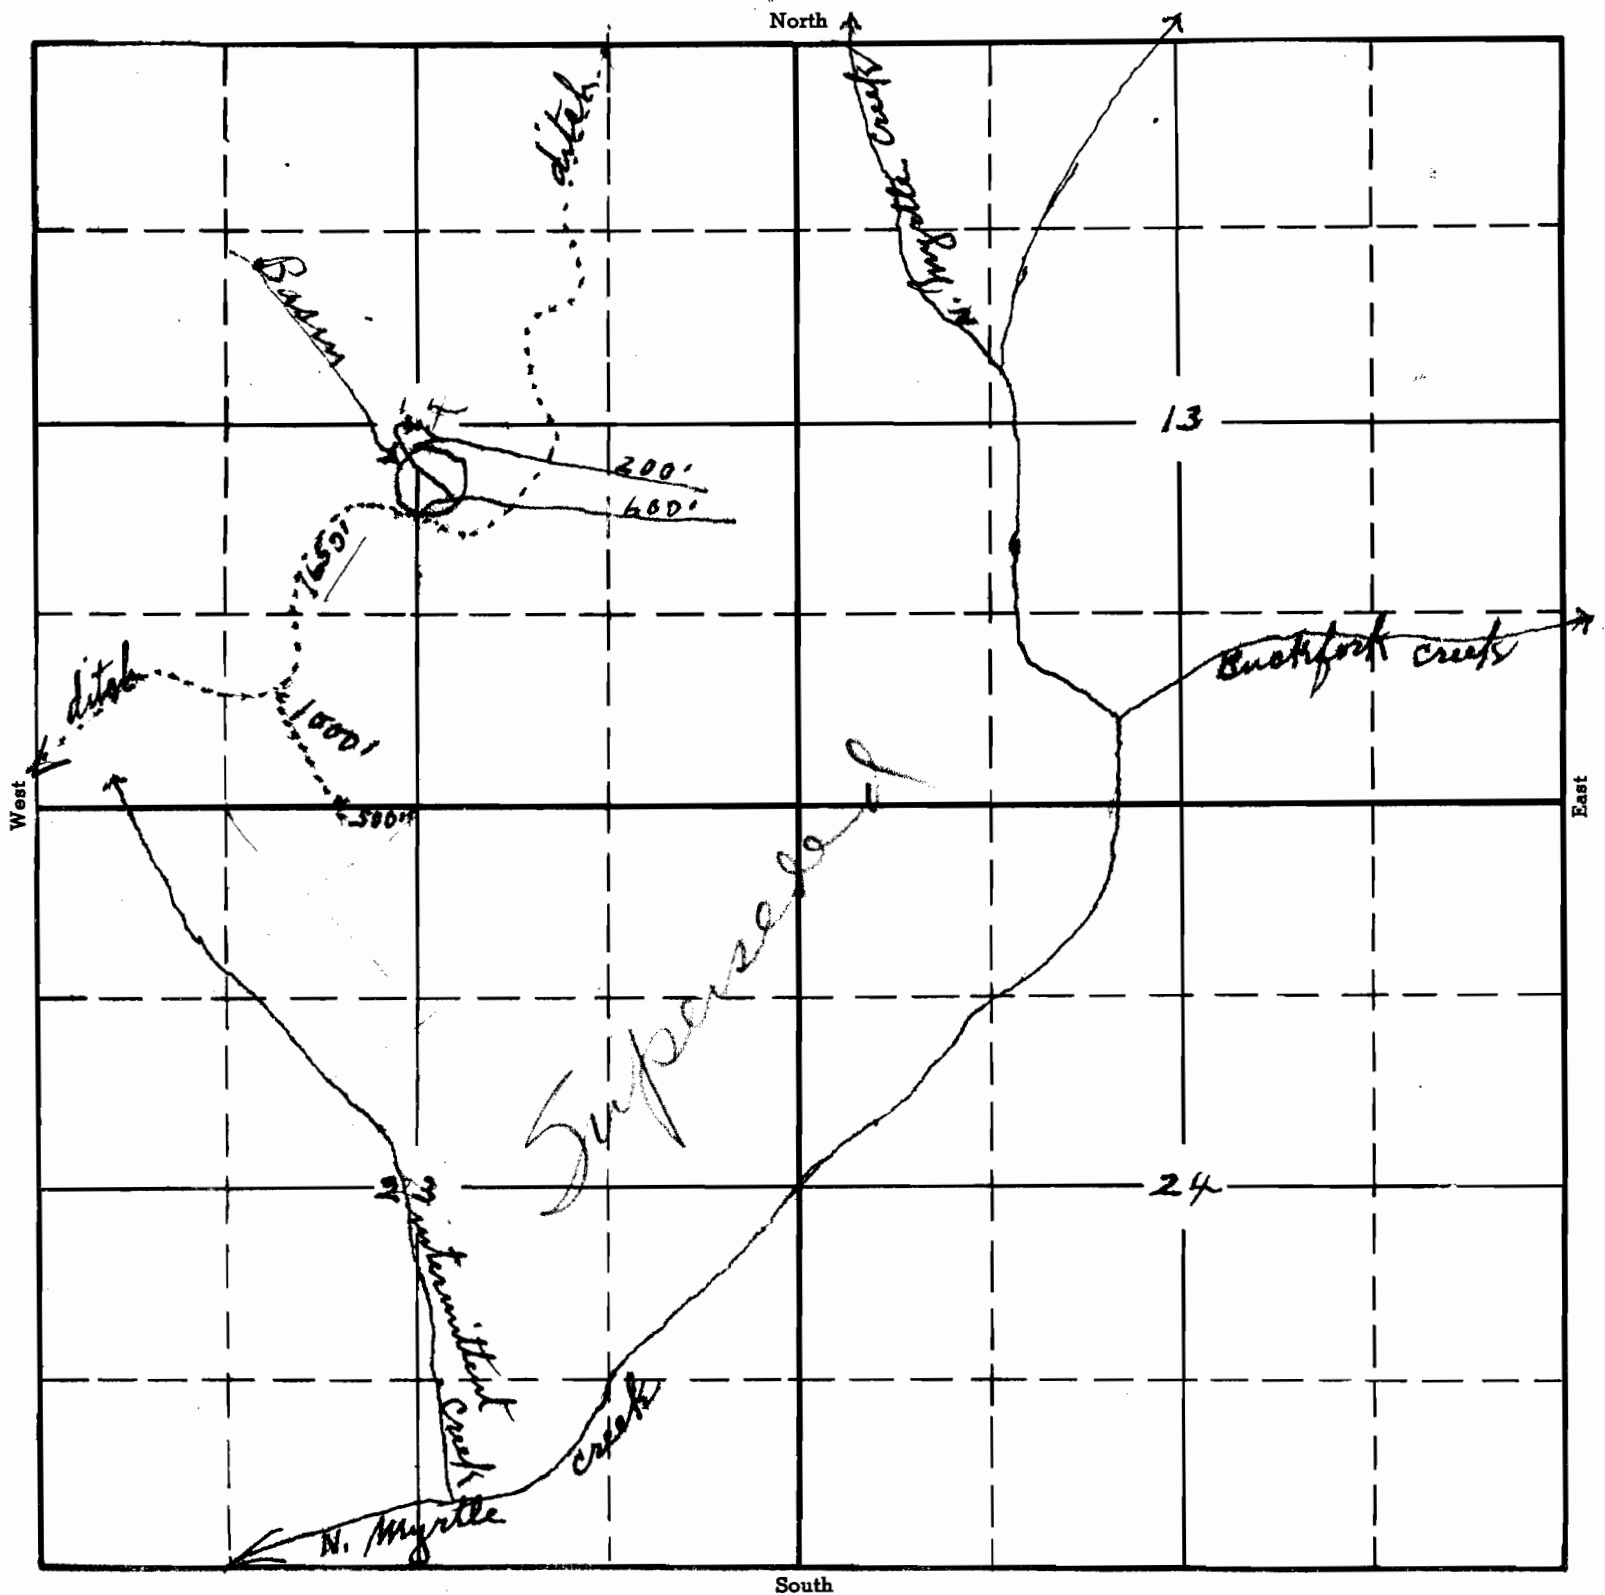

APPLICATION No.
PERMIT No.

TOWNSHIP 28 S RANGE 4 W, W. M.

North

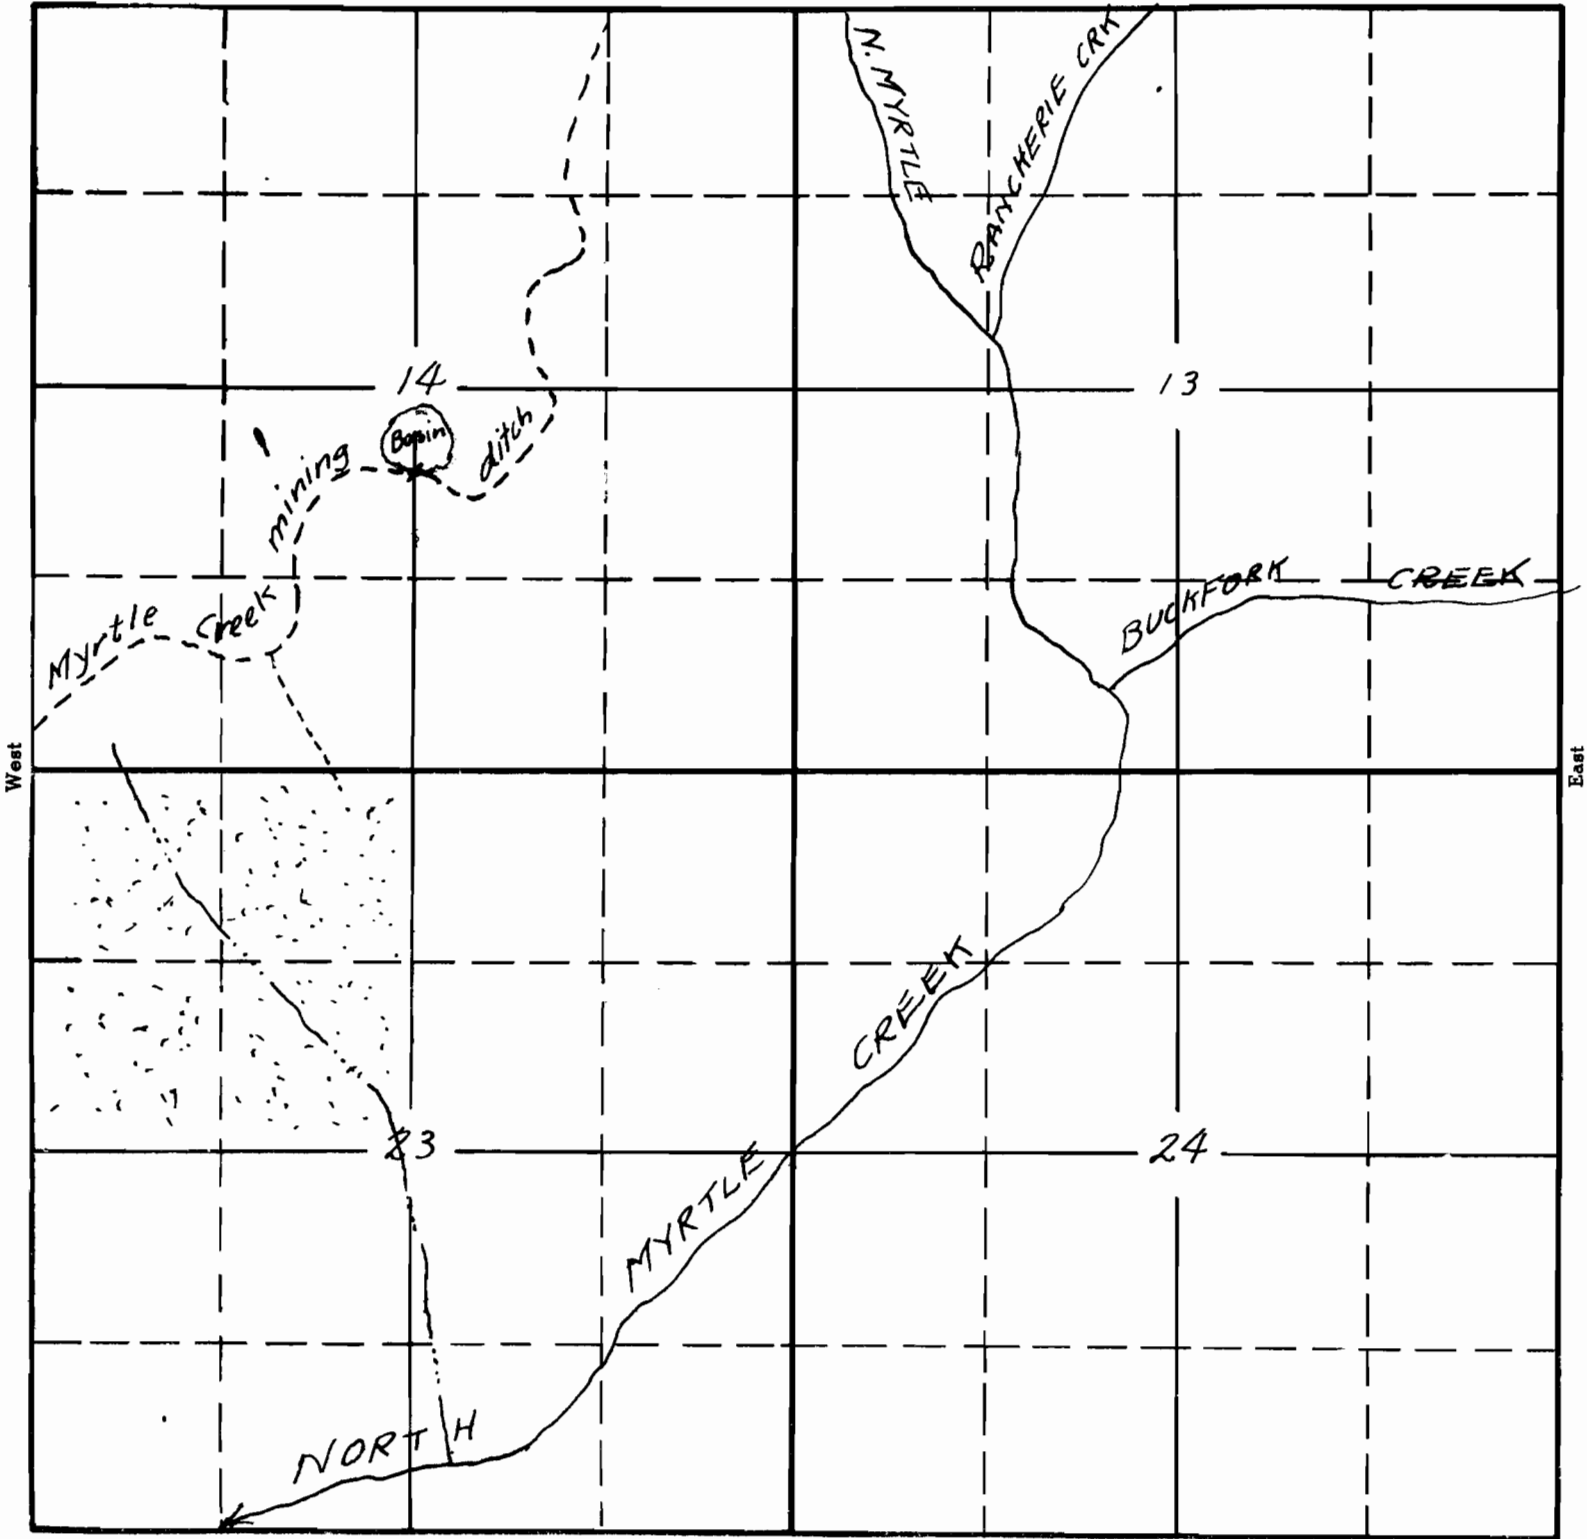

South

17095 ORS
16-35

APPLICATION No. 17095
PERMIT No. 12834