


T. 5 S. R. 2 E. W. M.

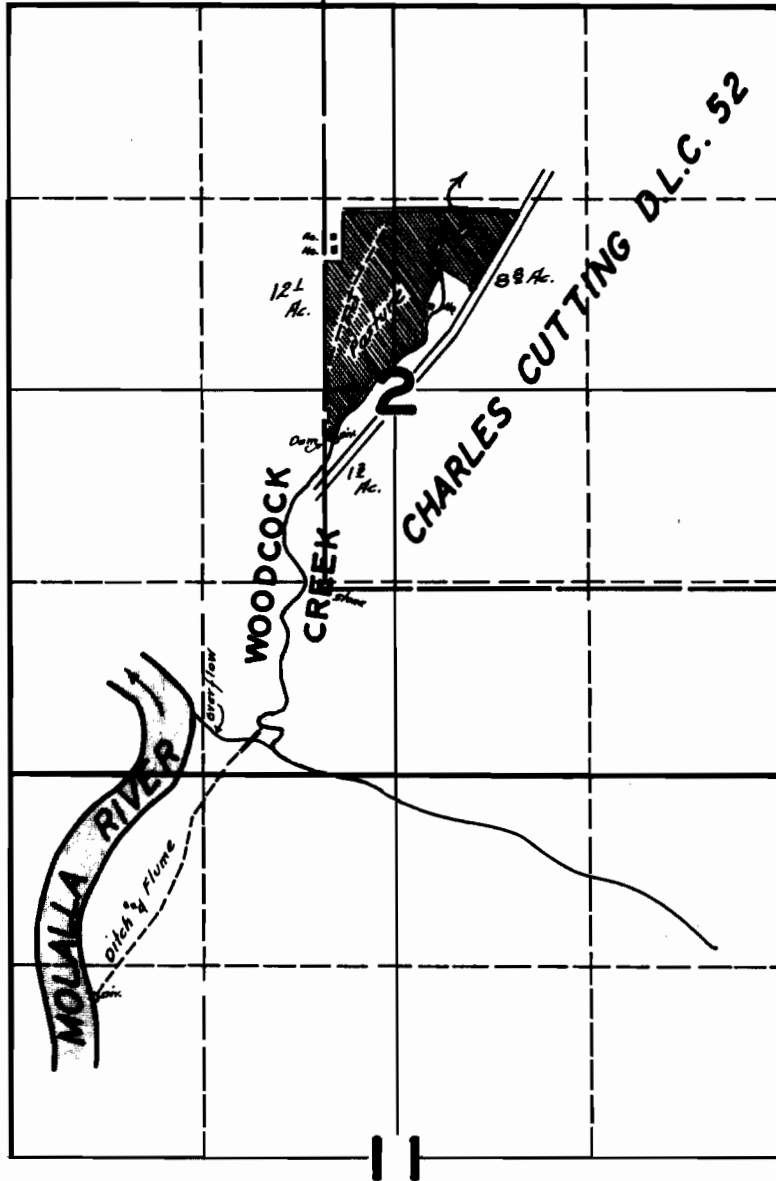

**FINAL PROOF SURVEY**  
UNDER

Application No. 17169 Permit No. 12886

IN NAME OF

RUFUS C. HOLMAN

AUG. 17 1945

Surveyed MAR. 21 1946. by *[Signature]*