


PROOF MAP

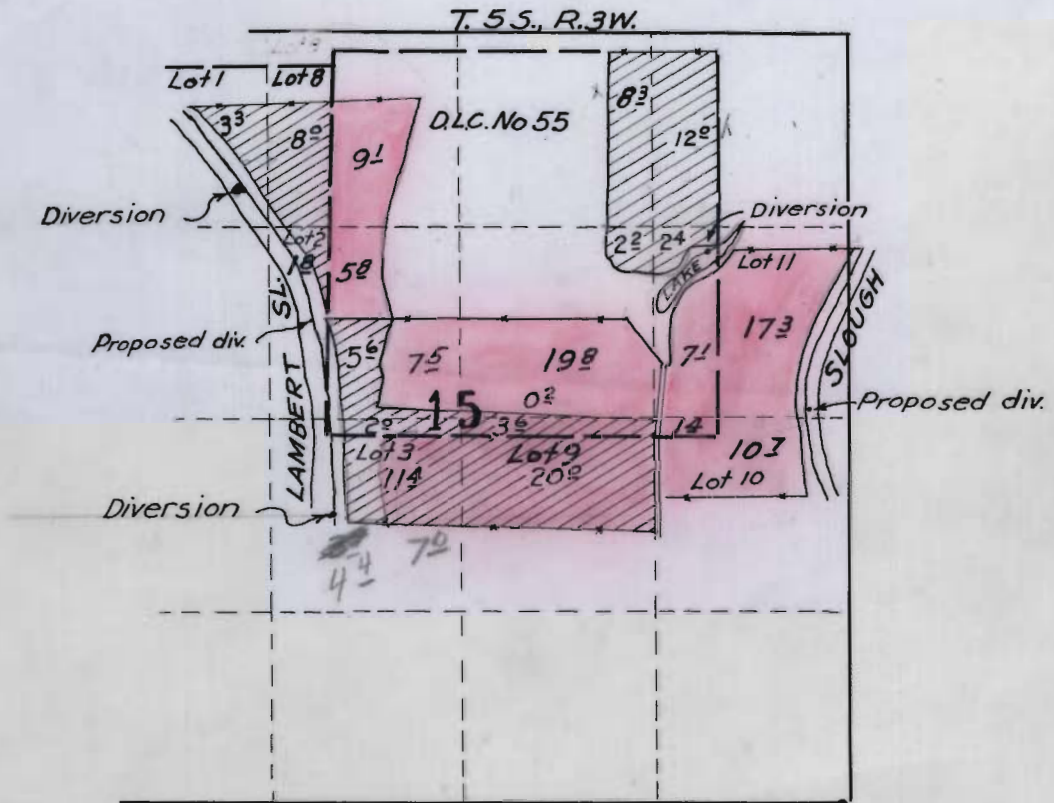

Application No. 17181
Permit No. 12893

App. 15897

17181 OK
2-76d