


24

TOWNSHIP 6S, RANGE 4W, W. M.

North

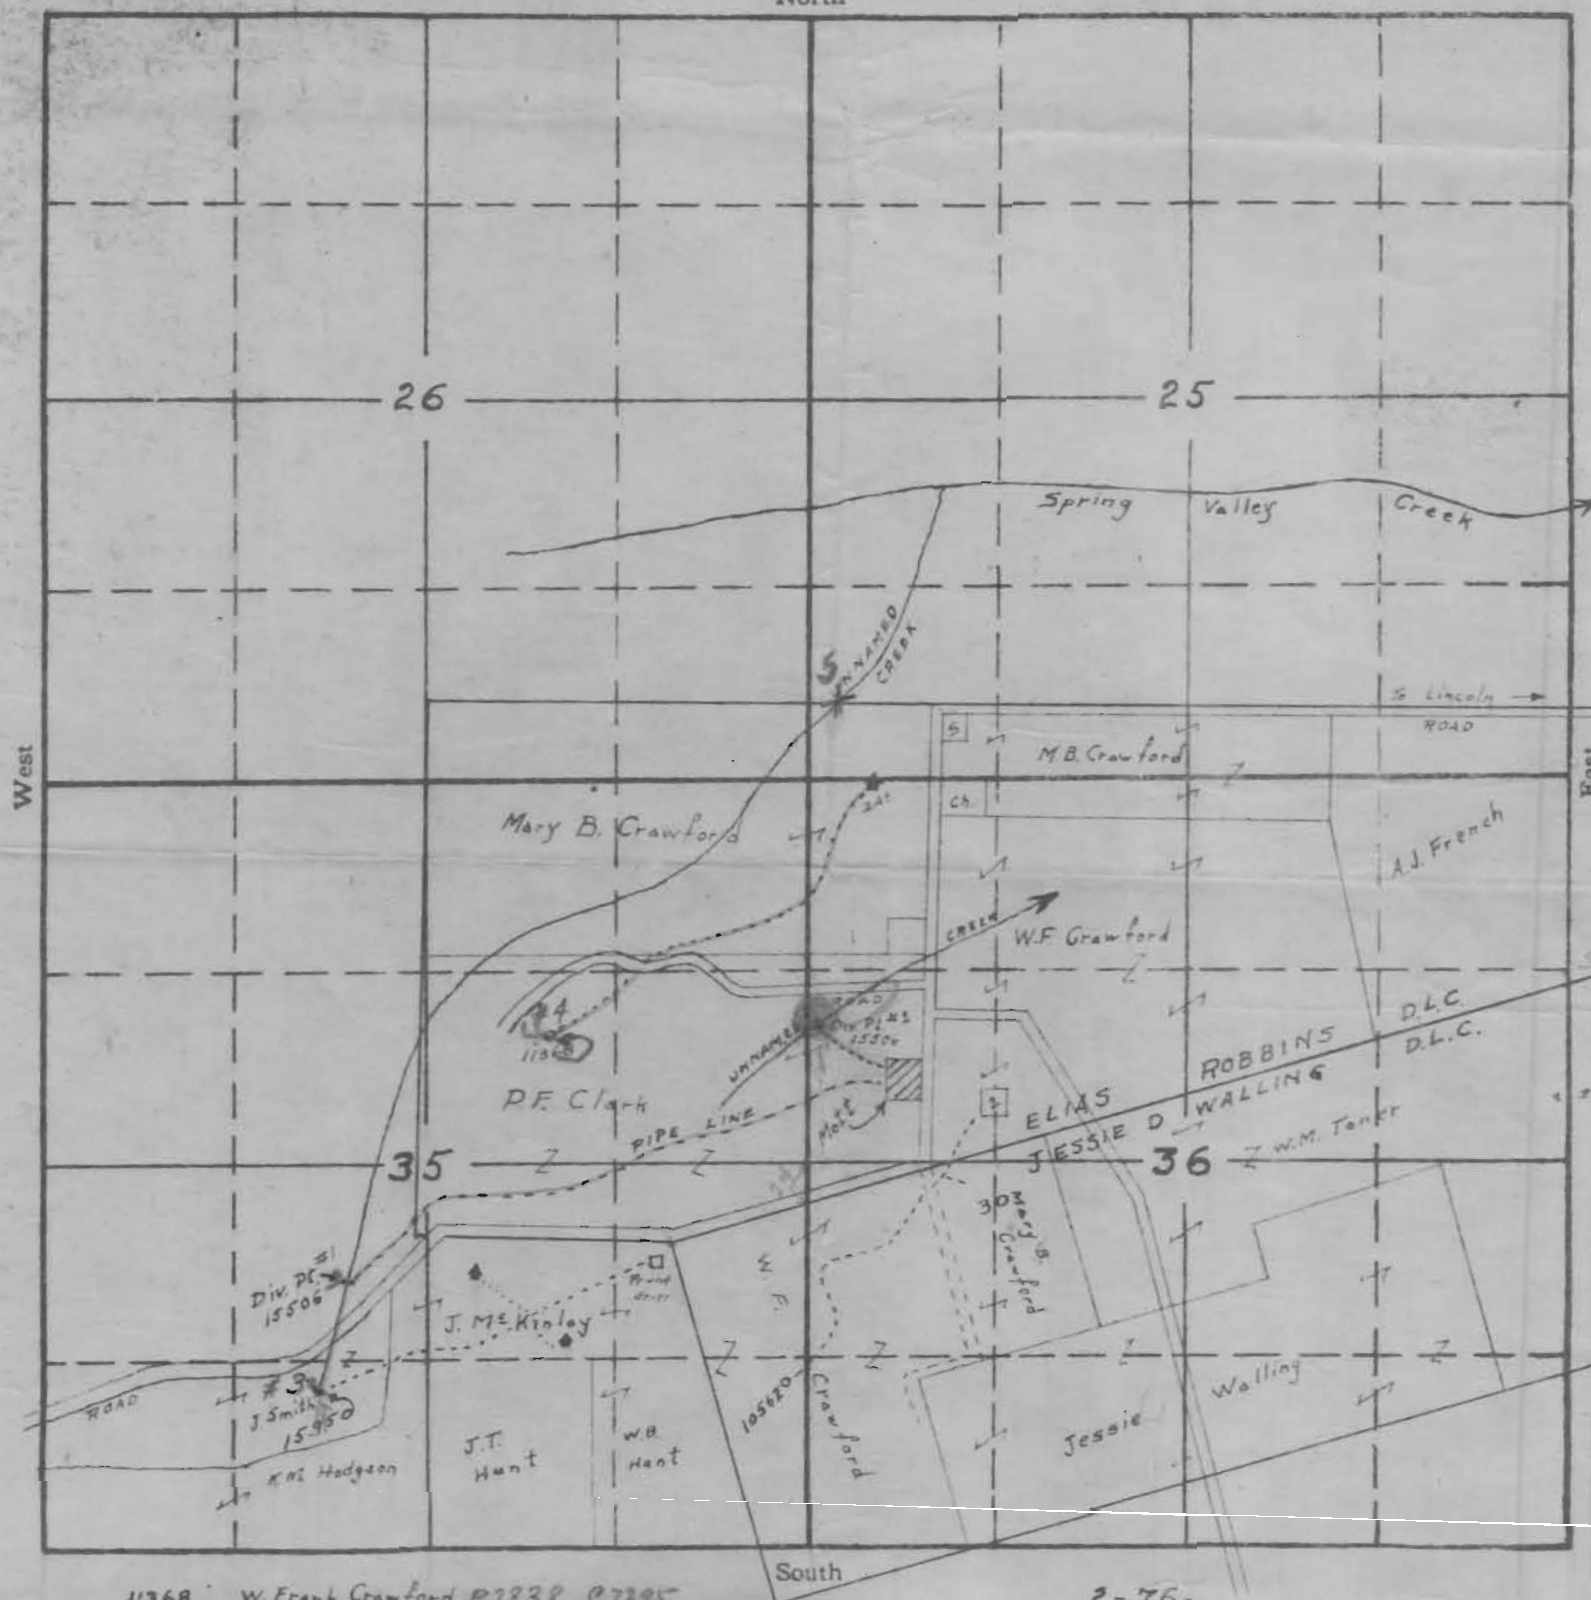

11368 - W. Frank Crawford P1838 C7295
15950 - J. F. McKinlay P11776 C8696
10562 - W. Frank Crawford

2-76-
APPLICATION No. 15506
PERMIT No. 12897

 $M_2 H$

#1 Unnamed Creek (Sec. 36) - .05 - Aug 1, 1936
#2 Unnamed Creek (Sec. 36) - .05 do
#3 Spring, trib of creek #1 - .04 Dec 28, 1937
#4 Spring, (NE 1/4 35) - .04 do

P. 7838 Crawford # 4 unnamed spring — .25 Mar. 12, 1927 Dom. stk and Irr. of 2 acres.
P. 11886 McKinley # 3 unnamed spring — .05 July 25, 1935 Dom. inc. garden + pruned dryer.
P. 13632 Stewart { 3 " " — 39 Apr. 28, 1939 Dom. + Irr. of 30 Ac. ~~also~~ it
 3 " " " " " storage sac. ft
P. 13673 Henry - 5 - unnamed Ck. — .44 May 8, 1939 Irr. of 35 Ac.