


SECTION

TOWNSHIP 38 S, RANGE 7 W, W. M.

North

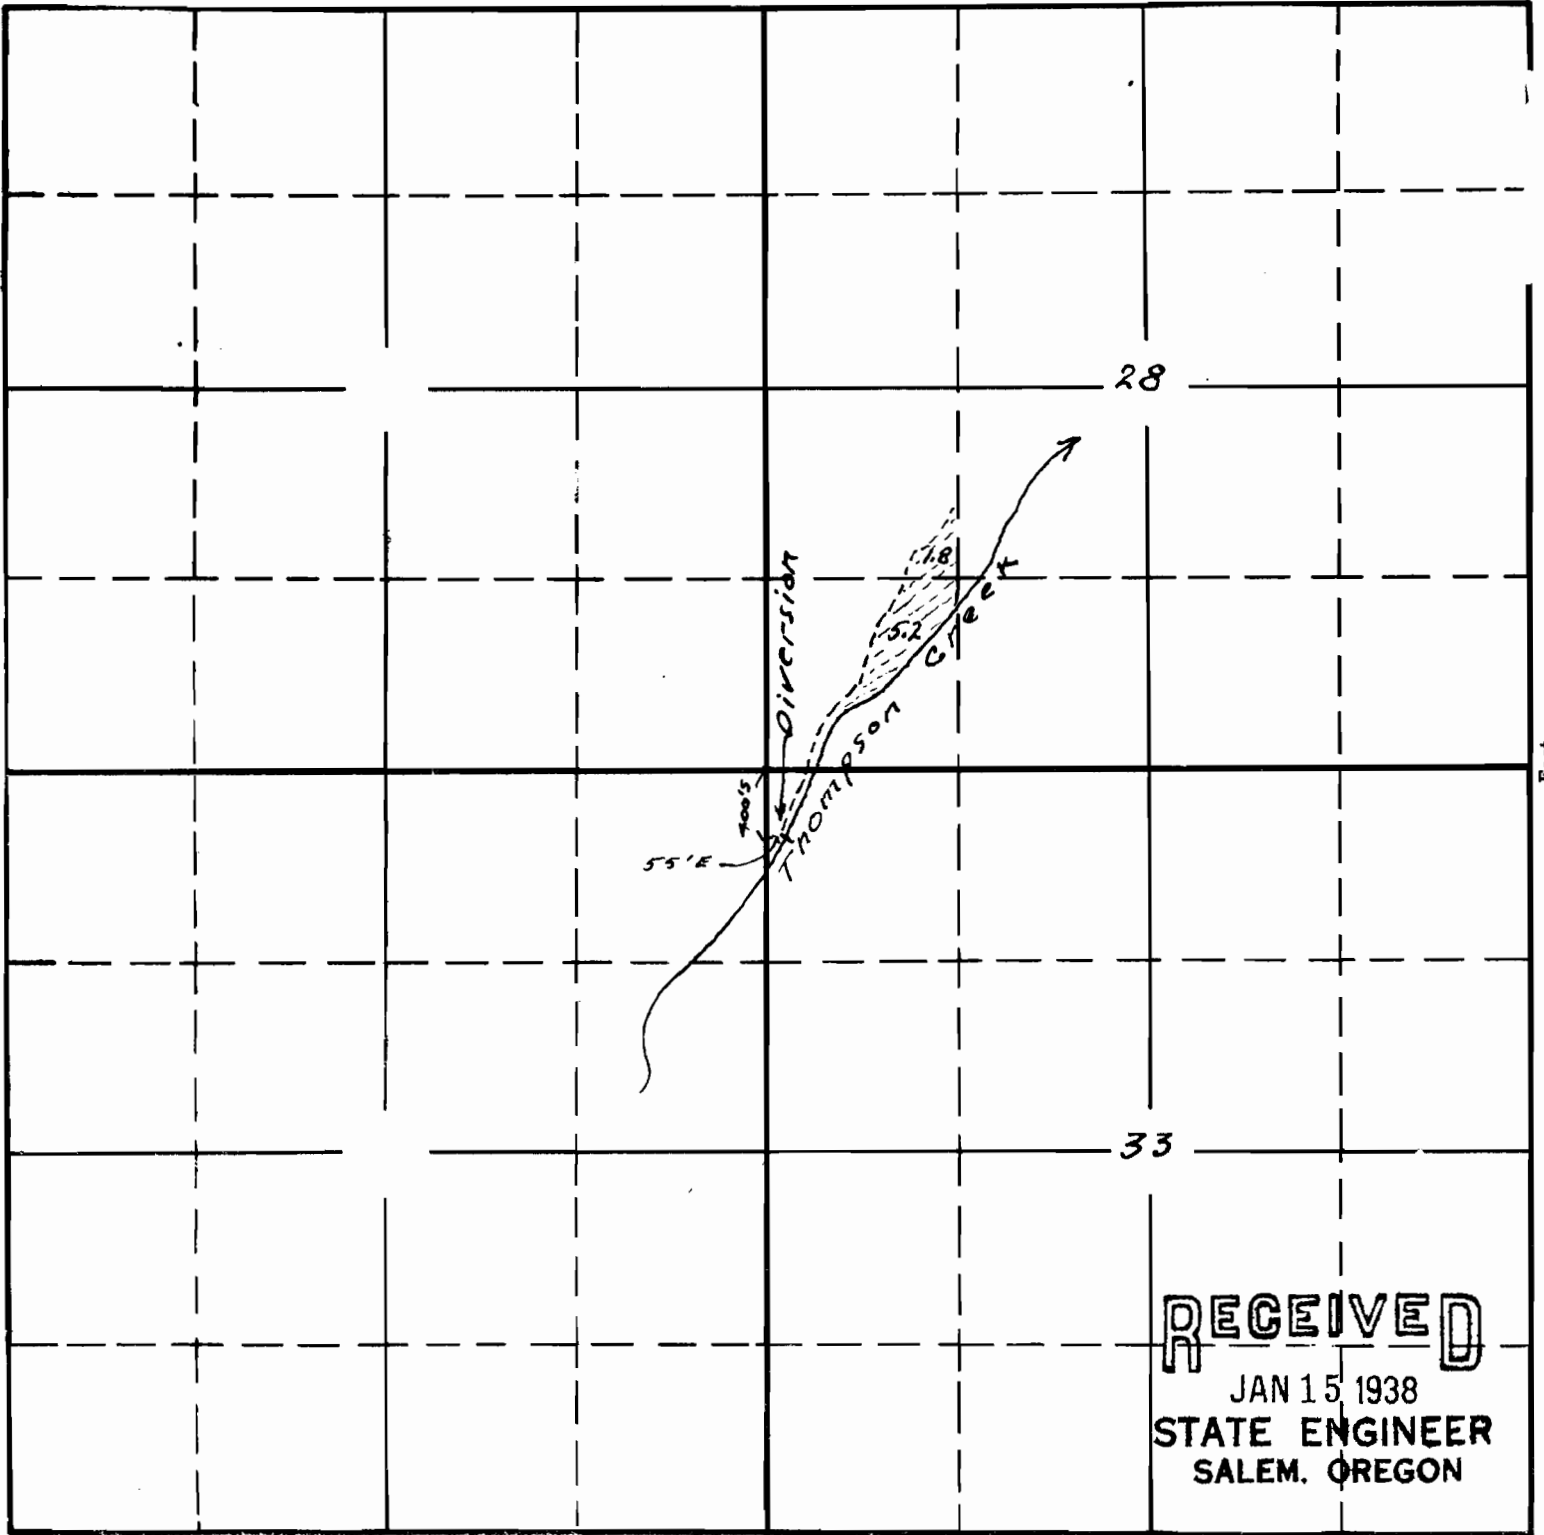

RECEIVED
 JAN 15 1938
 STATE ENGINEER
 SALEM, OREGON

Sketch to accompany application of Mrs Sessie M Kinnsman for supplemental irrigation, from seepage-spring and return flow in Thompson Creek Trip

APPLICATION No. 17207
 PERMIT No. 12929

17207-1-38

This office 1/14/38 C.A.S.