


SECTION

\_\_\_\_\_  
\_\_\_\_\_  
\_\_\_\_\_

TOWNSHIP 33S, RANGE 4W, W. M.

North

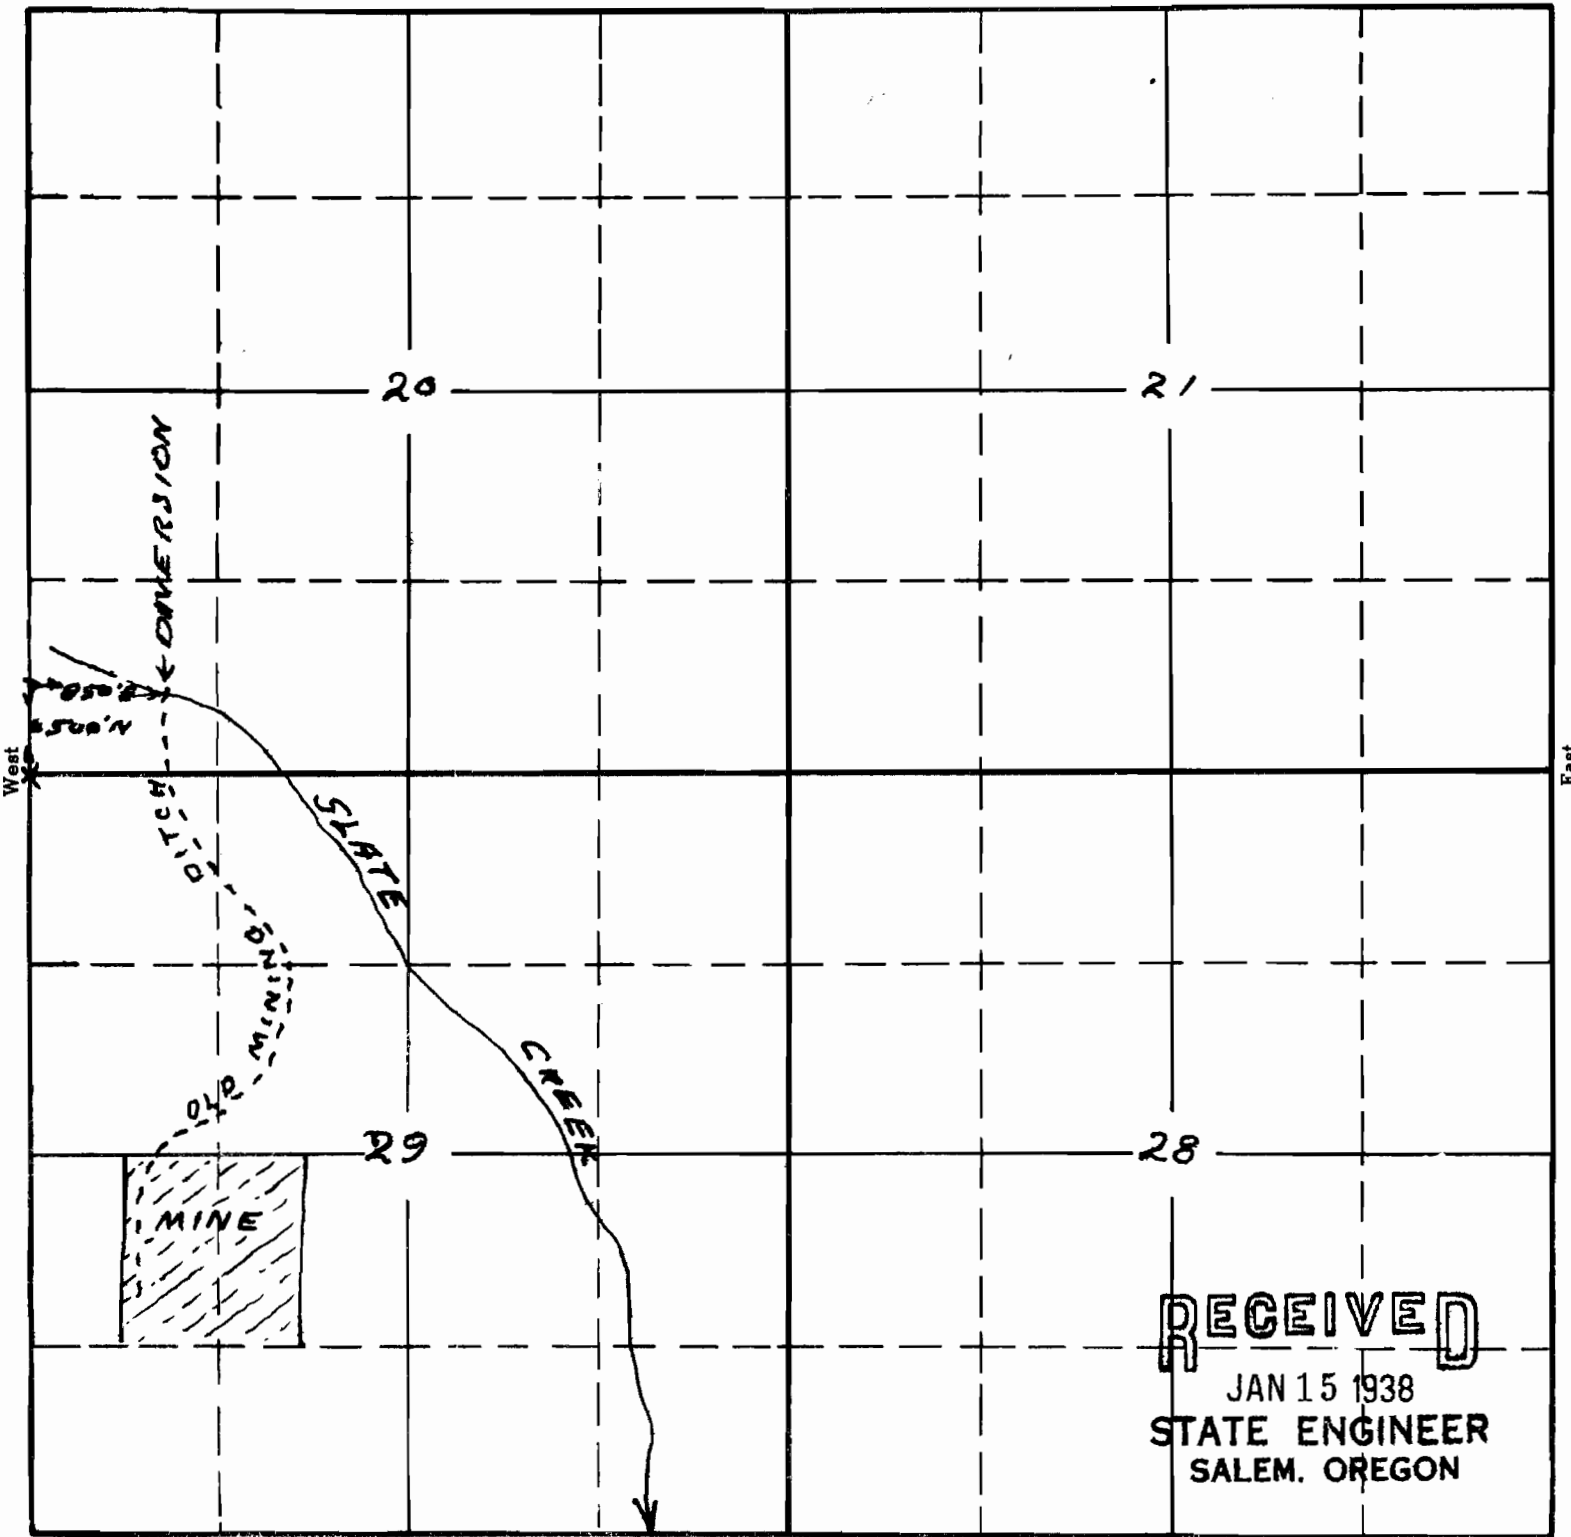

**RECEIVED**  
 JAN 15 1938  
 STATE ENGINEER  
 SALEM, OREGON

Sketch to accompany application of  
 James Bristow-John & Mark Neathamer  
 for waters of State Creek for mining  
 and domestic purposes

APPLICATION No. 17208  
 PERMIT No. 12930

17208-11  
 11-38

This office 1/14/38 C.H.S.