


SECTION

TOWNSHIP 38 S, RANGE 8 W, W. M.

North

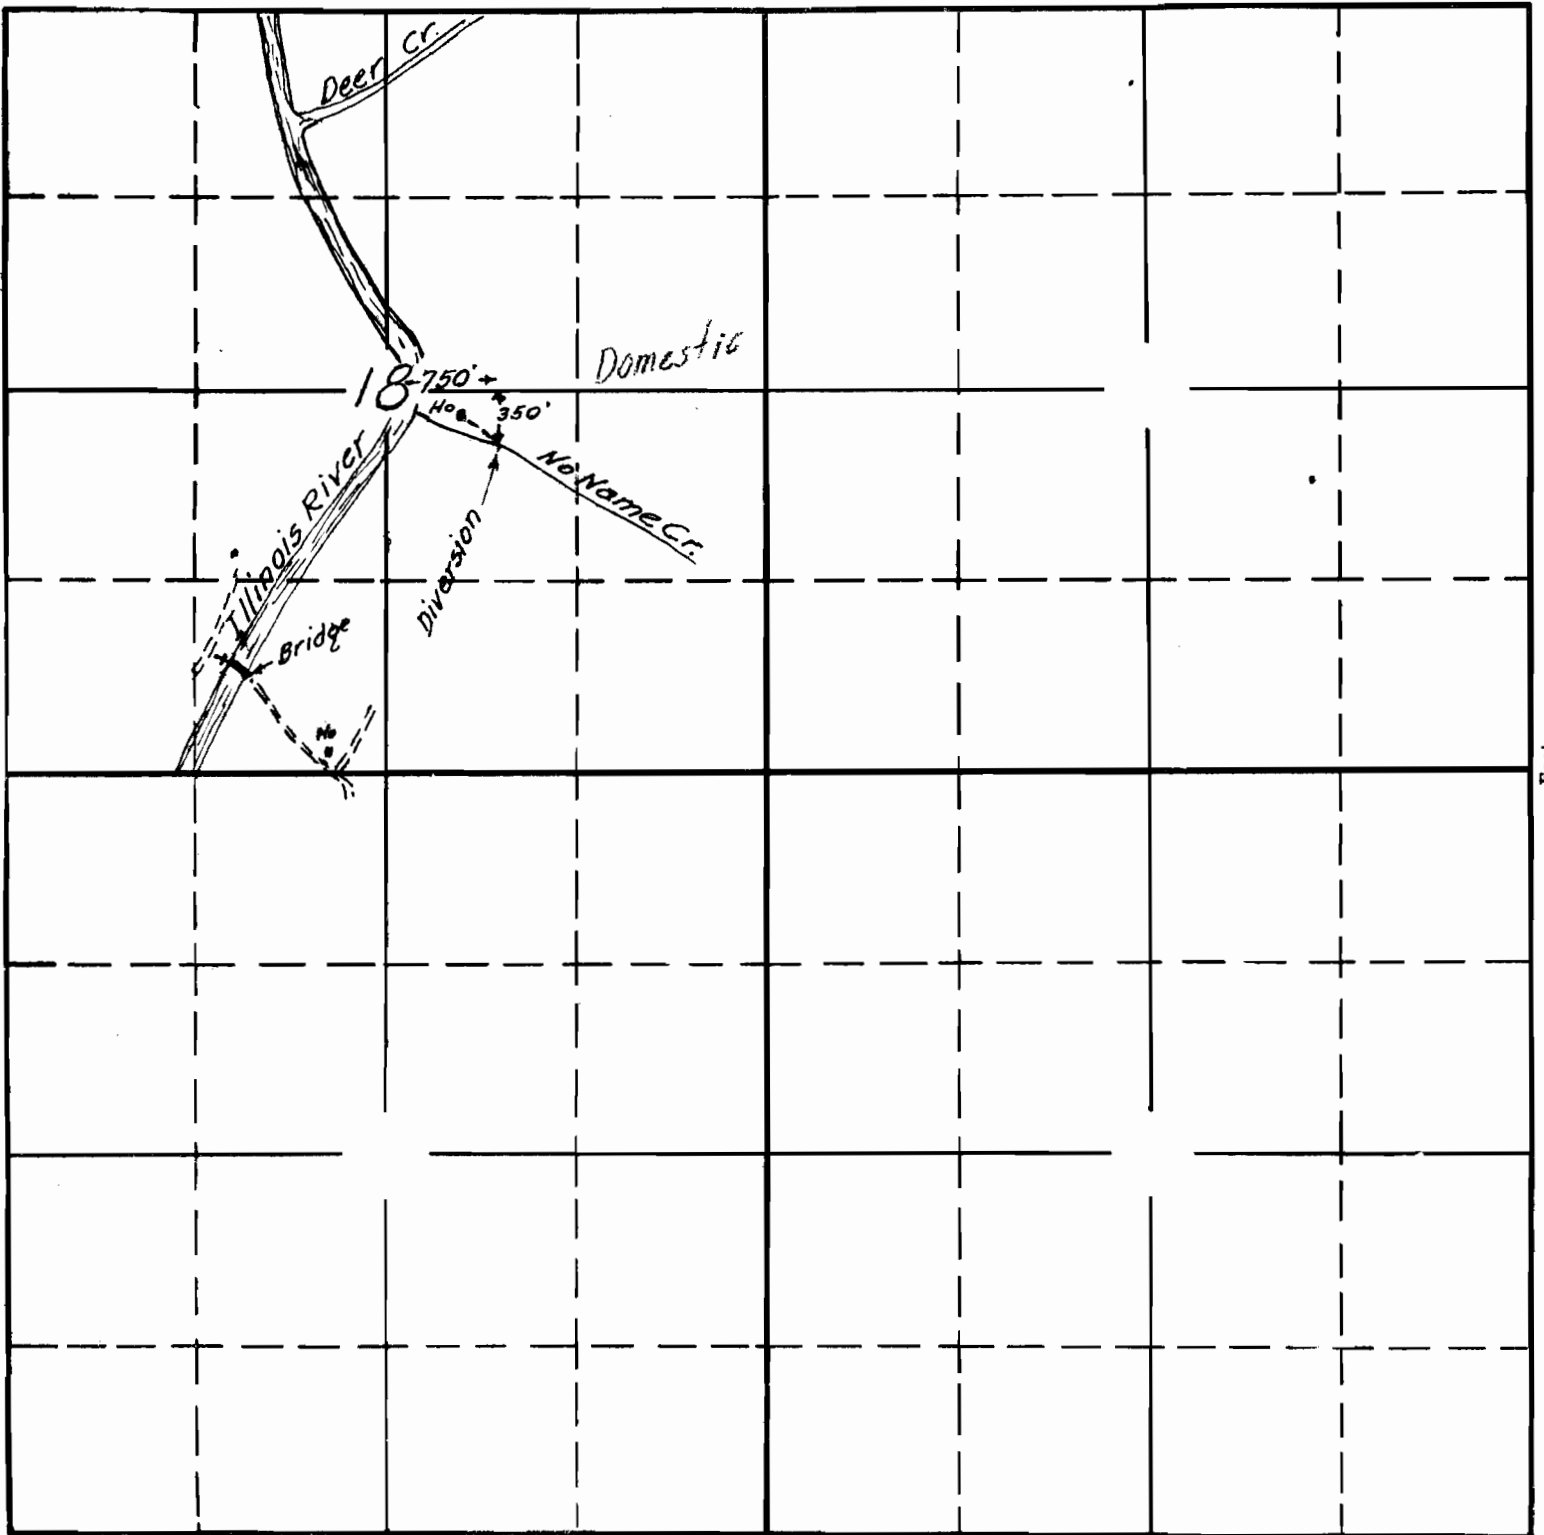

South

Gold Hills Refinery
Fred R. Hills.

July 1938

APPLICATION No. 17210
PERMIT No. 12932

17210

15 5600

RECEIVED

JAN 17 1938

STATE ENGINEER
SALEM, OREGON