


SECTION

TOWNSHIP 37S, RANGE 1E, W. M.

North

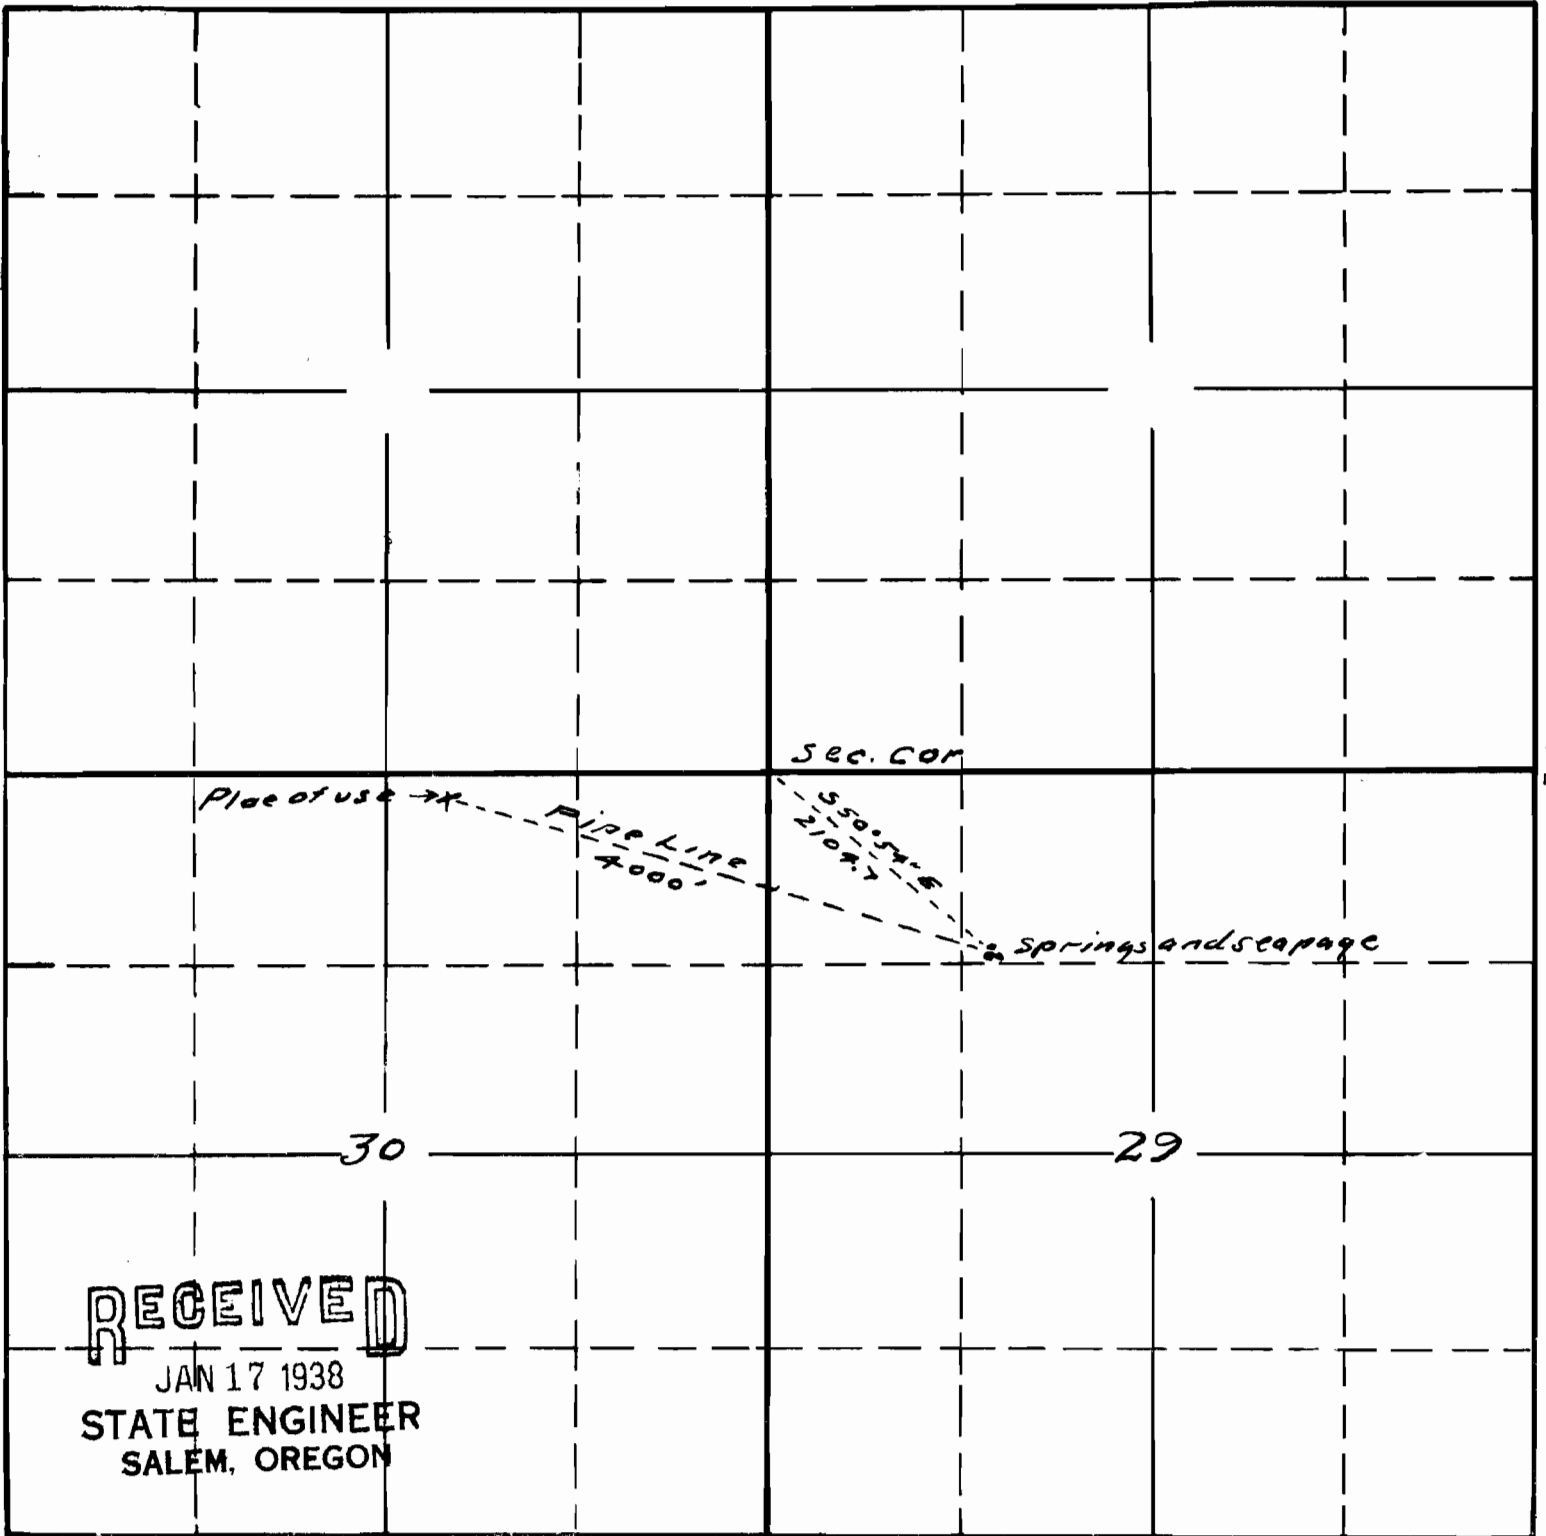

RECEIVED

JAN 17 1938

STATE ENGINEER
SALEM, OREGON

sketch made in the field by H Powell
To accompany application of
G.E. Pierce for use of unnamed
springs and seepage for domestic
purposes

15732
1721101

APPLICATION No. 17211
PERMIT No. 12933

This office Jan 12 1938 O.P.S.