


SECTION

TOWNSHIP 9S, RANGE 2E, W. M.

North

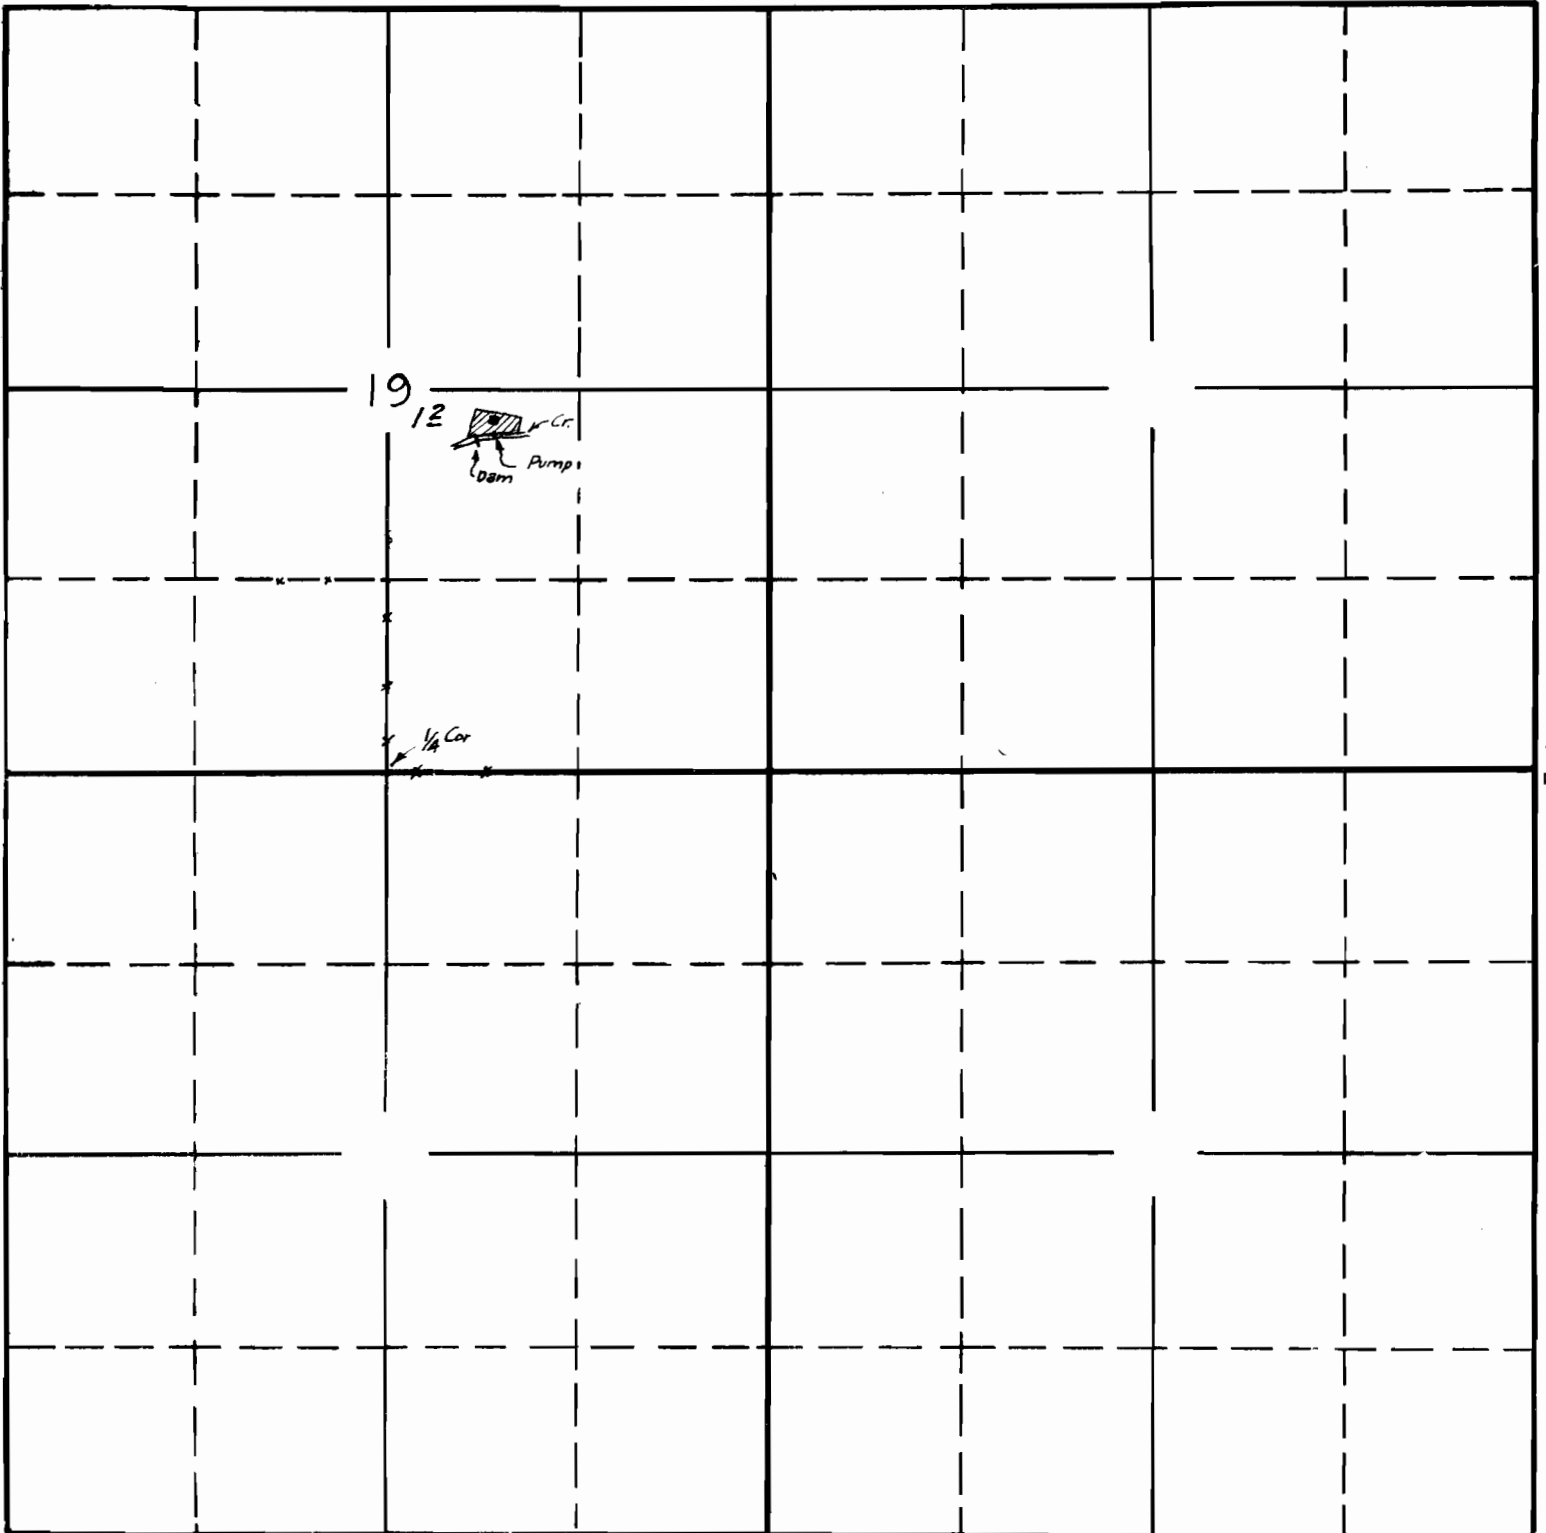

West

East

South

APPLICATION No. 17219

PERMIT No. 12940