


SECTION

TOWNSHIP 2 S, RANGE 3 E, W. M.

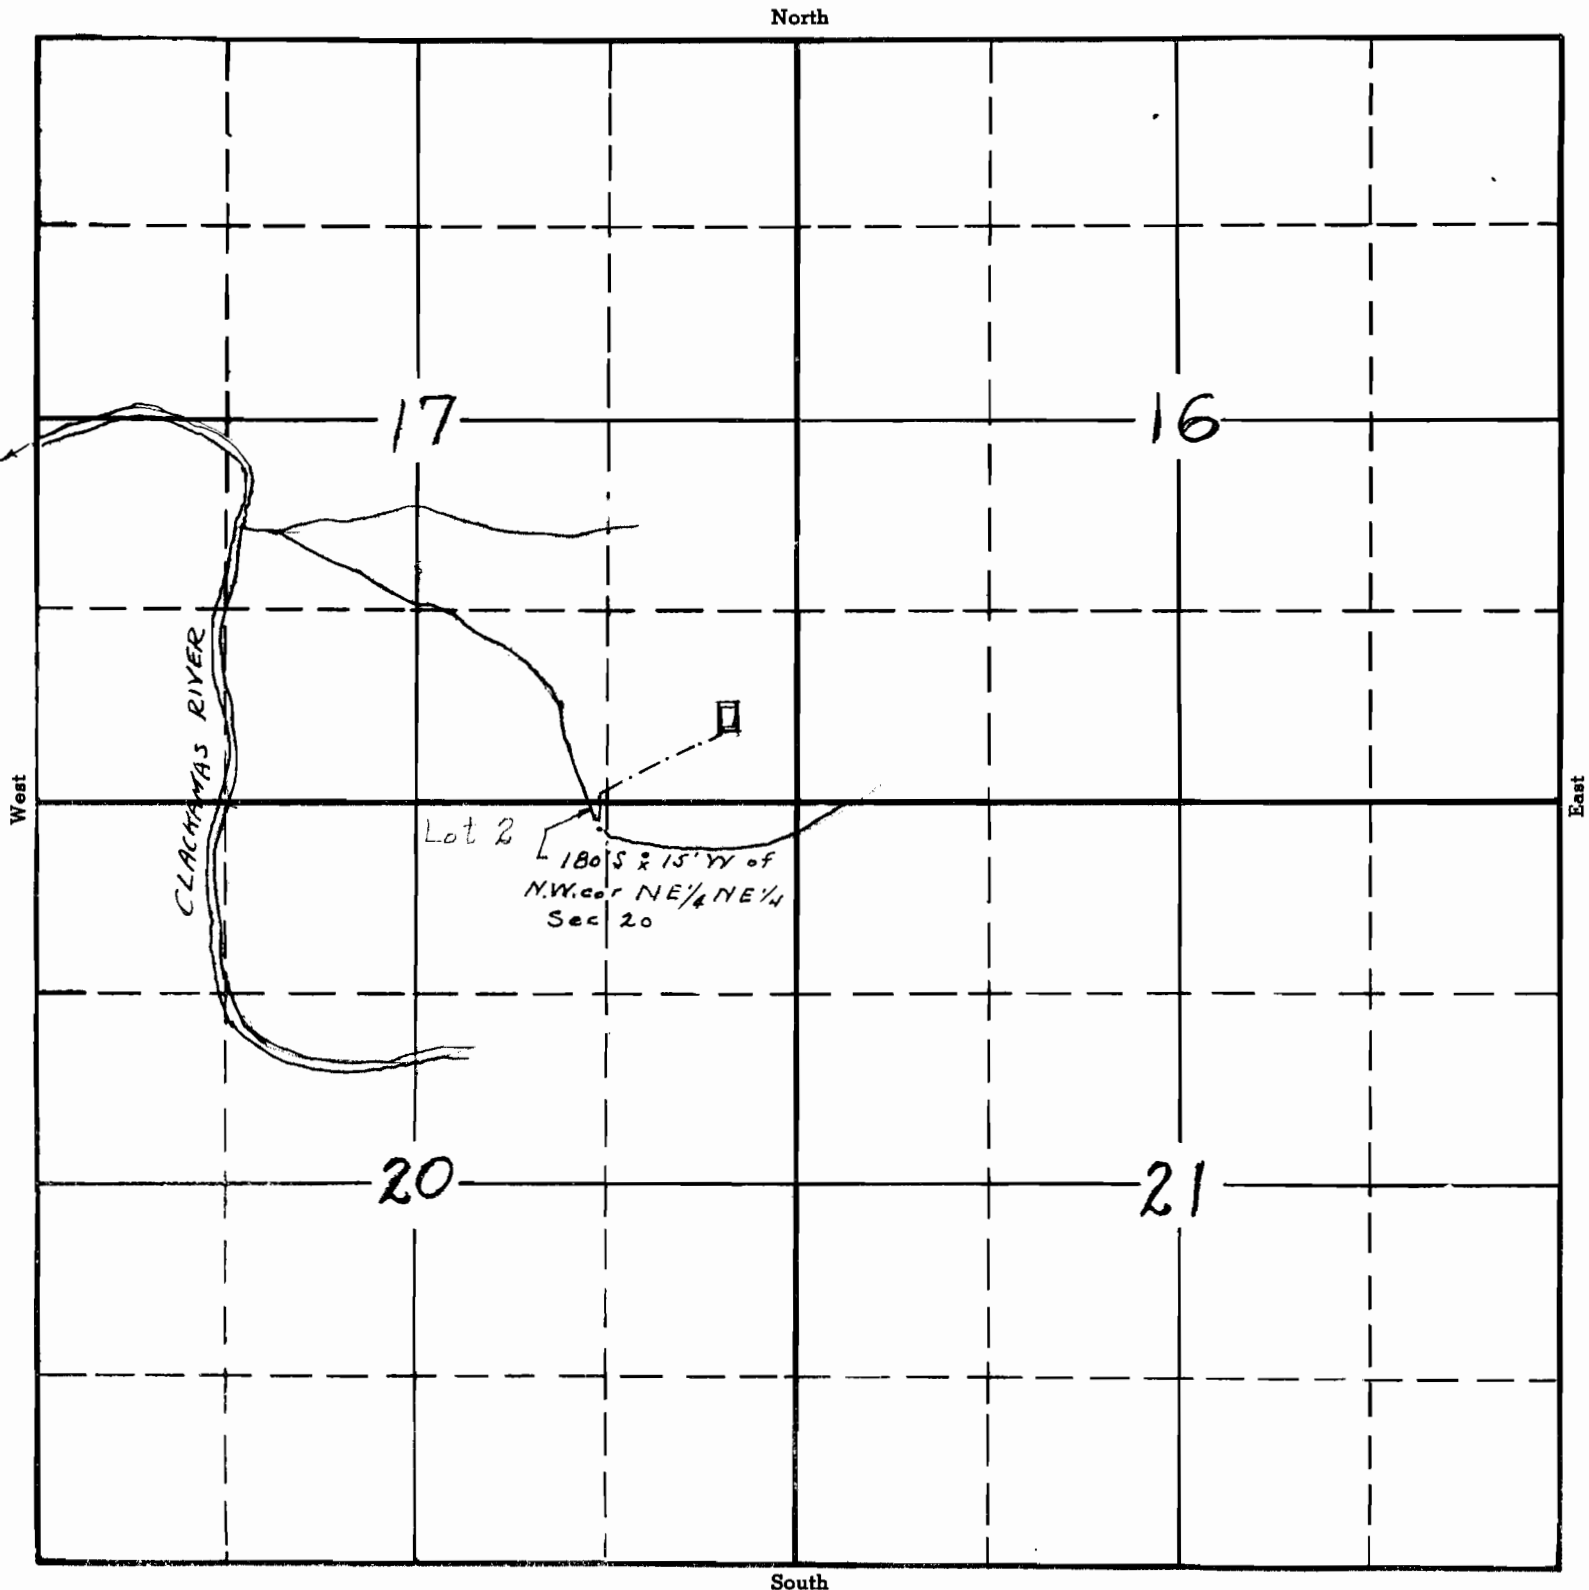

17239 MK
2-10-00

APPLICATION No. 17239
PERMIT No. 12965