


SECTION

TOWNSHIP 31 S, RANGE 4 W., W. M.

North

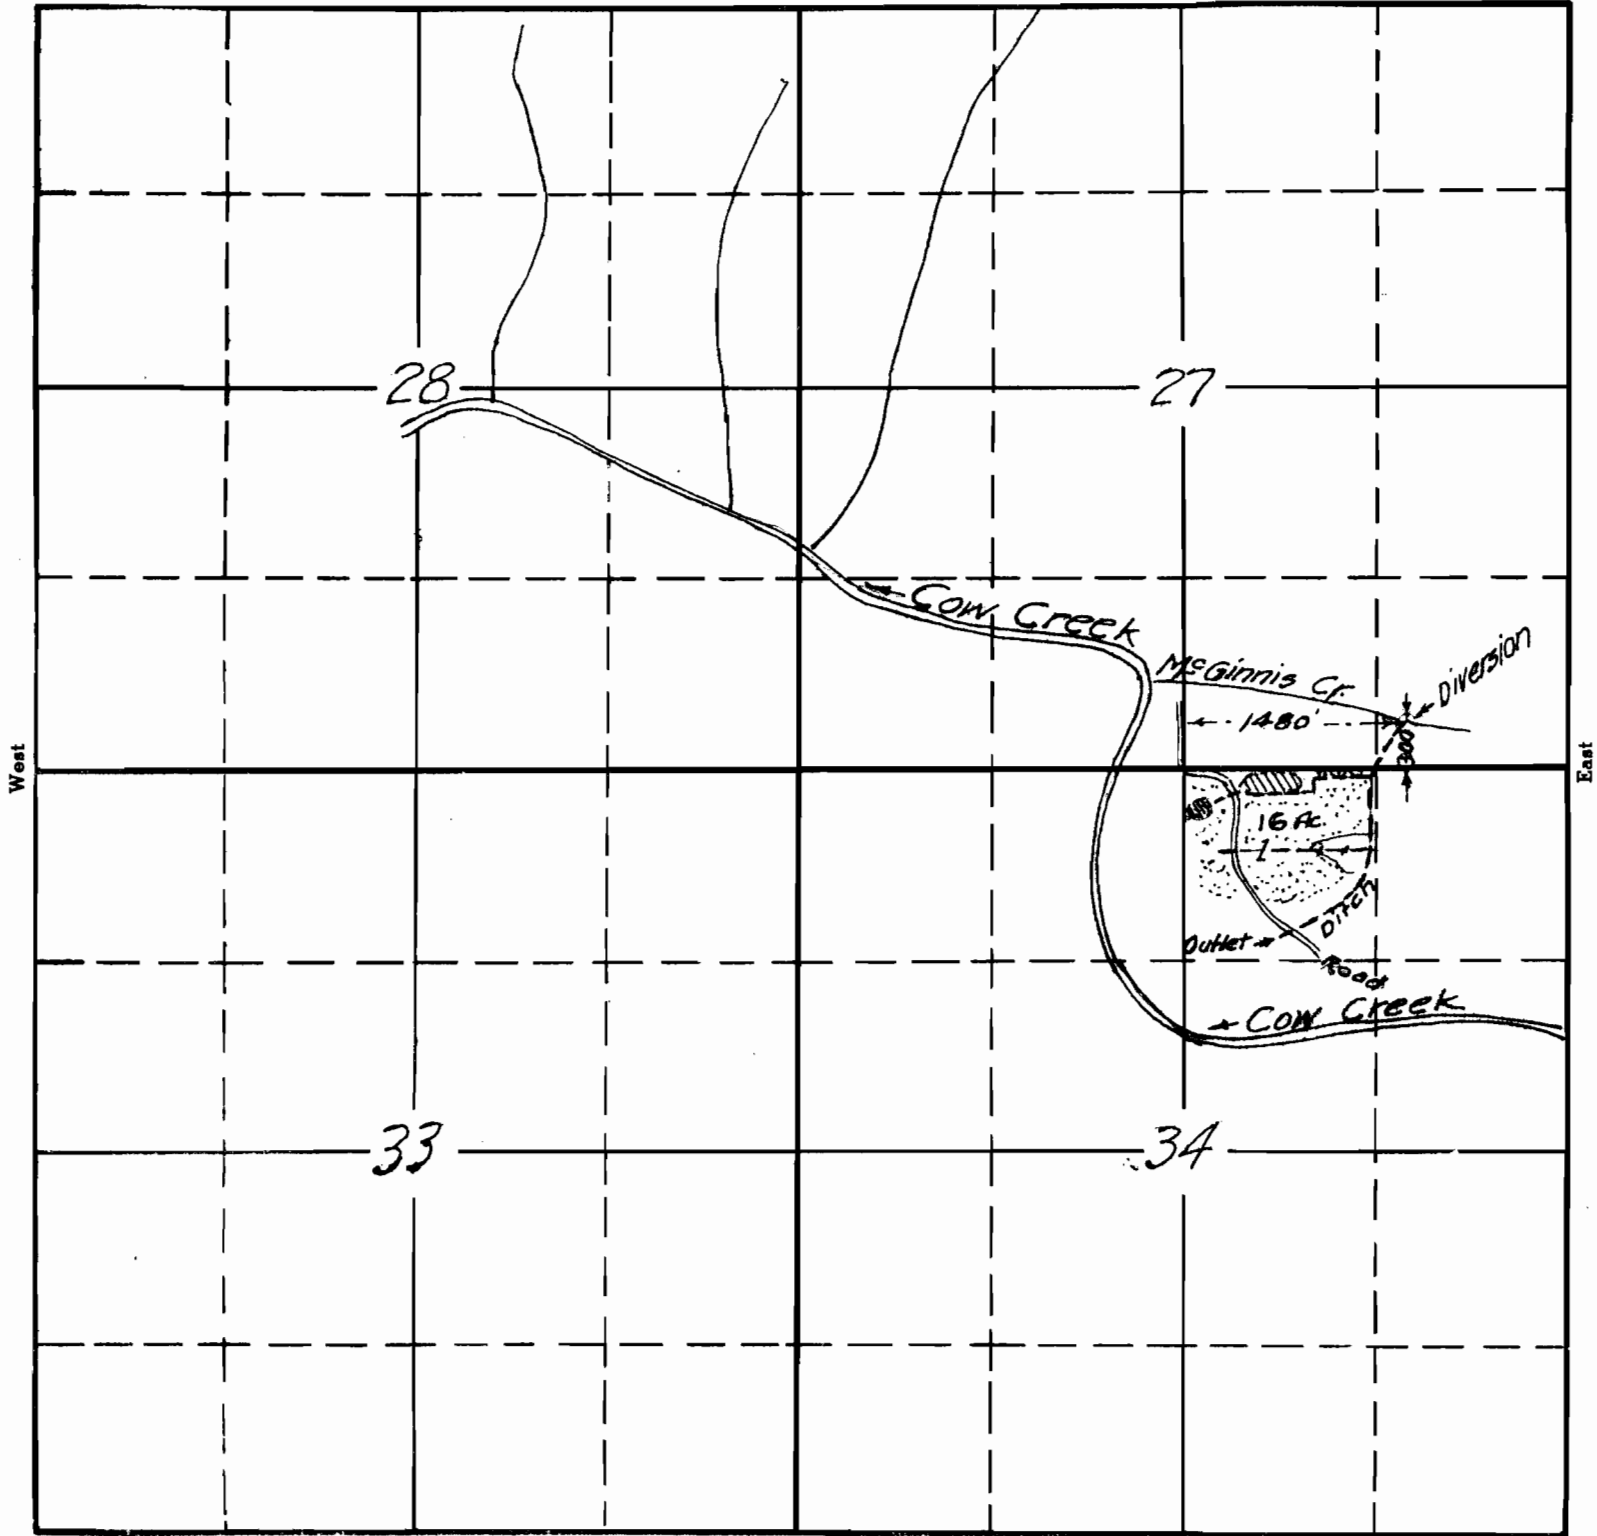

South

RECEIVED

MAR 24 1938

STATE ENGINEER
SALEM, OREGON

Oscar Head
March 1938

APPLICATION No. 17274
PERMIT No. 12984

17274