


//

TOWNSHIP 38 S, RANGE 3 W, W. M.

North

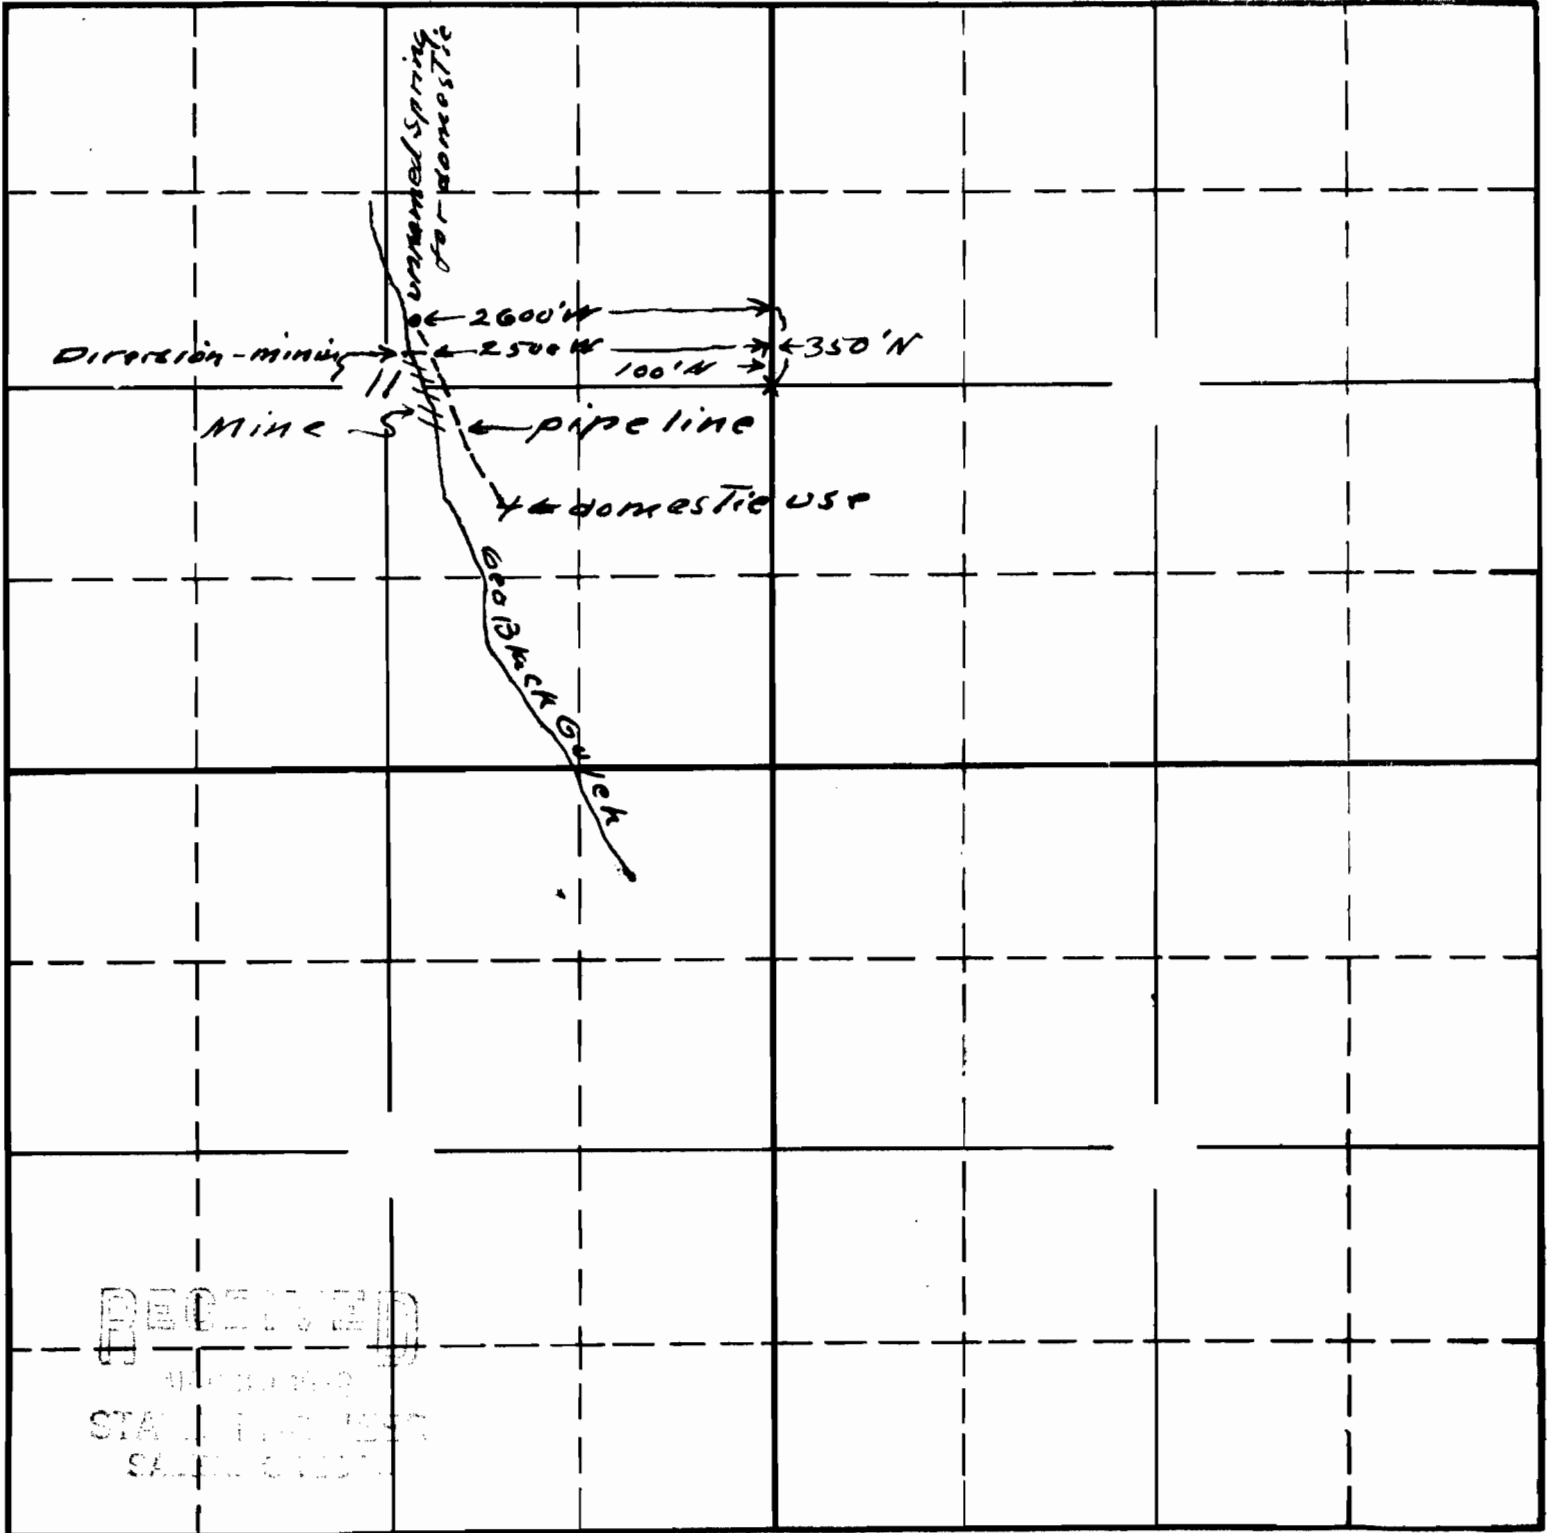

RECEIVED  

Sketch To accompany application of  
 Walter Armpriest for domestic use  
 and mining -  
 made from his measurements

APPLICATION No. 17279  
 PERMIT No. 12989

This office Mar 29 1938 *EA*

17279 (7)  
 15-16