


TOWNSHIP 35 S, RANGE 7 W, W. M.

35-7-11, 14

North

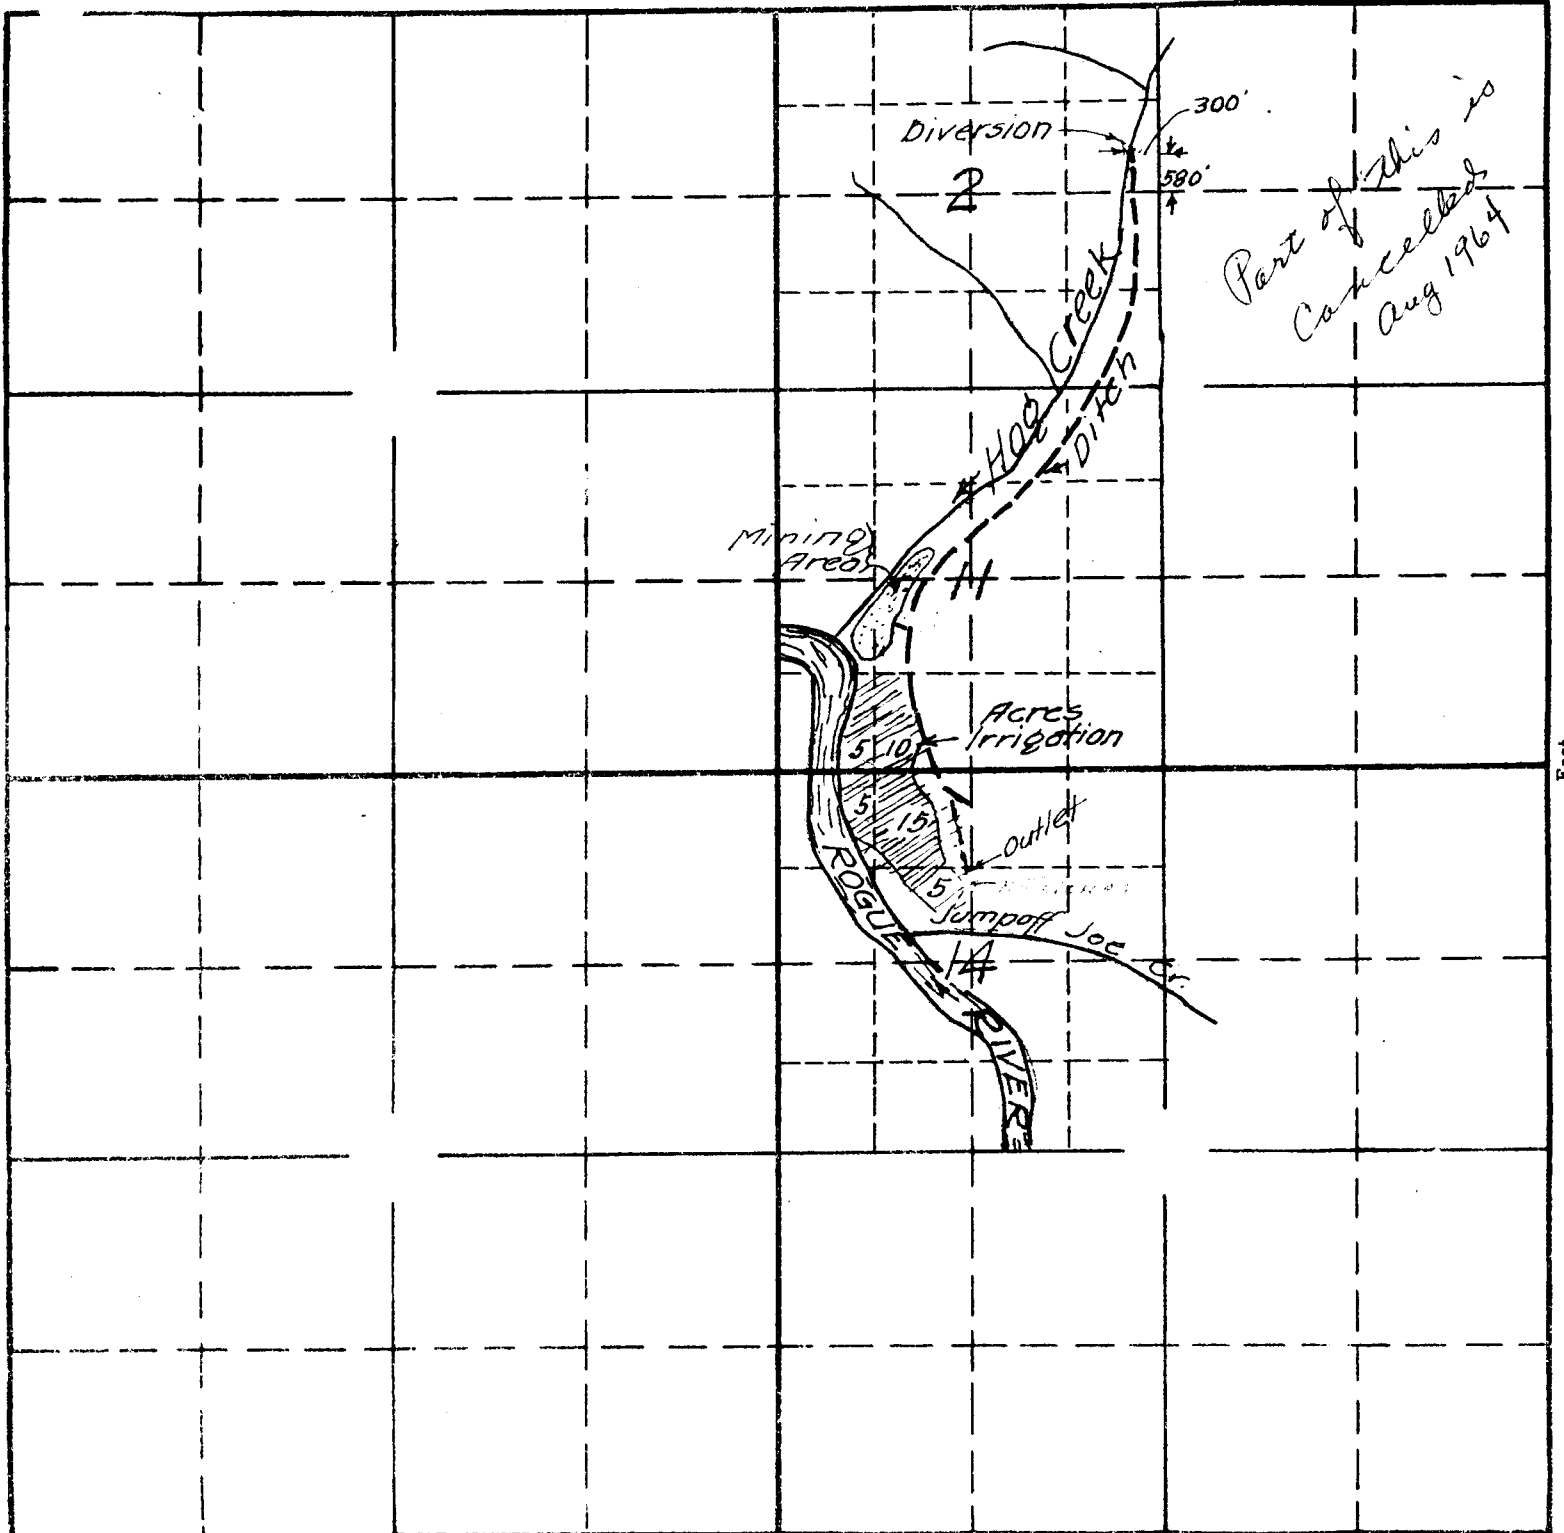

South

RECORDED  
 OF THE  
 STATE ENGINEER  
 COUNTY ENGINEER

Victor Olsen  
 April 1938

APPLICATION No. 17284  
 PERMIT No. 12992