


SECTION

TOWNSHIP 34S, RANGE 4W, W. M.

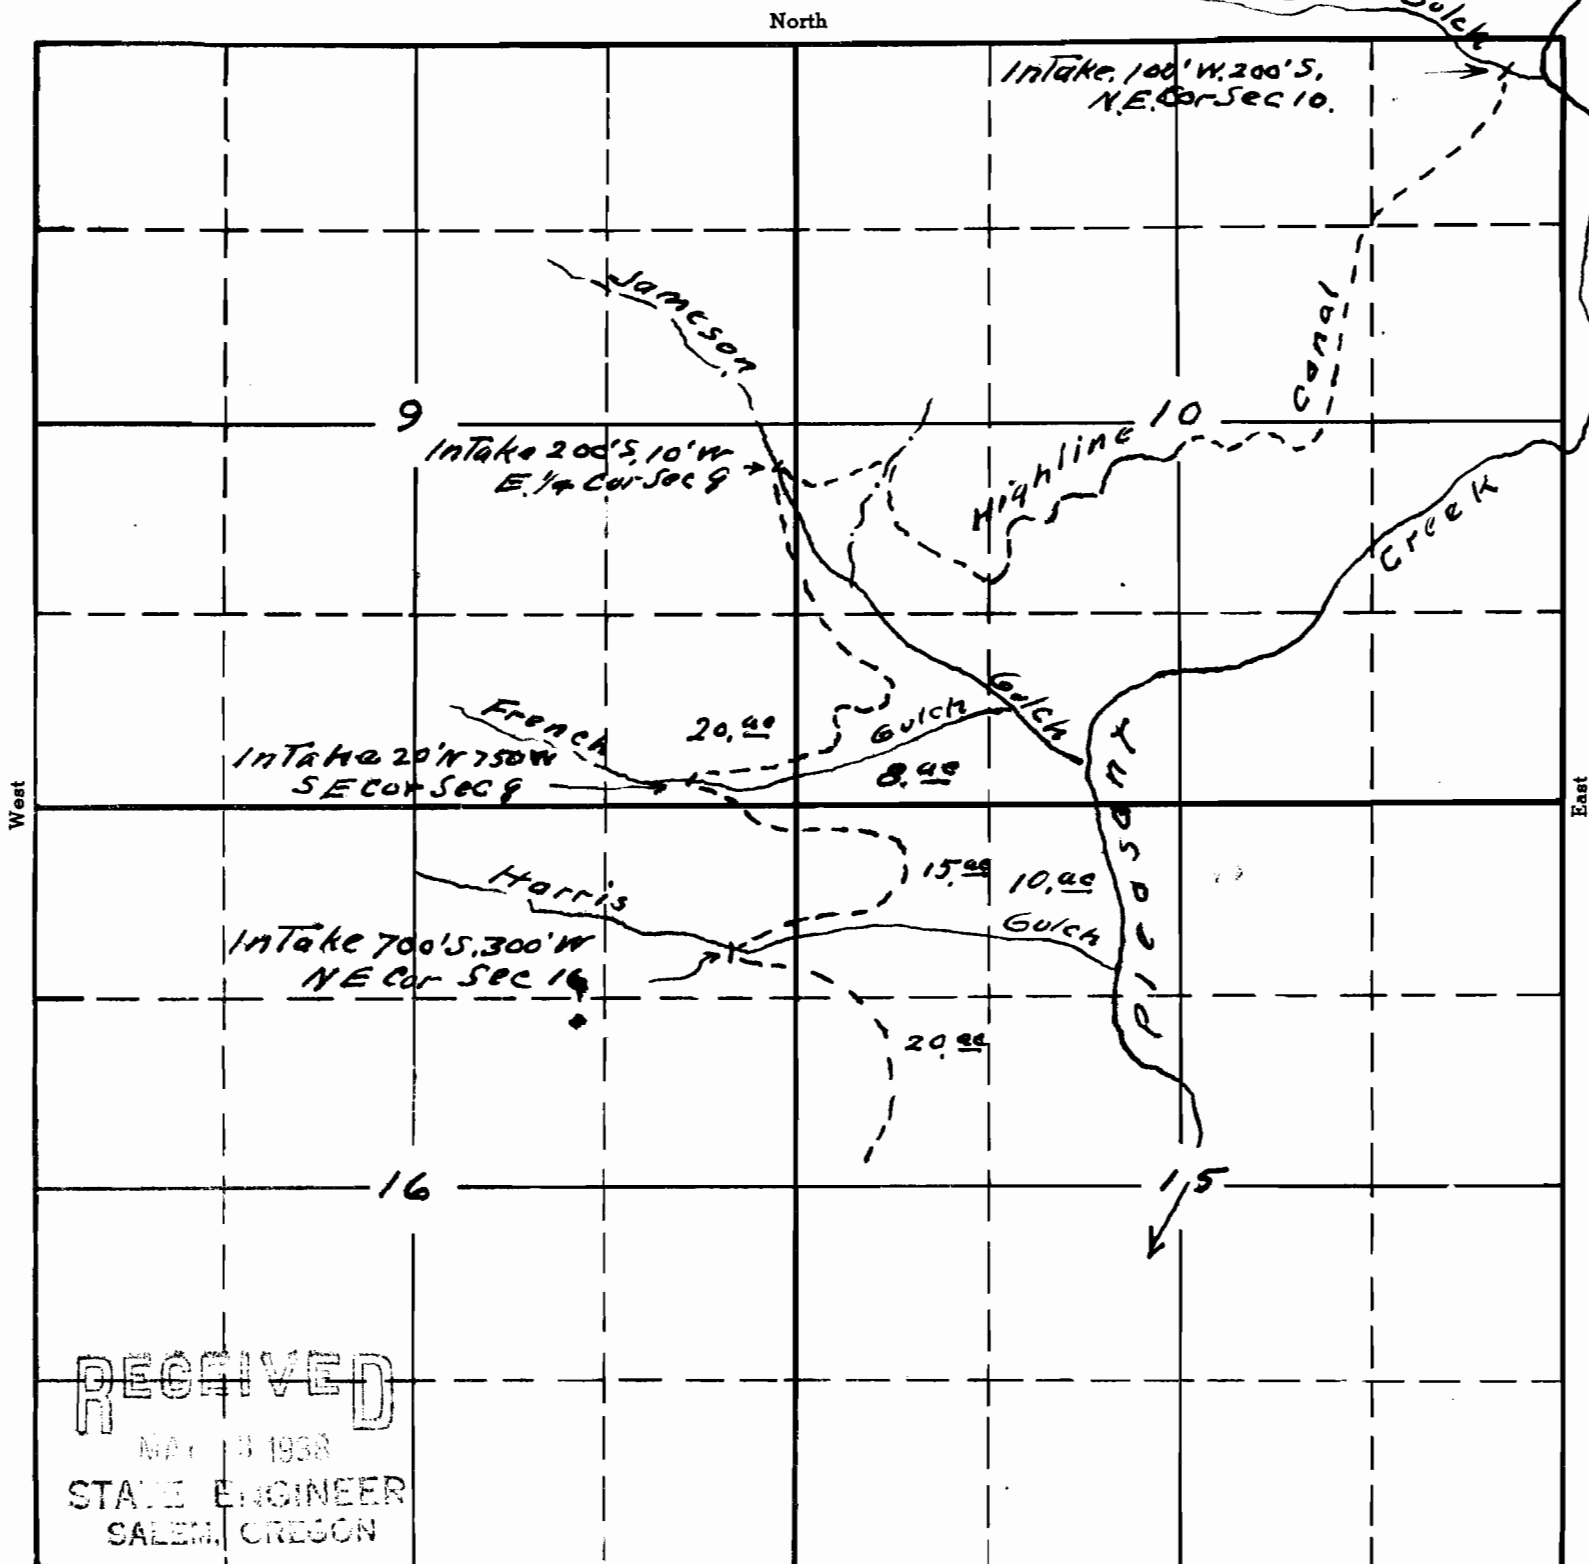

RECEIVED  
 MAY 15 1938  
 STATE ENGINEER  
 SALEM, OREGON

Sketch to accompany application of  
 Rosa Fischer - Successor to Lone Star  
 Mining Co. for the appropriation  
 of 16 c.f.s. of the waters of Pasture,  
 Jameson, French and Harris Gulches  
 for mining purposes. This office 7/27/38 *[Signature]*

APPLICATION No. 17311  
 PERMIT No. 13028