


28

TOWNSHIP 36 S, RANGE 2 W, W. M.

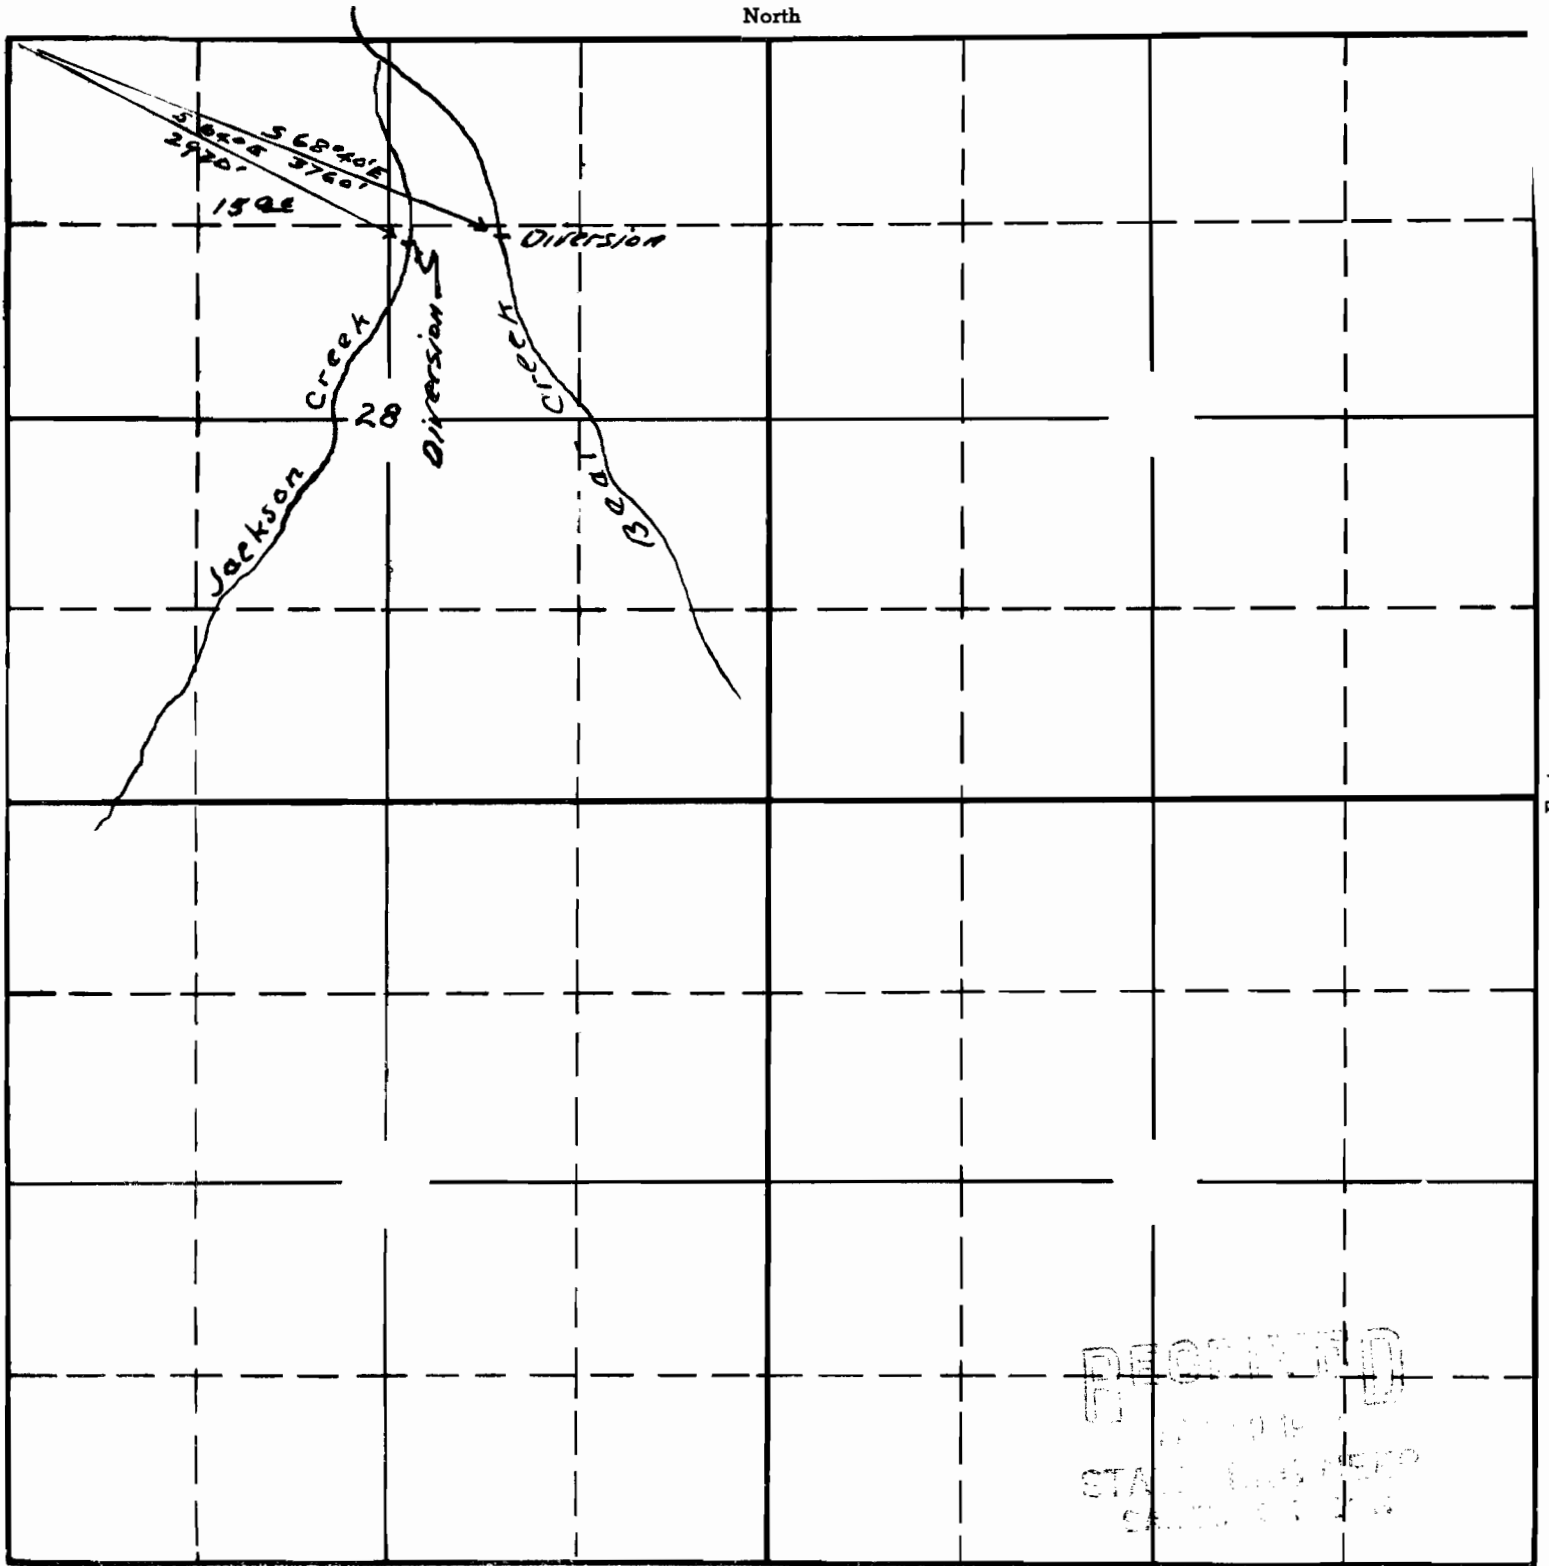

RECEIVED
 DIVISION OF
 STATE ENGINEERS

Sketch to accompany application of John S Owens for irrigation of 15 ac from Bear Cr and Jackson Cr - Being a subsequent right to R.R.V. 12 - Divisions corrected 5/18/35

APPLICATION No. 17312
 PERMIT No. 13029

This office 4/29/38 *[Signature]*