


SECTION

26  
27  
34  
35

TOWNSHIP 2N, RANGE 4W, W. M.

North

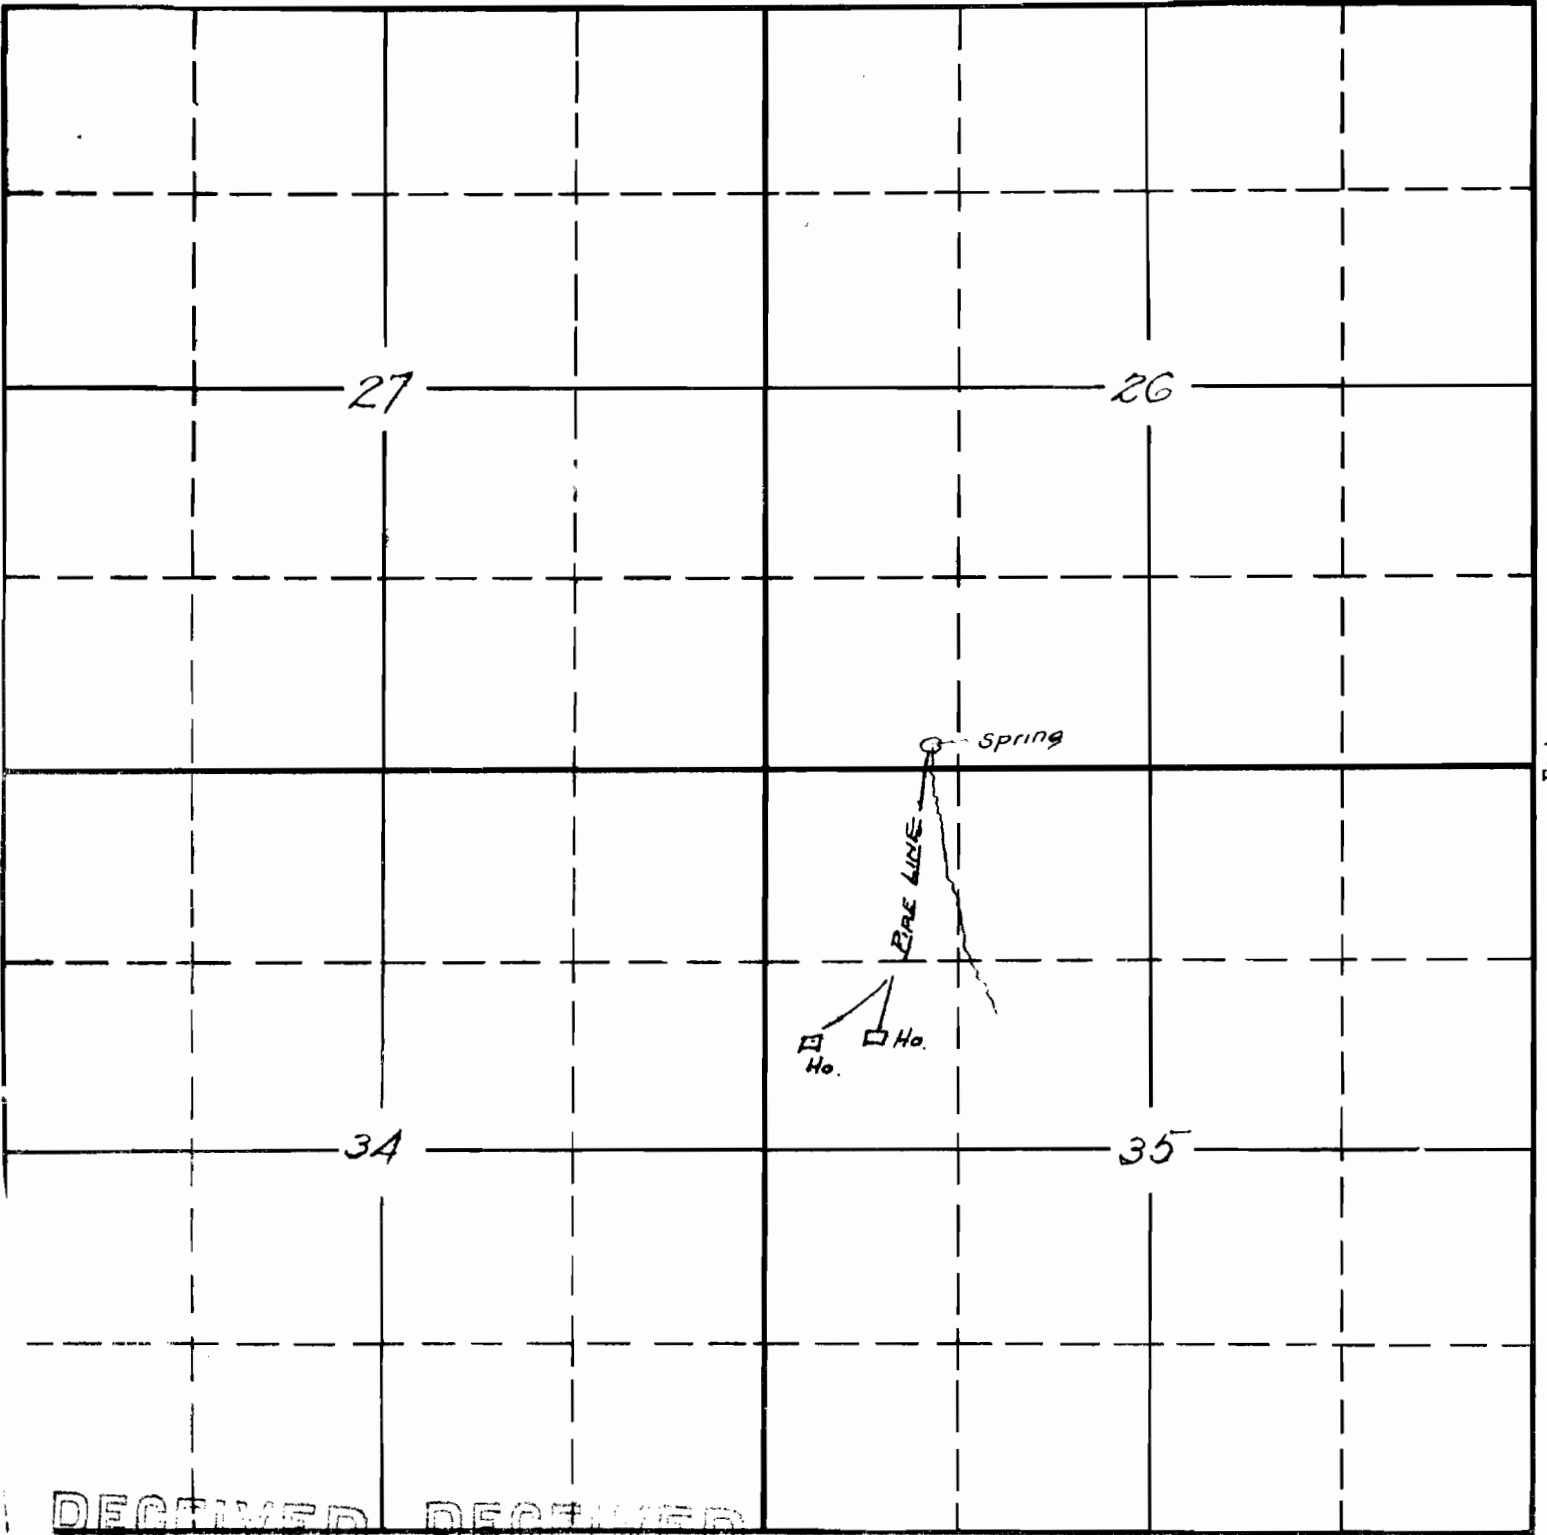

South

RECEIVED

RECEIVED

MAY 12 1938  
TALM ENGINEER  
SALEM, OREGON


MAY 12 1938  
STATE ENGINEER  
SALEM, OREGON

APPLICATION No. 17324  
PERMIT No. 13036

SECTION

TOWNSHIP 2 N , RANGE 4 W , W. M.

North

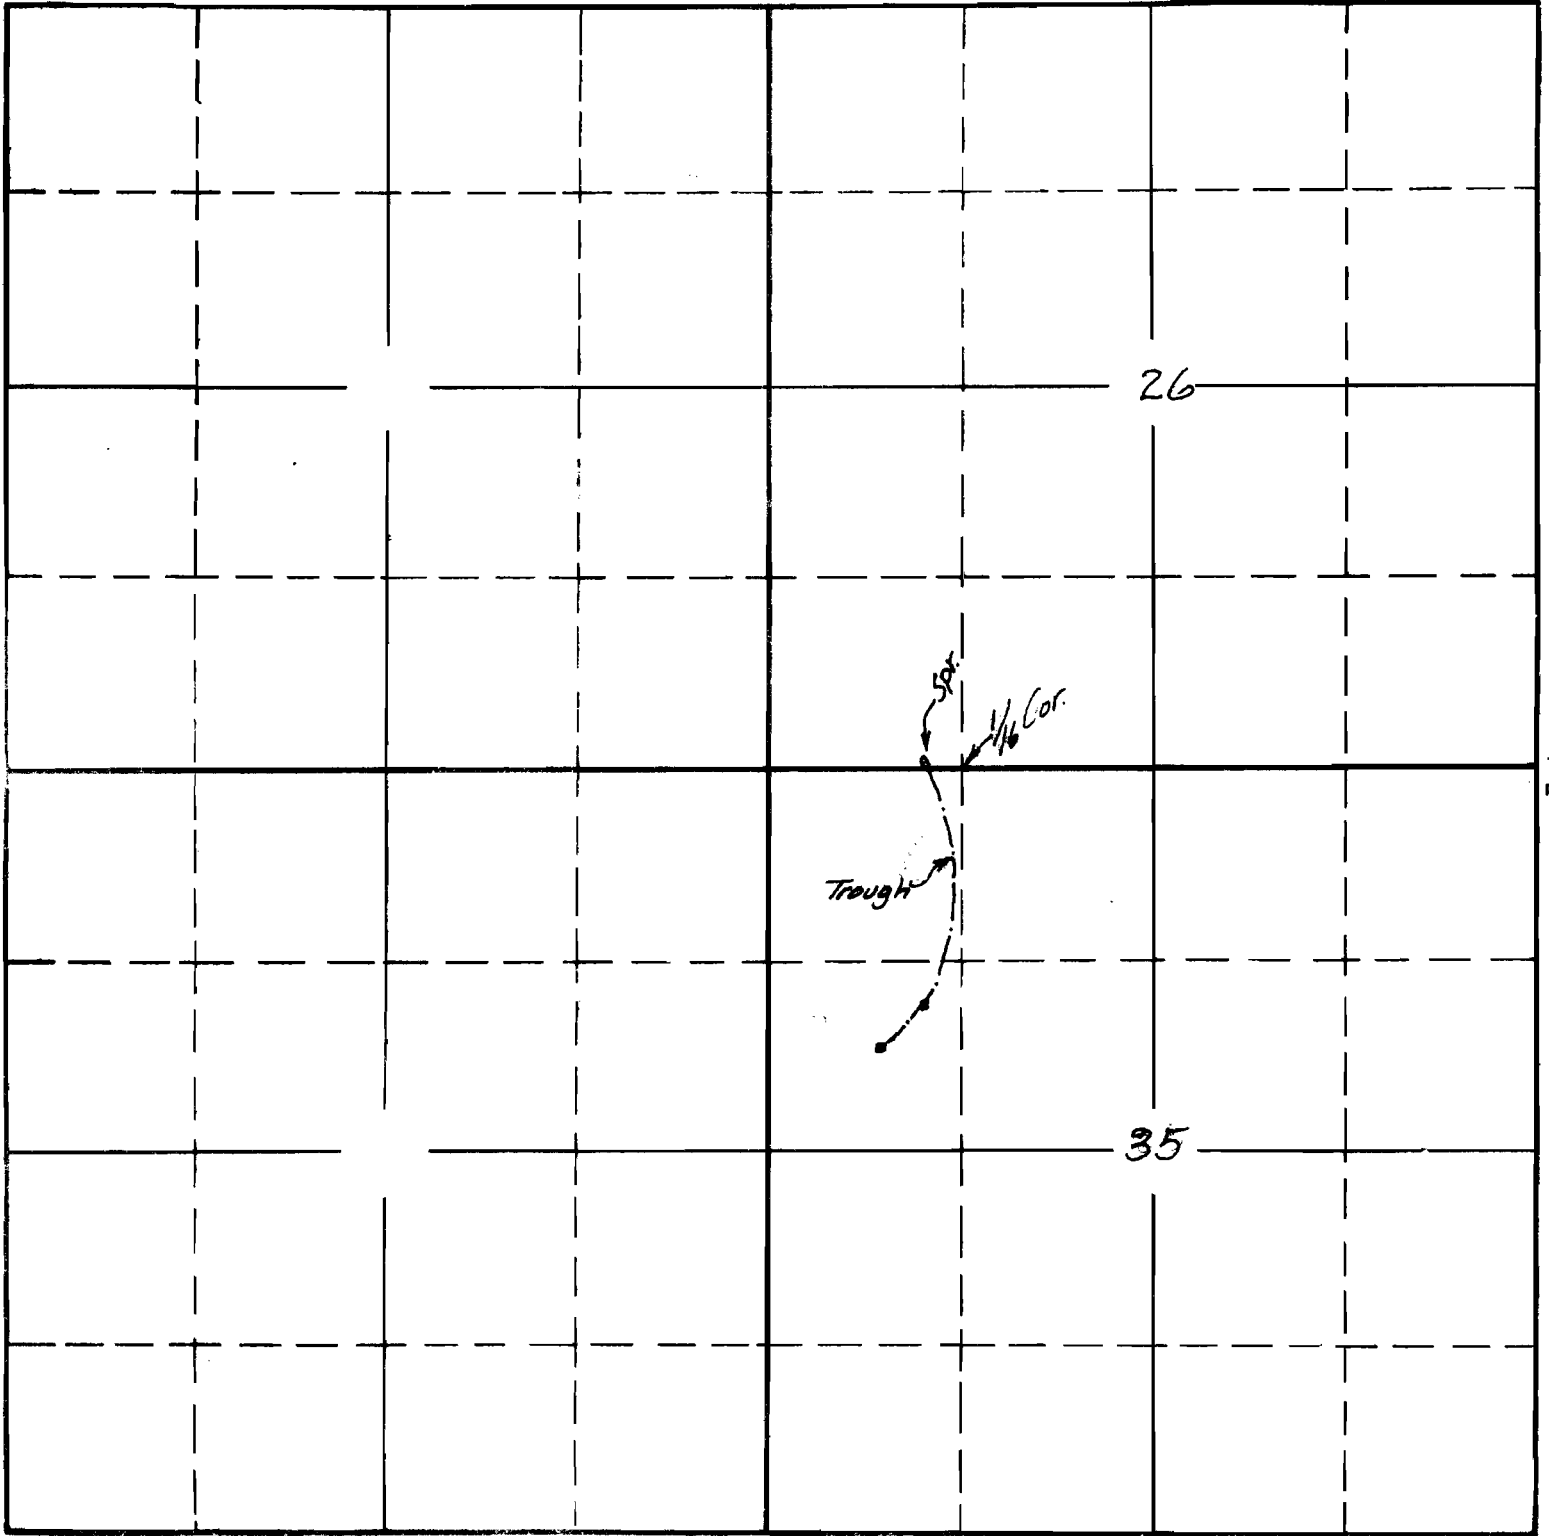

South

APPLICATION No. 17324

PERMIT No. 13039