


SECTION

TOWNSHIP 18 S, RANGE 3 W, W. M.

North

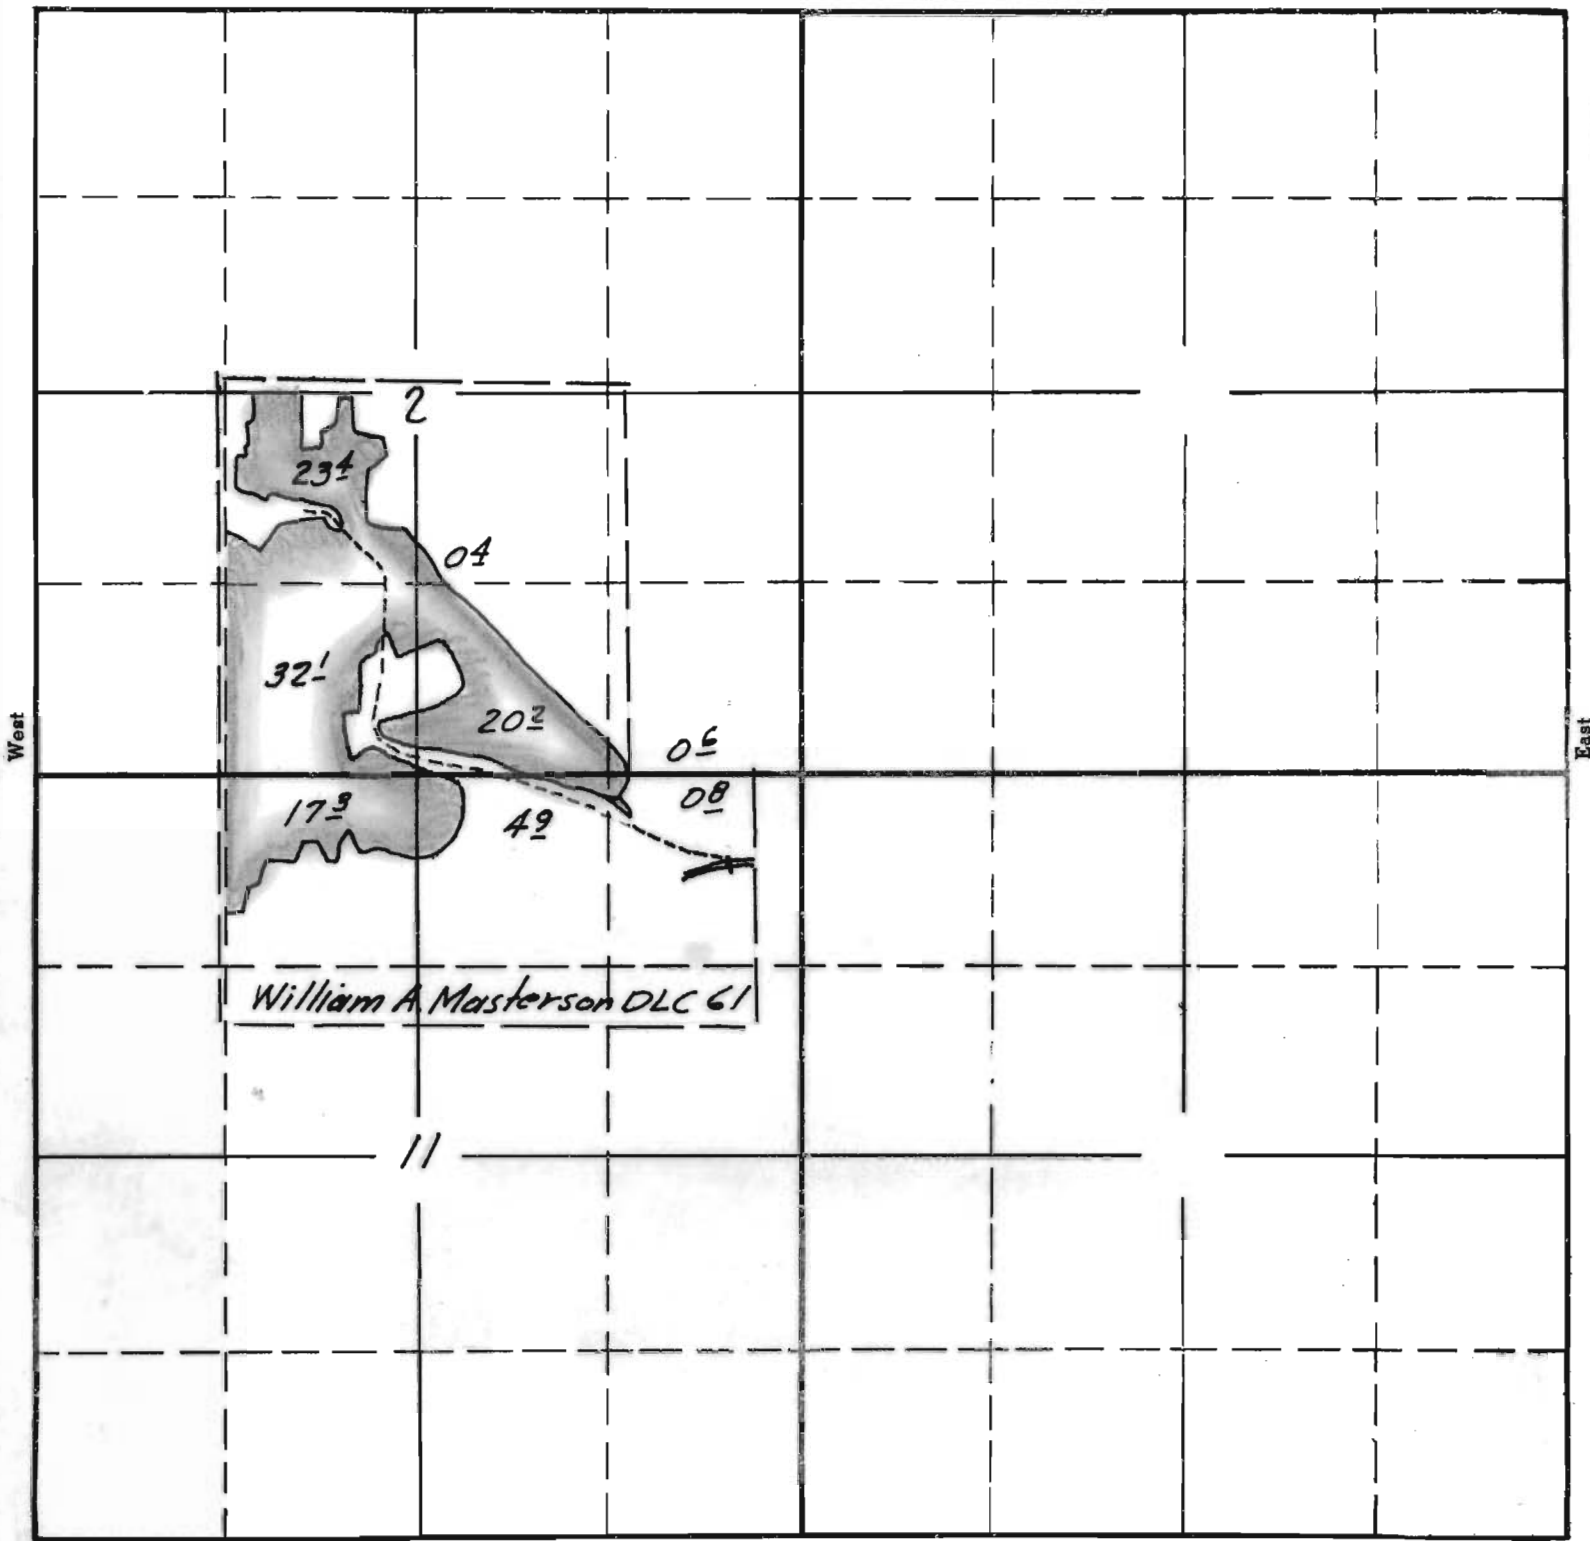

**FINAL PROOF SURVEY**

South

UNDER

Application No. 17327 Permit No. 13041

IN NAME OF

Ben F. Darris

Surveyed \_\_\_\_\_ 19\_\_\_\_, by \_\_\_\_\_

APPLICATION No.

PERMIT No.


11

2

11

TOWNSHIP 18 S , RANGE 3 W , W. M.

North

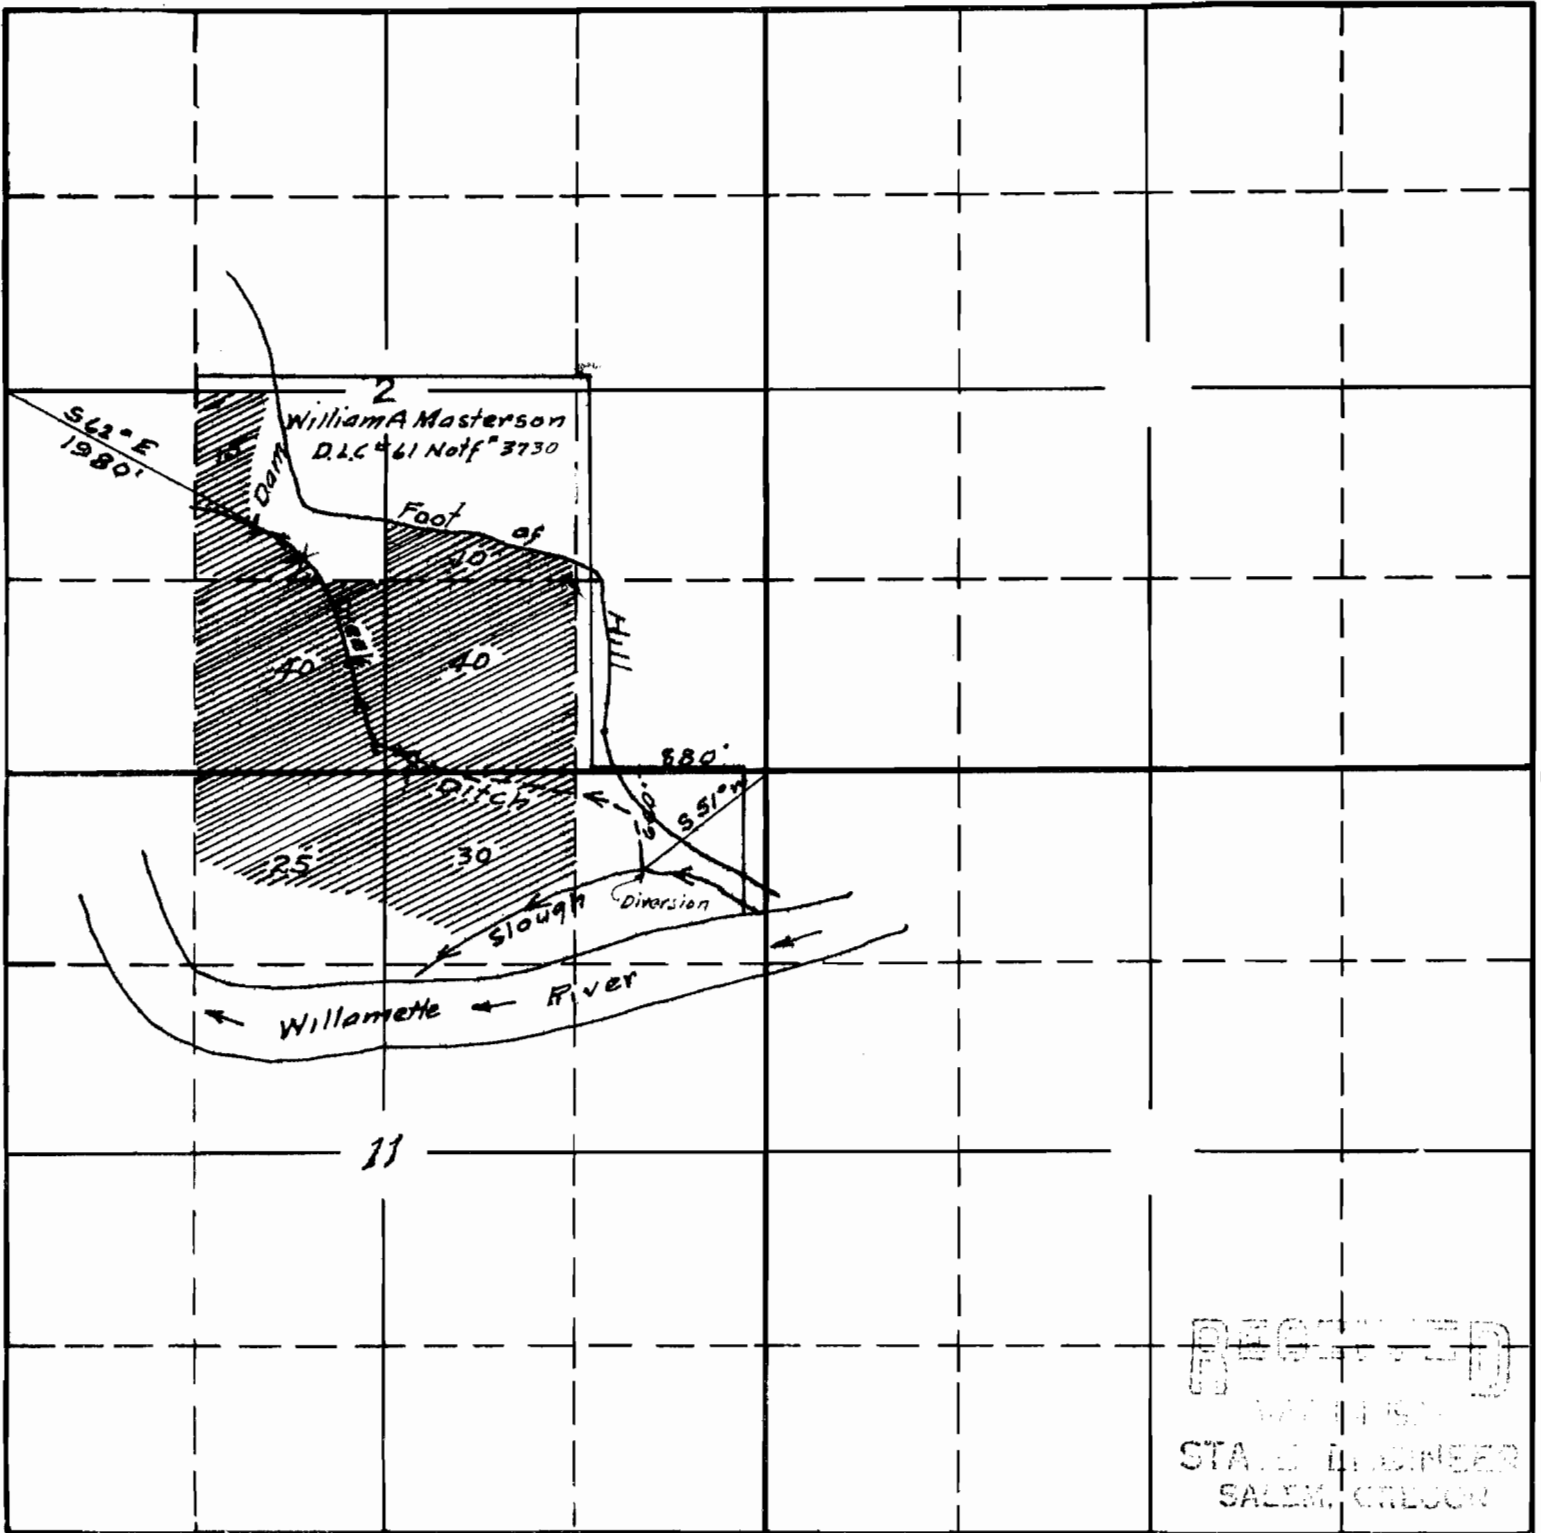

RECEIVED  
 STATE ENGINEER  
 SALEM, OREGON

South

APPLICATION No. 17327  
 PERMIT No. 13041