


SECTION

TOWNSHIP 33 S, RANGE 4 W, W. M.

North

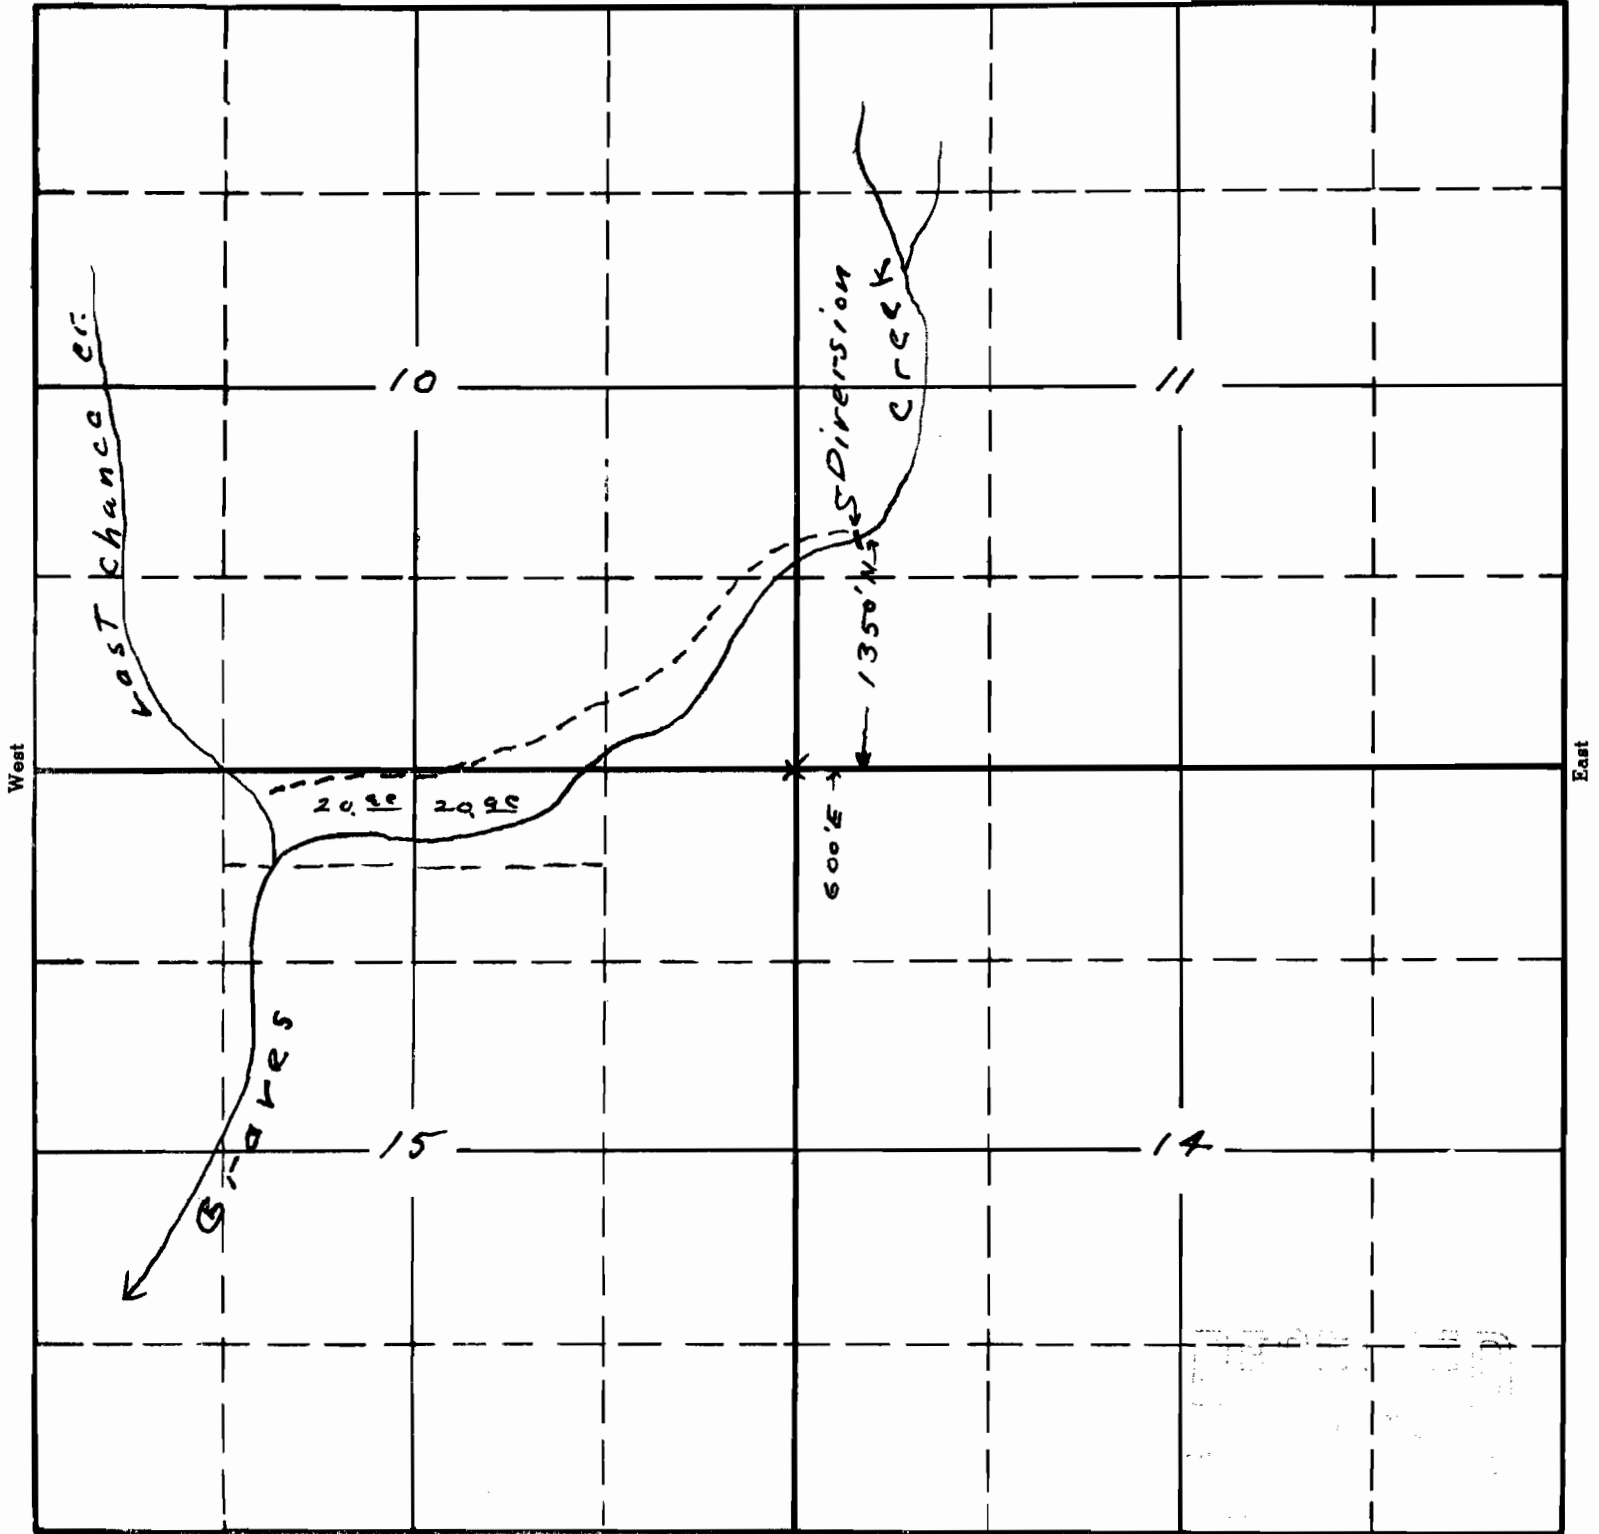

Sketch showing location of diversion
and place of use for application of
H. Mossor for mining on Geraves Creek
made from his map made in the field
from actual measurements

1736-2-1735
15-40
APPLICATION No. 17362
PERMIT No. 13069

This office 6/9/35 J.S.