


SECTION

22

TOWNSHIP 35, RANGE 40E, W. M.

North

N. E. CORNER

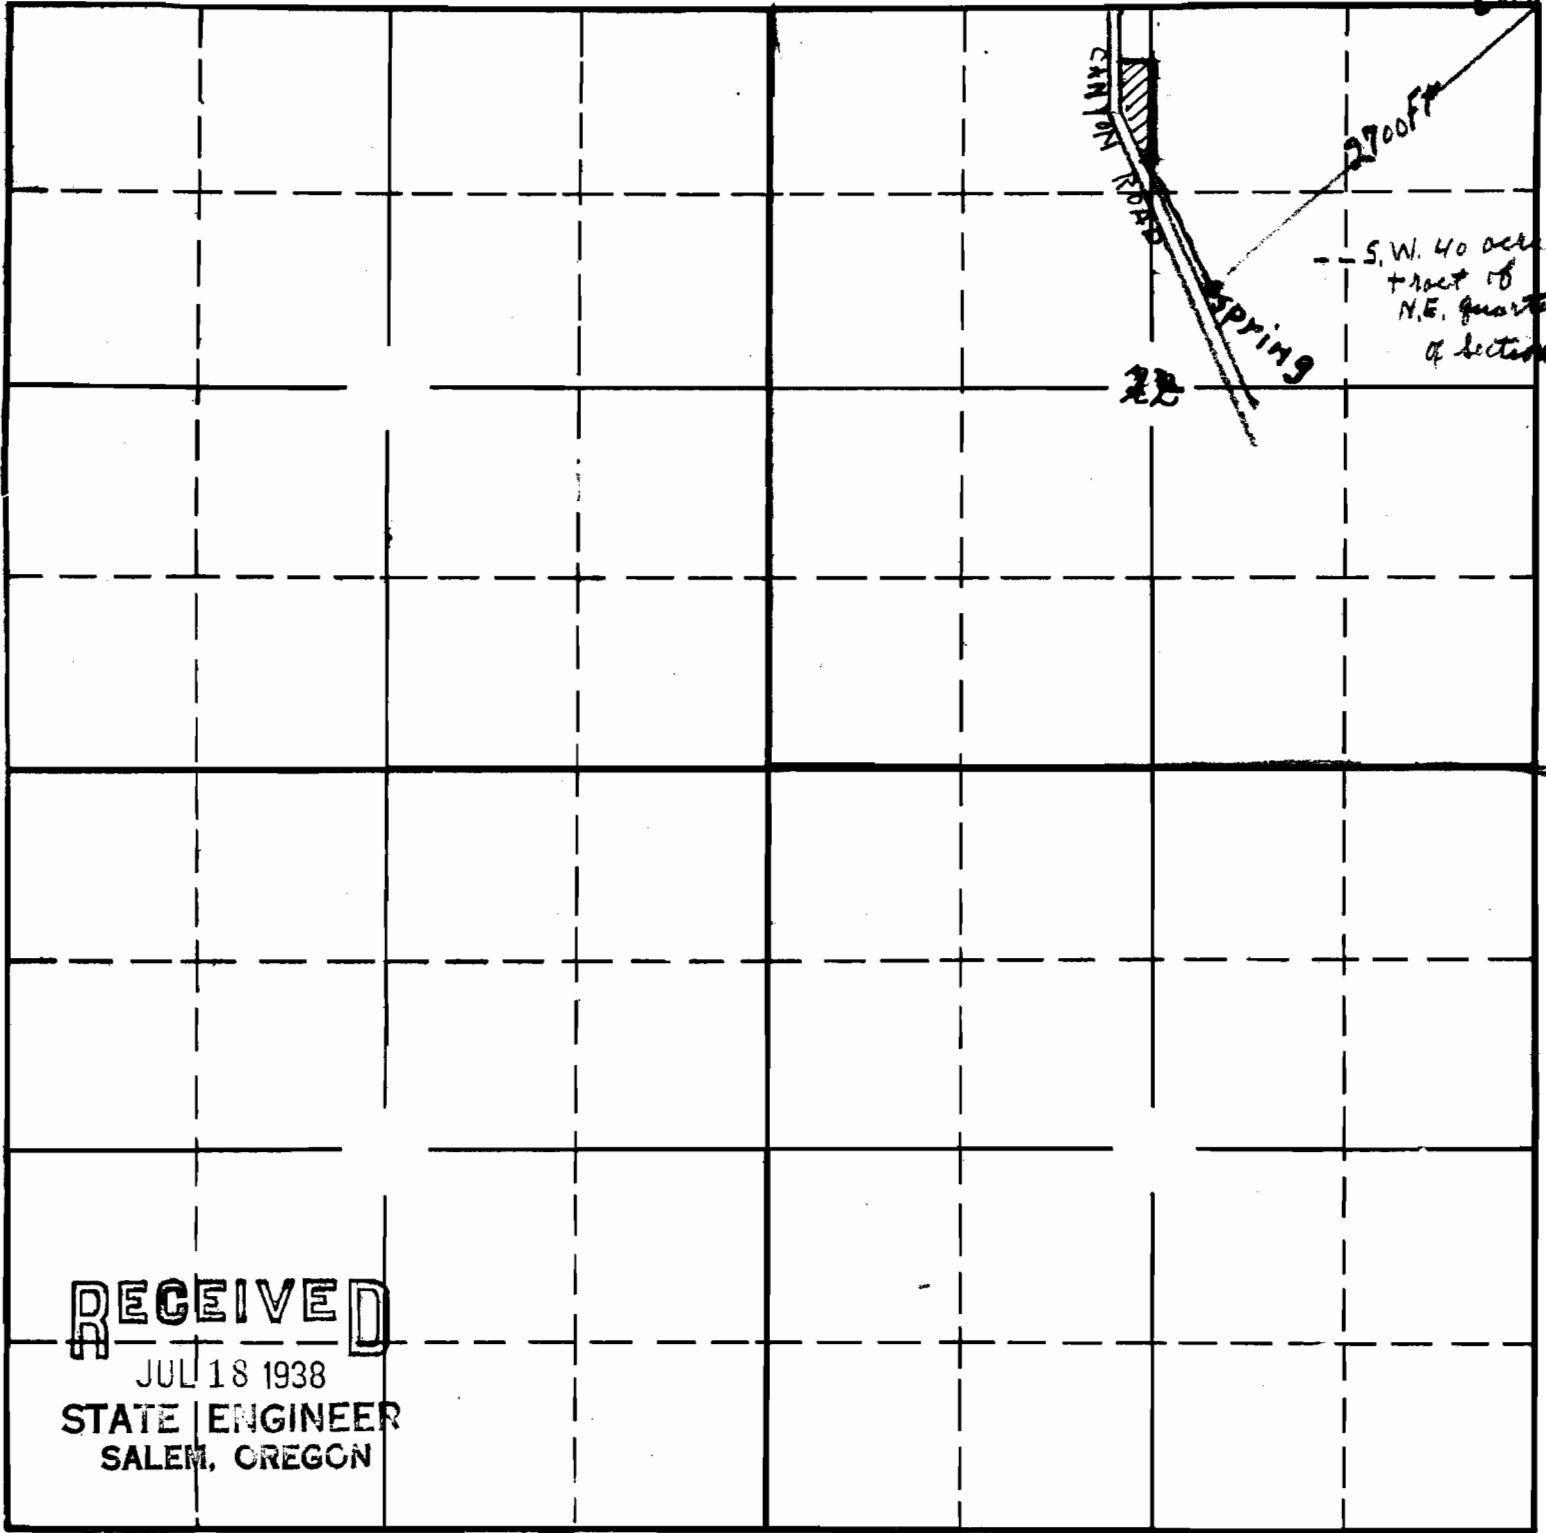

RECEIVED

JUL 18 1938

STATE ENGINEER
SALEM, OREGON

RECEIVED

JUL 2 - 1938

STATE ENGINEER
SALEM, OREGON

South

17367 R

8-7
APPLICATION No. 17367
PERMIT No. 13072