


T. 40 S., R. 9 W., W. M.
Scale 4" = 1 Mile June 1938

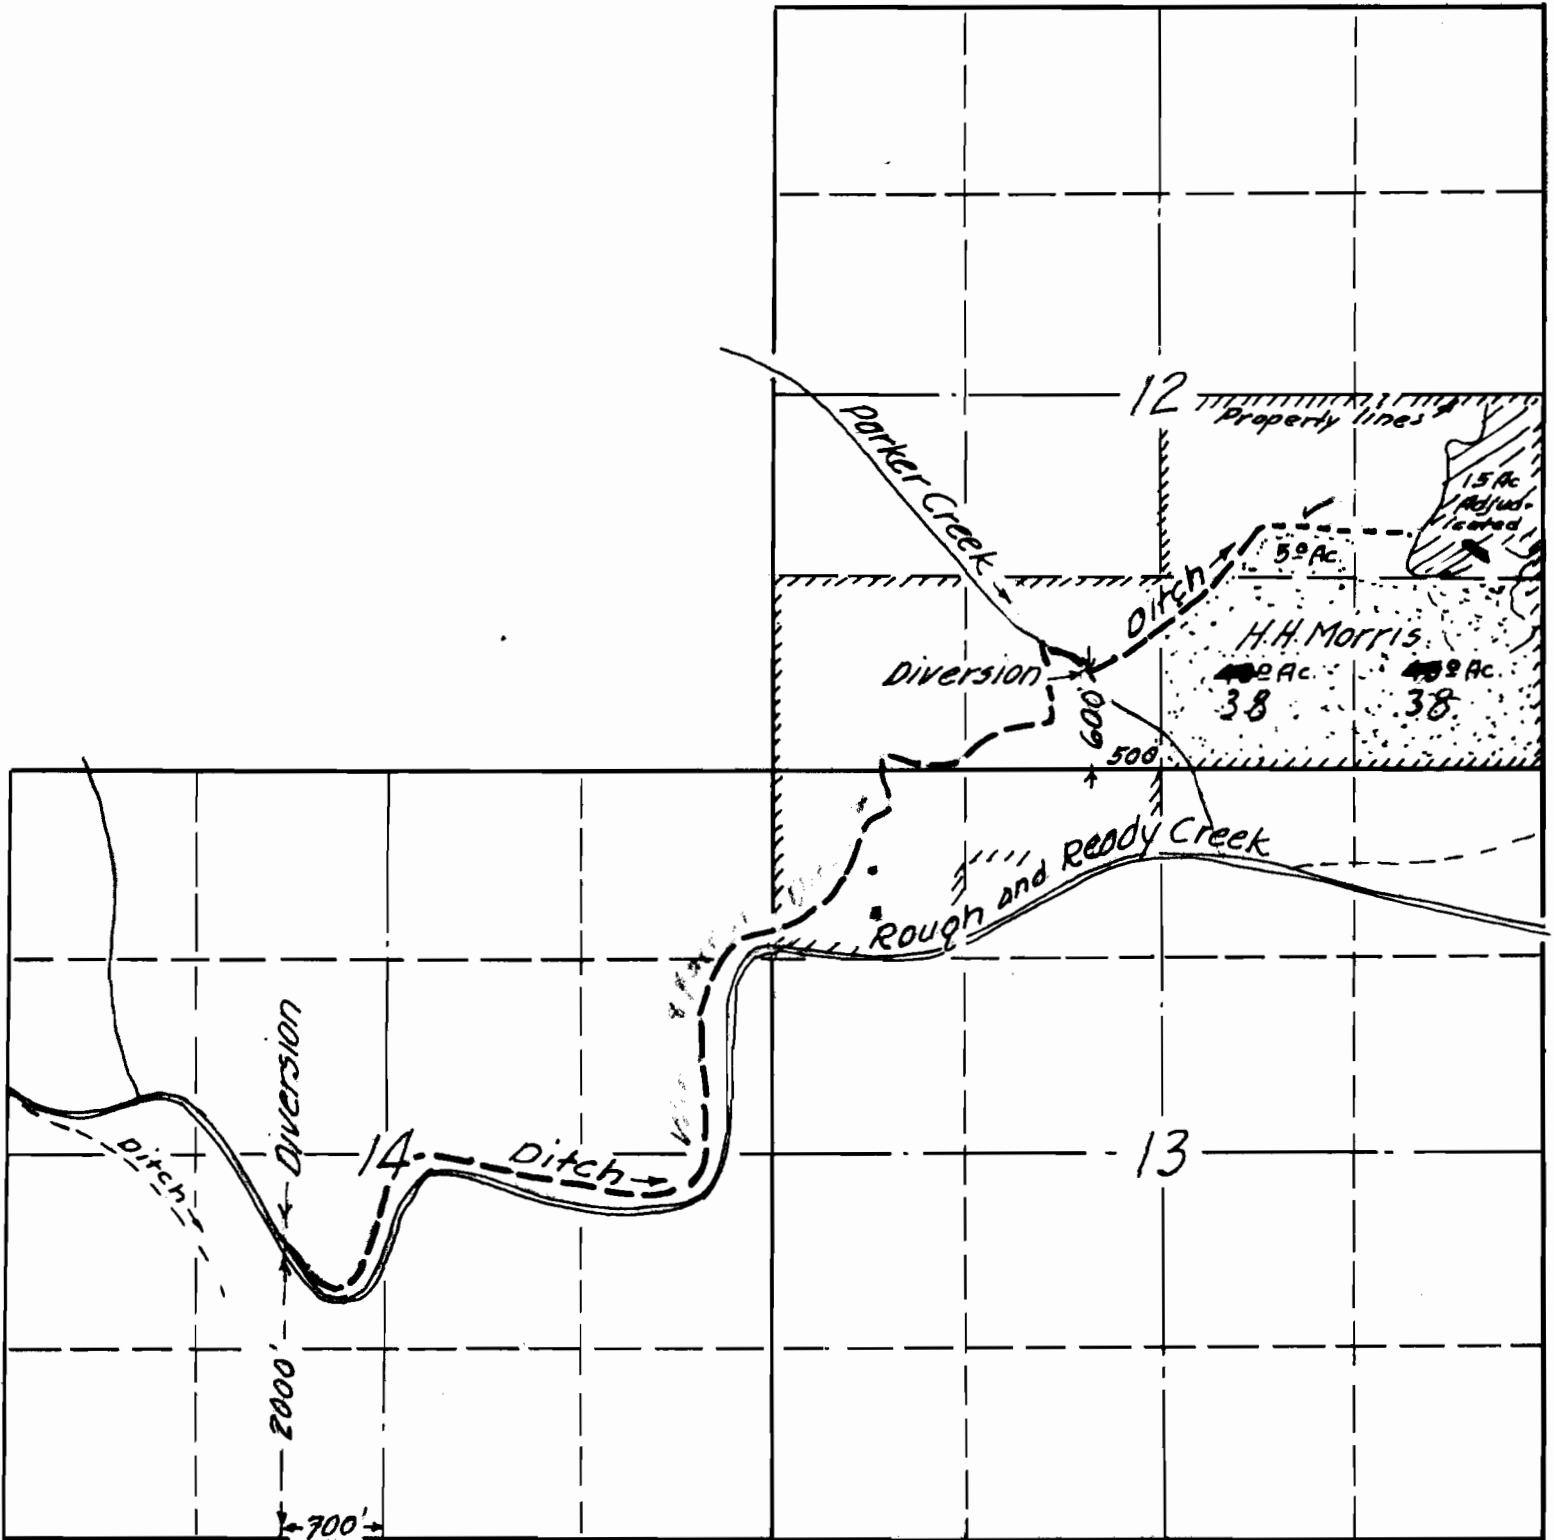

Application No. 17379
Permit No. 13080

STATE ENGINEER
