


SECTION

70

TOWNSHIP 37 S, RANGE 3 W, W. M.

North

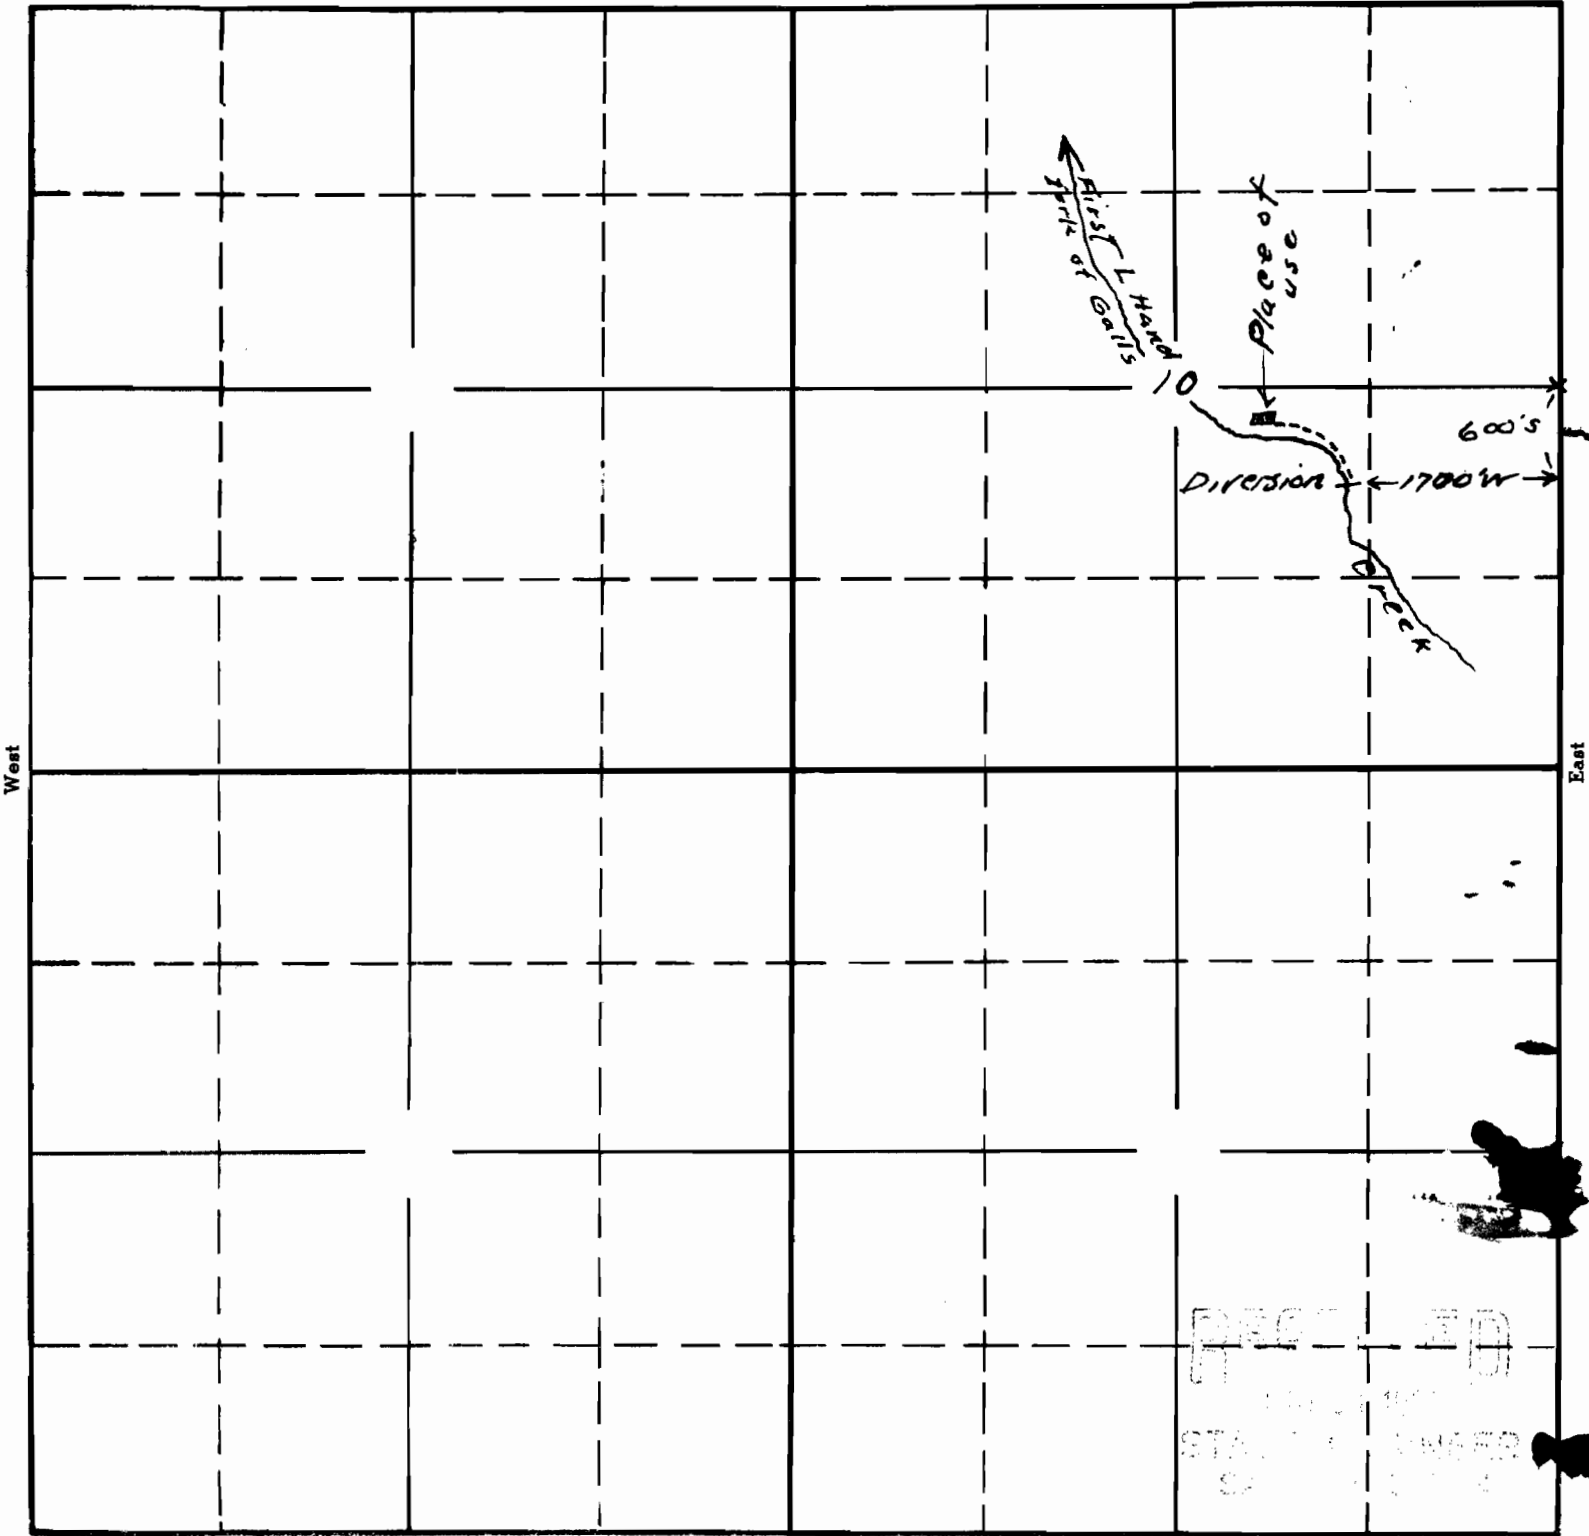

Sketch from measurements furnished by E.S. & C.R. Dalton showing diversion and place of use; to accompany application for permit to use waters of the first left hand fork of Gealls Creek, Trib Rogue River for mill pond.

1575  
APPLICATION No. 17381  
PERMIT No. 13082

This office 9/18/35 C.F.S.