


TOWNSHIP 45, RANGE 1W, W. M.

North

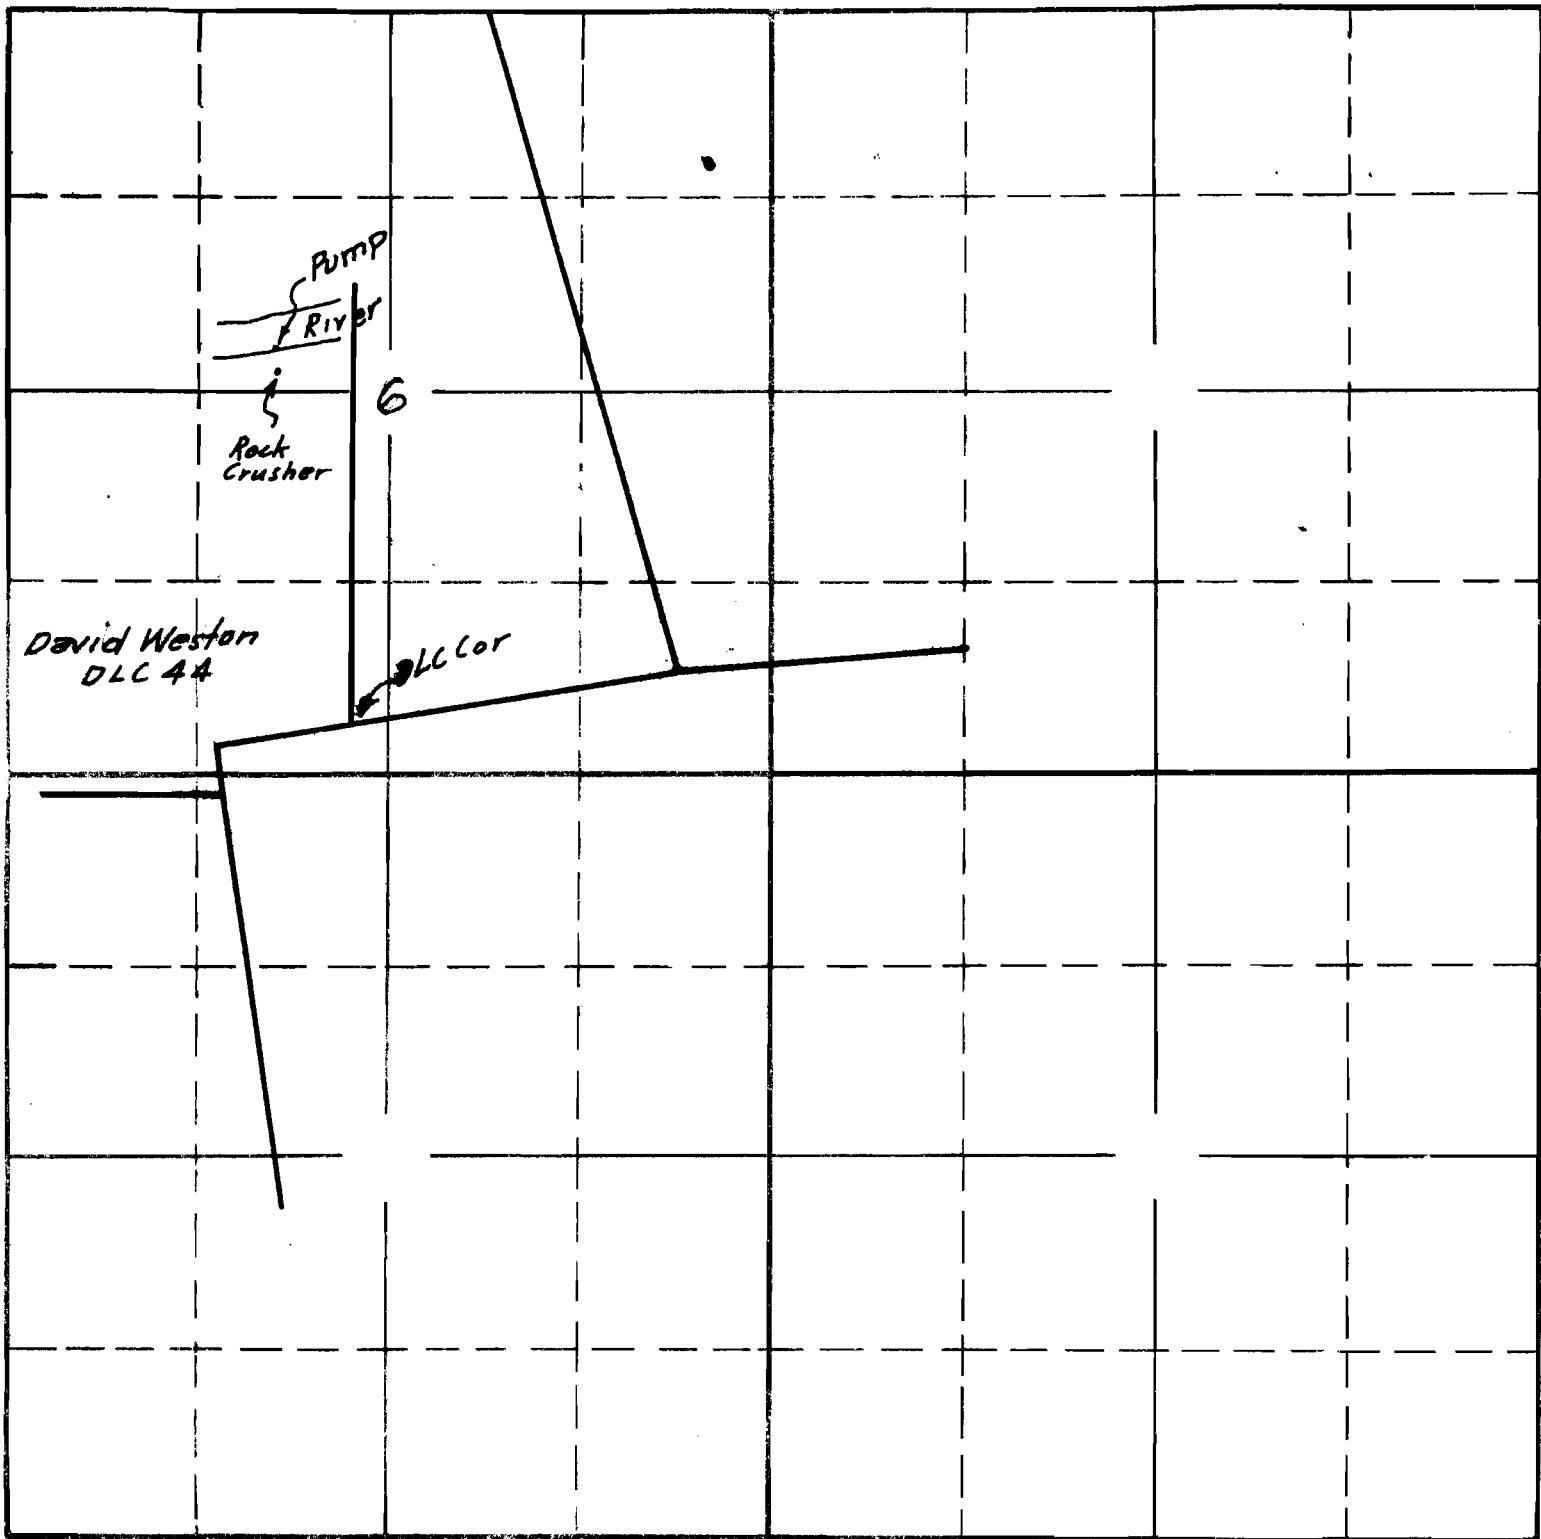

David Weston
DLC 4A

PUMP
River
Rock
Crusher

G

DLC Cor

Surveyed April 13 1939
by C.A.C.

South


APPLICATION No. 17382
PERMIT No. 13083

SECTION

6

TOWNSHIP 45, RANGE 1W, W. M.

North

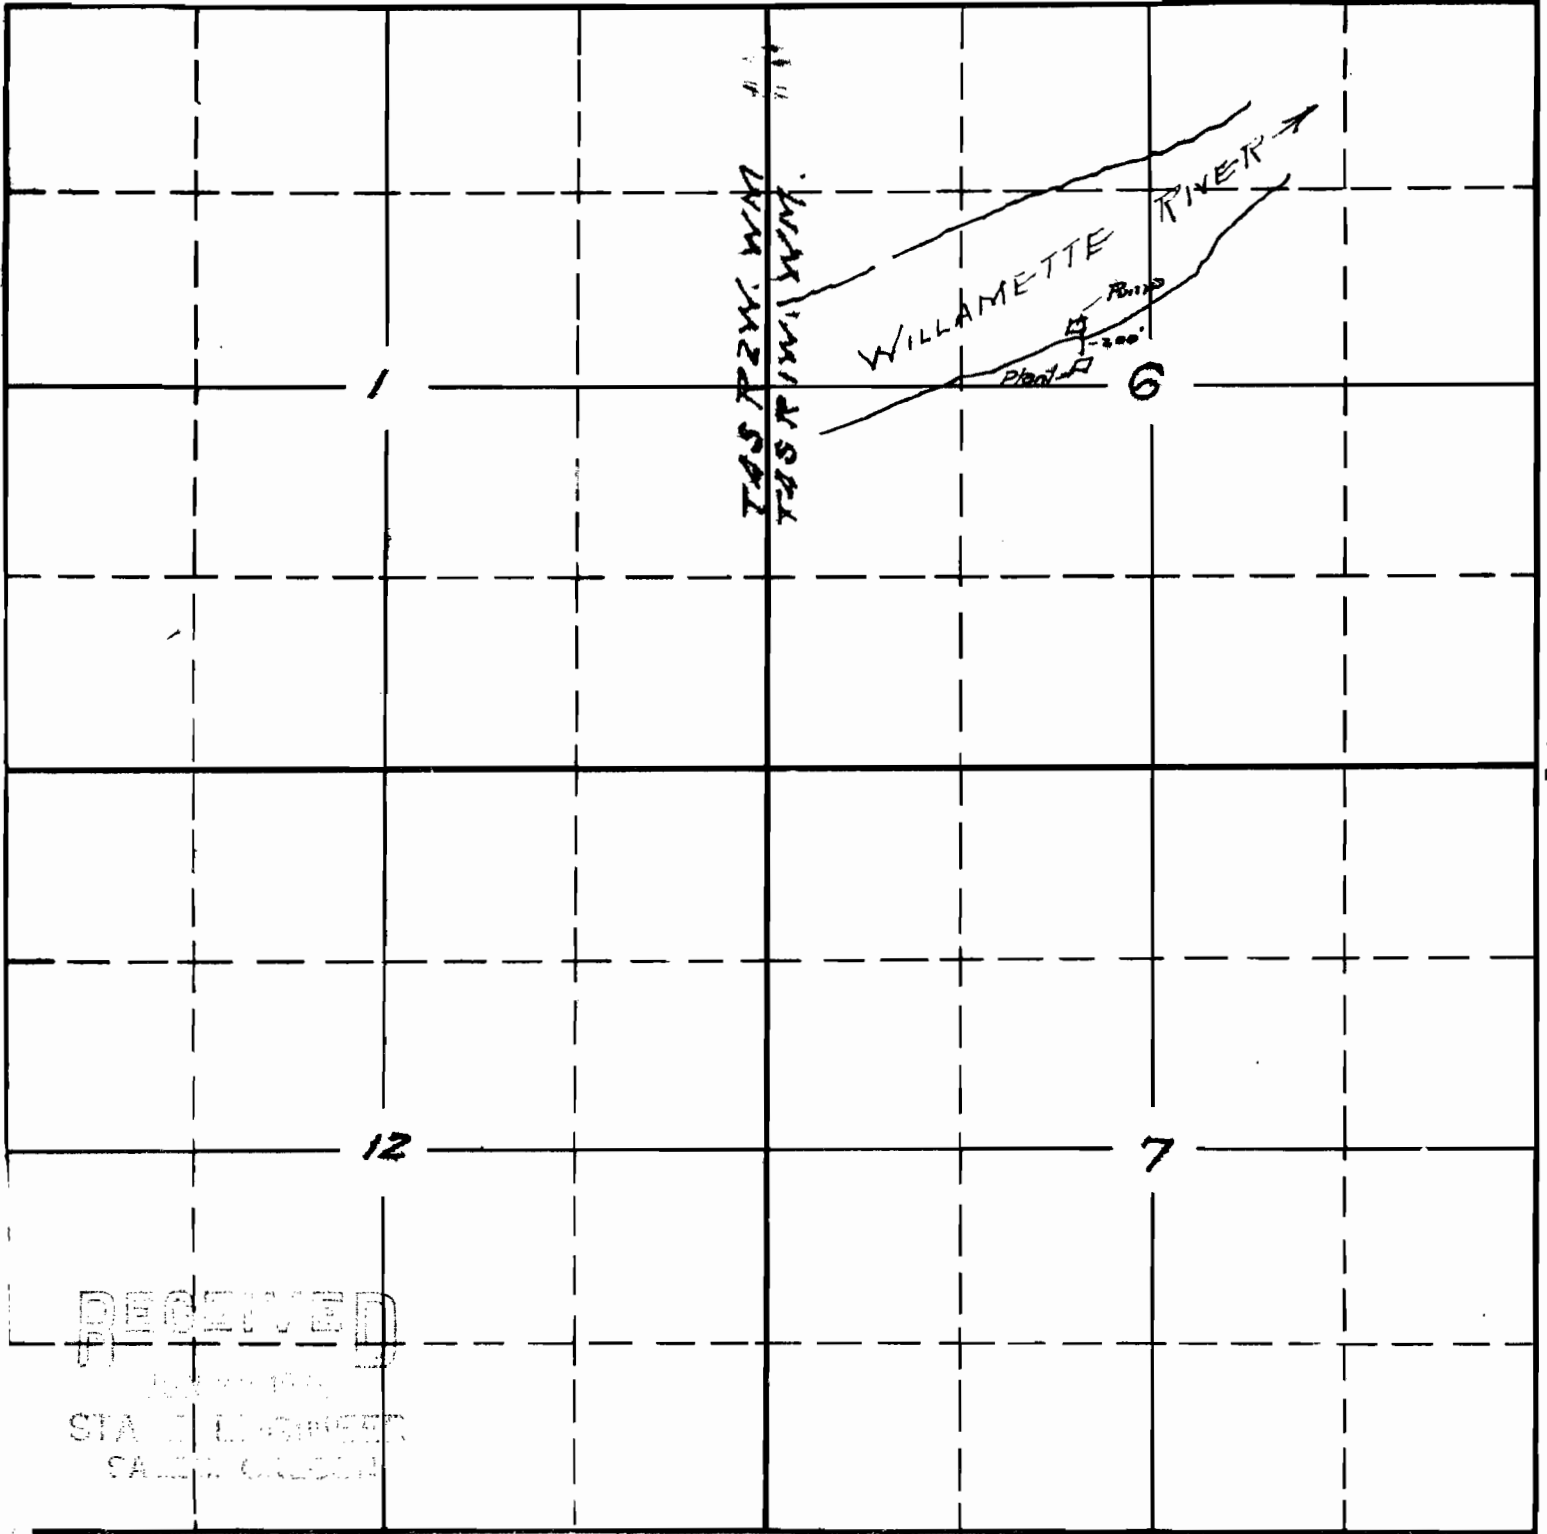

RECEIVED

STATE ENGINEER

South

11.22.05
200

APPLICATION No. 17382
PERMIT No. 13083