


SECTION

TOWNSHIP 37 S, RANGE 4 W, W. M.

North

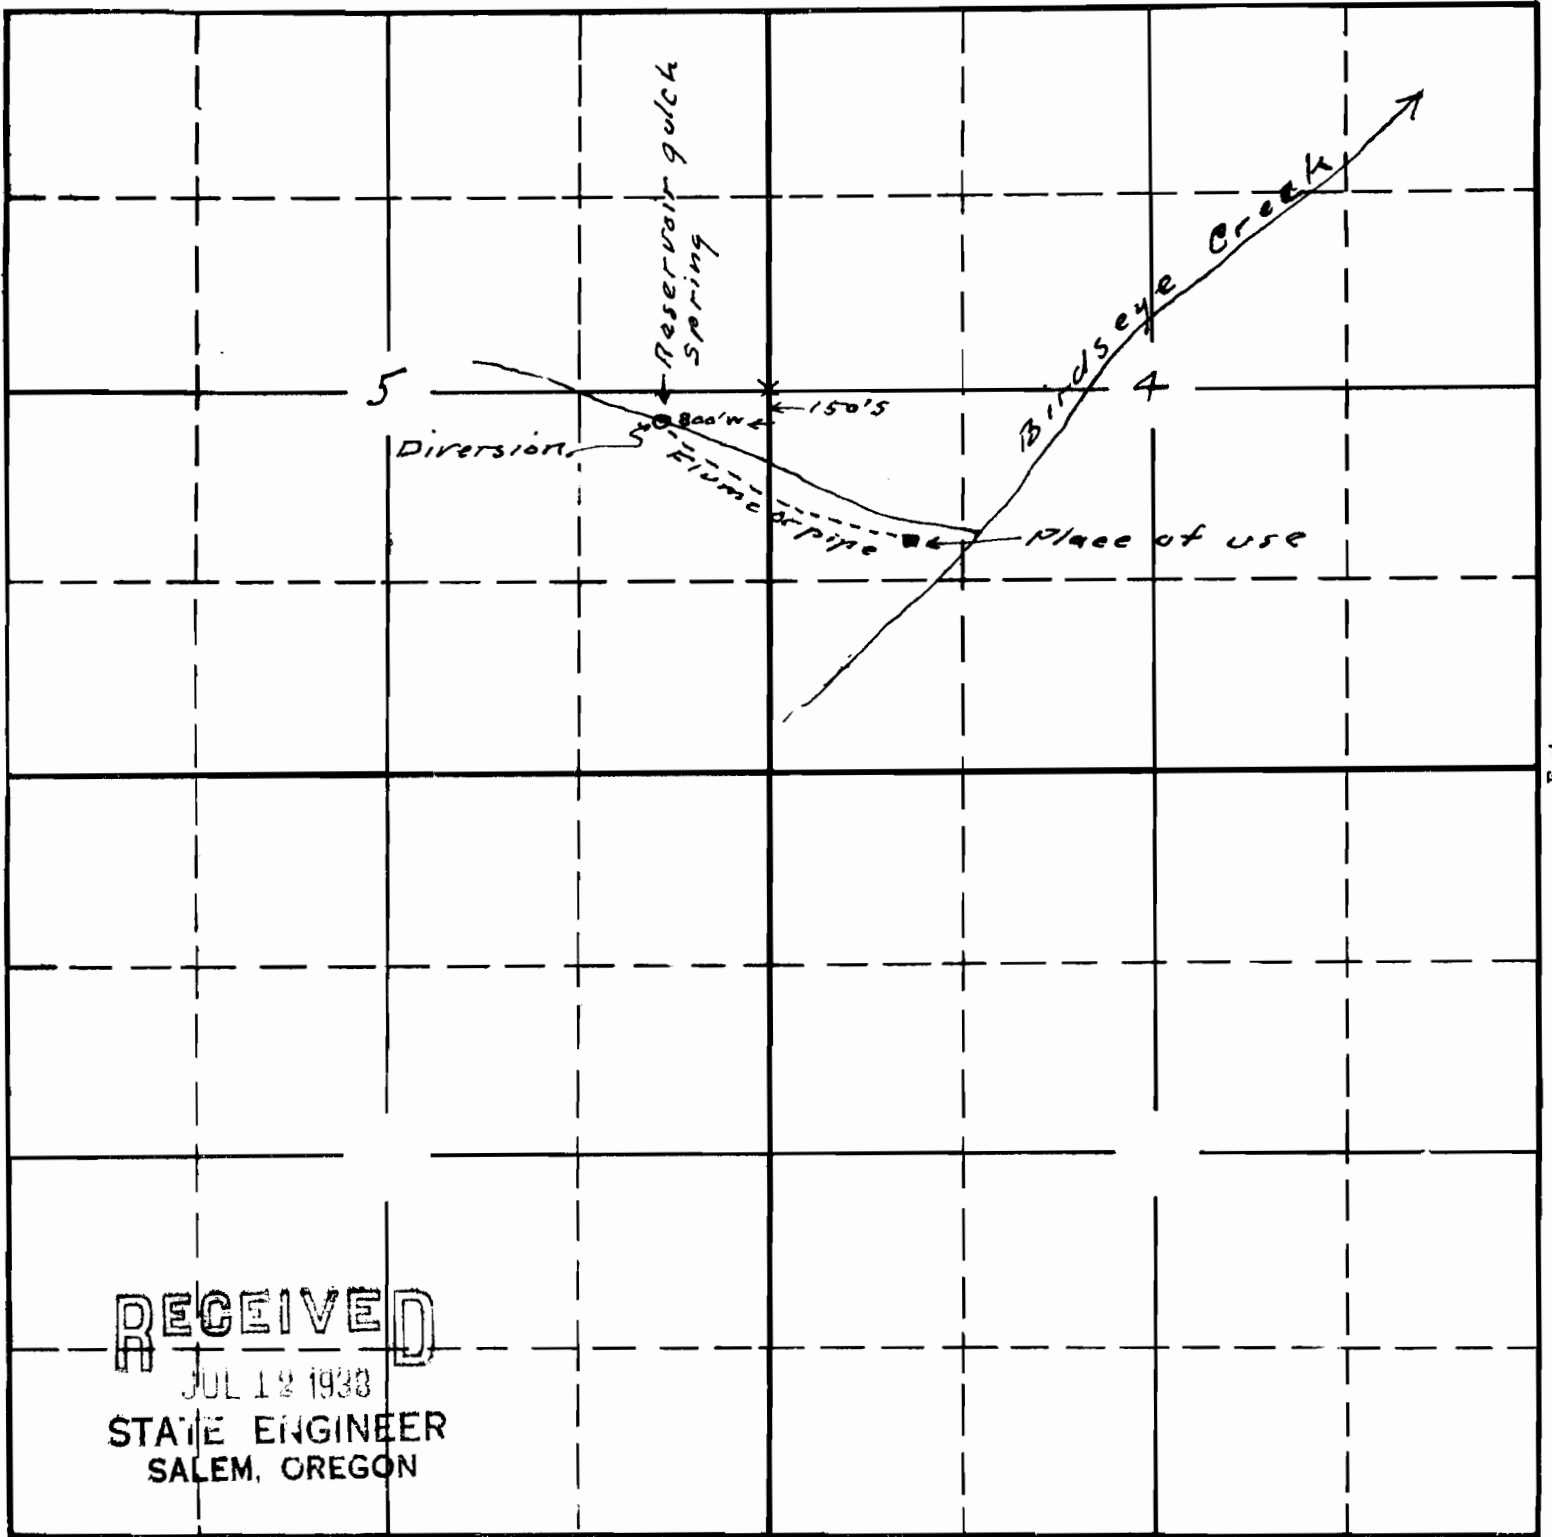

RECEIVED

JUL 12 1938

STATE ENGINEER
SALEM, OREGON

Sketch to accompany application of Elvert Coverdale for use of Reservoir gulch Spring for domestic and 1/2 ac of garden.

made from sketch accompanying application mailed to this office July 7 1938 C.A.S.

17416
1575
APPLICATION No. 17416
PERMIT No. 13112