


SECTION

TOWNSHIP 7S , RANGE 3W , W. M.

North

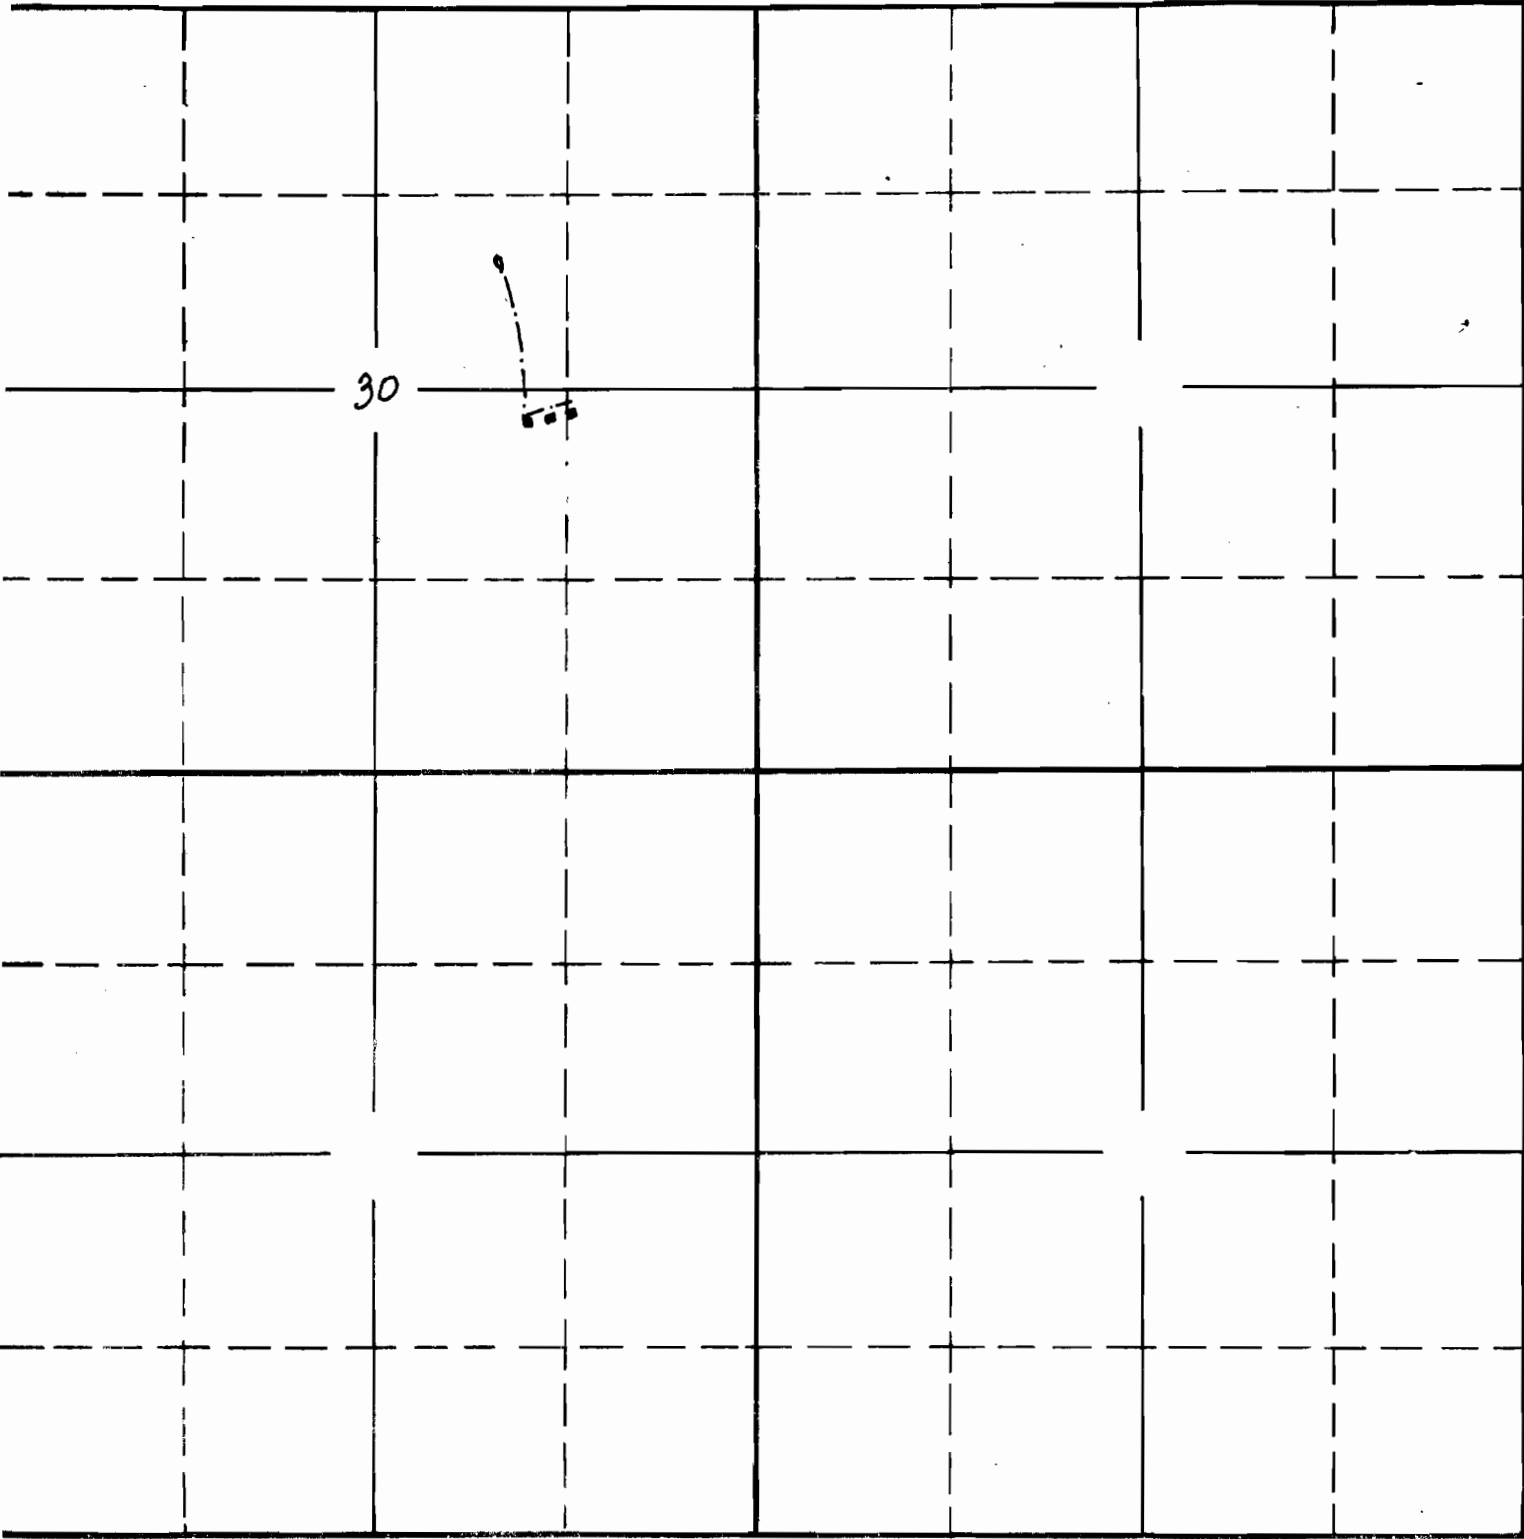

East


South

APPLICATION No. 17429  
PERMIT No. 13122

SECTION 30

TOWNSHIP 7, RANGE 3, W. M.

North

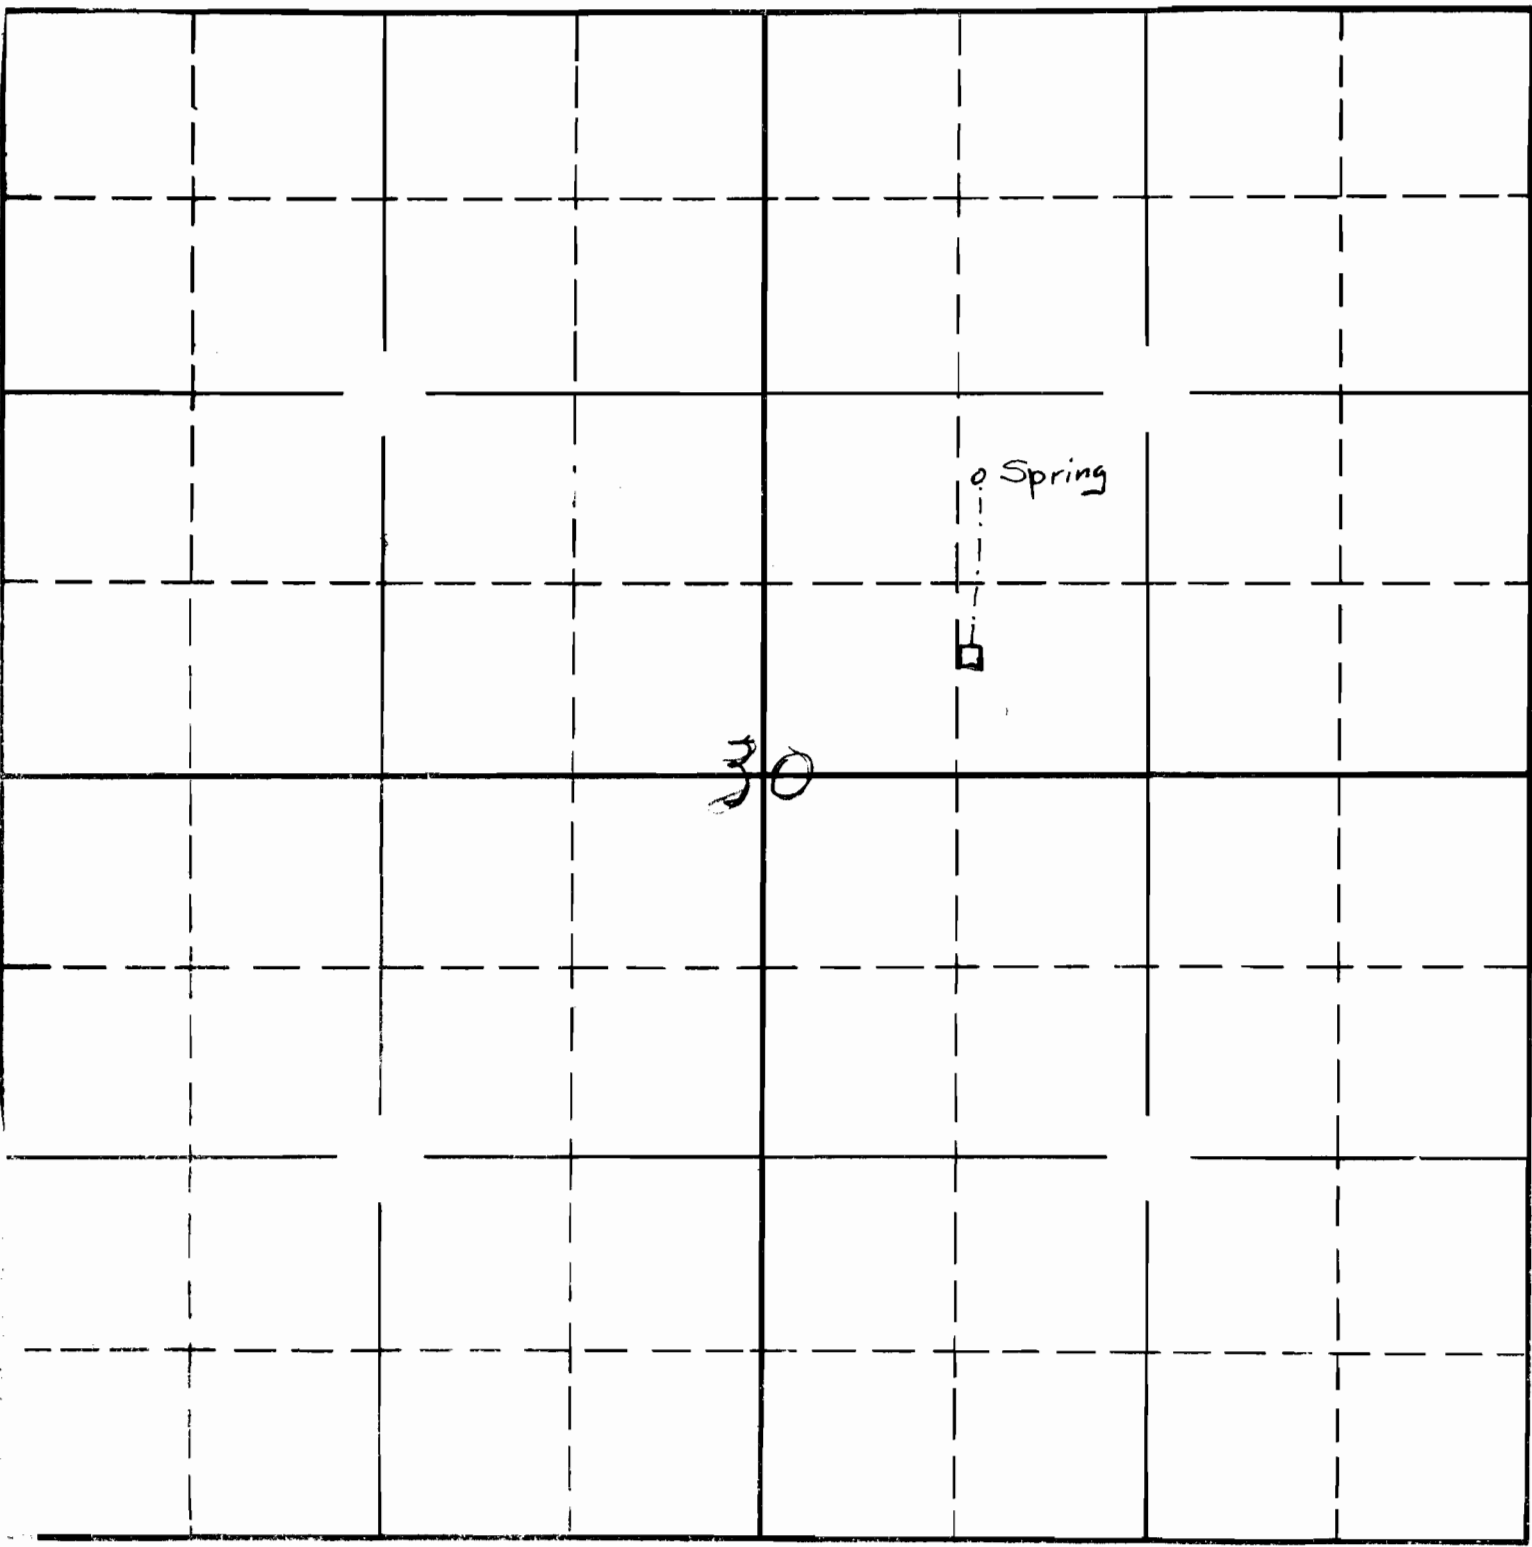

East

South

1741 2 7 92  
2-16-1  
APPLICATION No. 17429  
PERMIT No. 13122