

SECTION


\_\_\_\_\_

\_\_\_\_\_


\_\_\_\_\_

TOWNSHIP 35 S, RANGE 5 W., W. M.

North

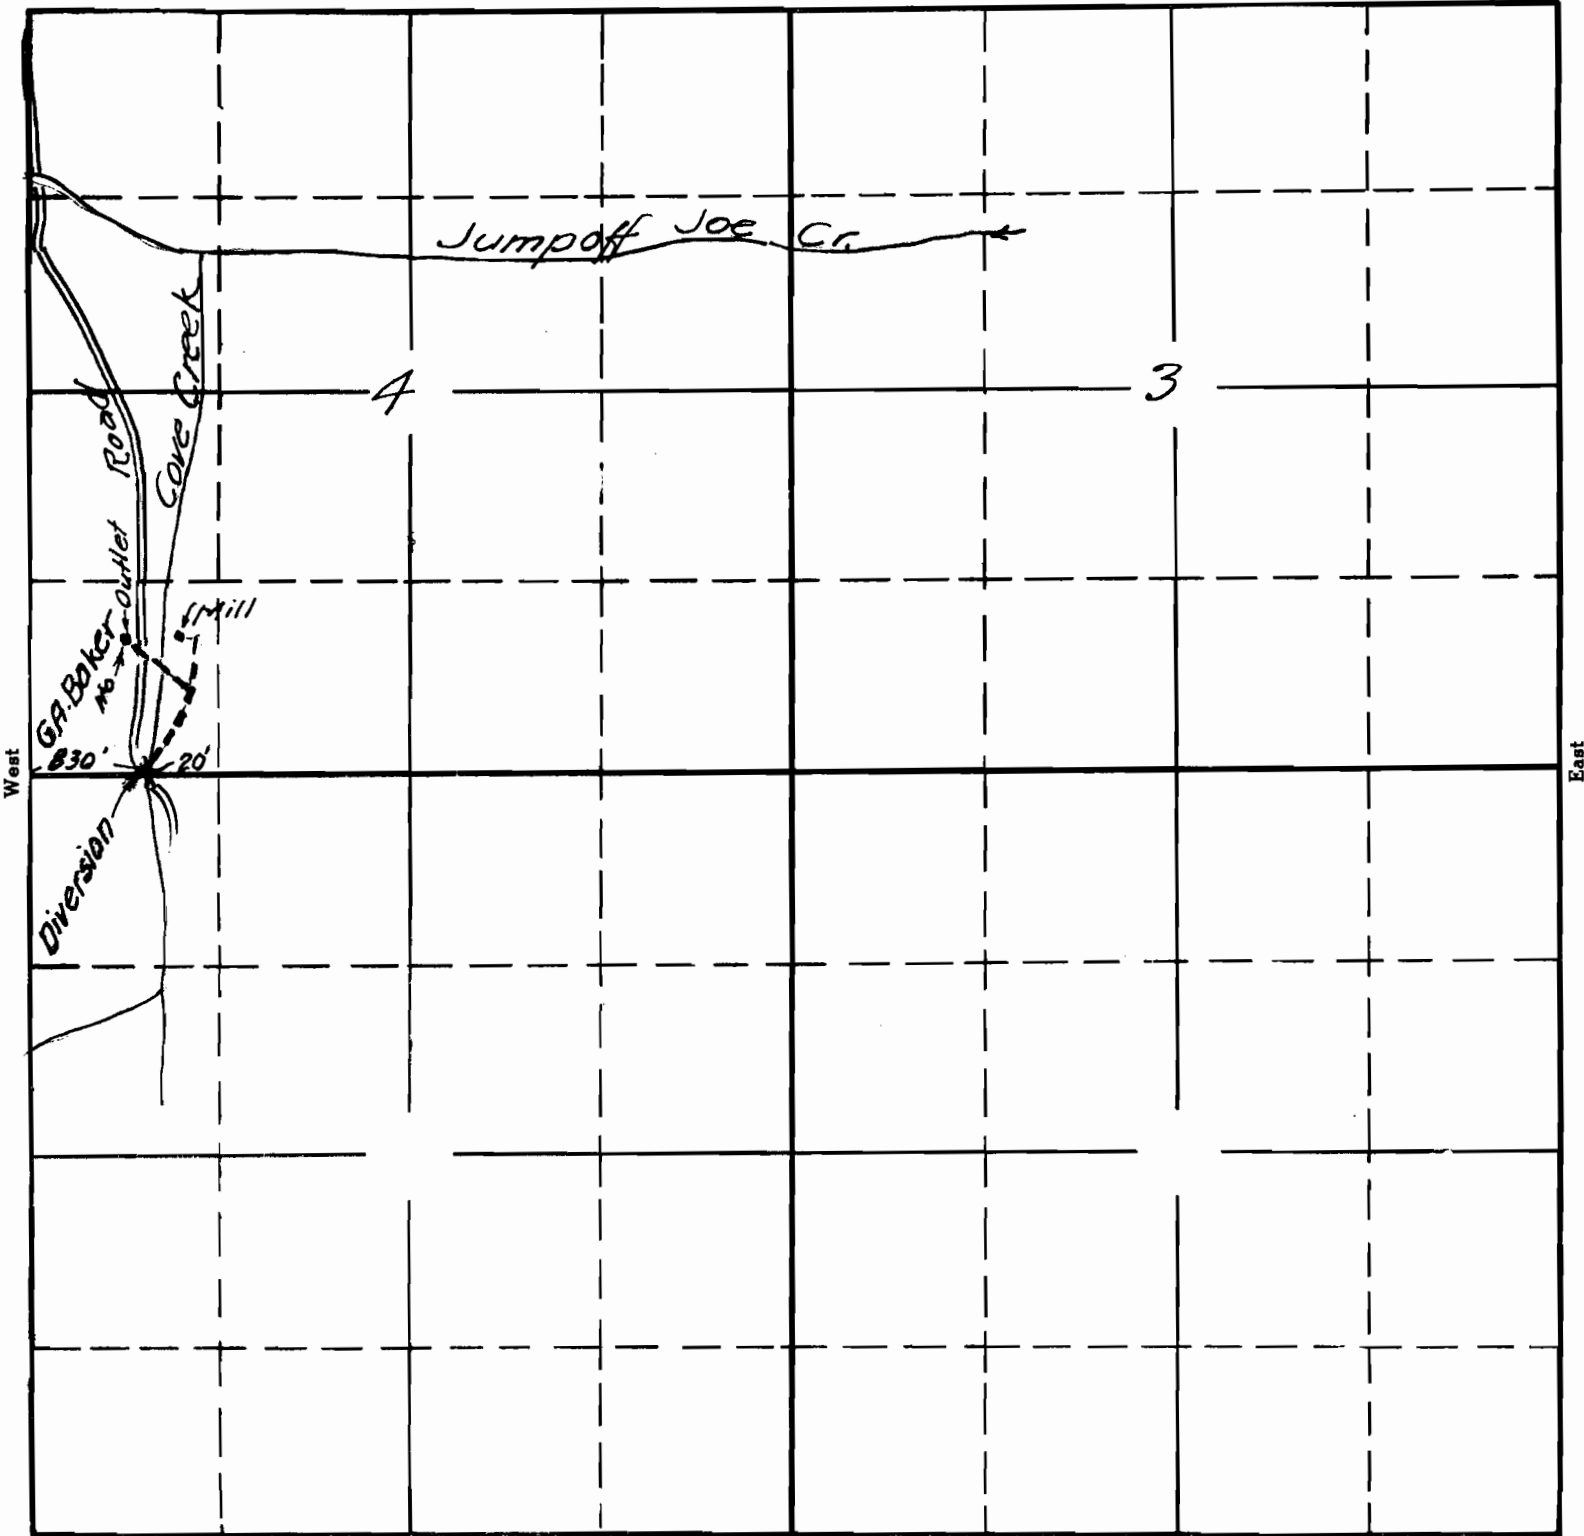

South

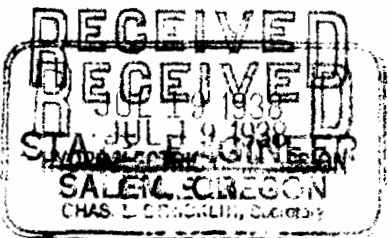

July 1938

17431  
15-75

APPLICATION No. 17431

PERMIT No. 13124