


SECTION

TOWNSHIP 45 , RANGE 1W , W. M.

North

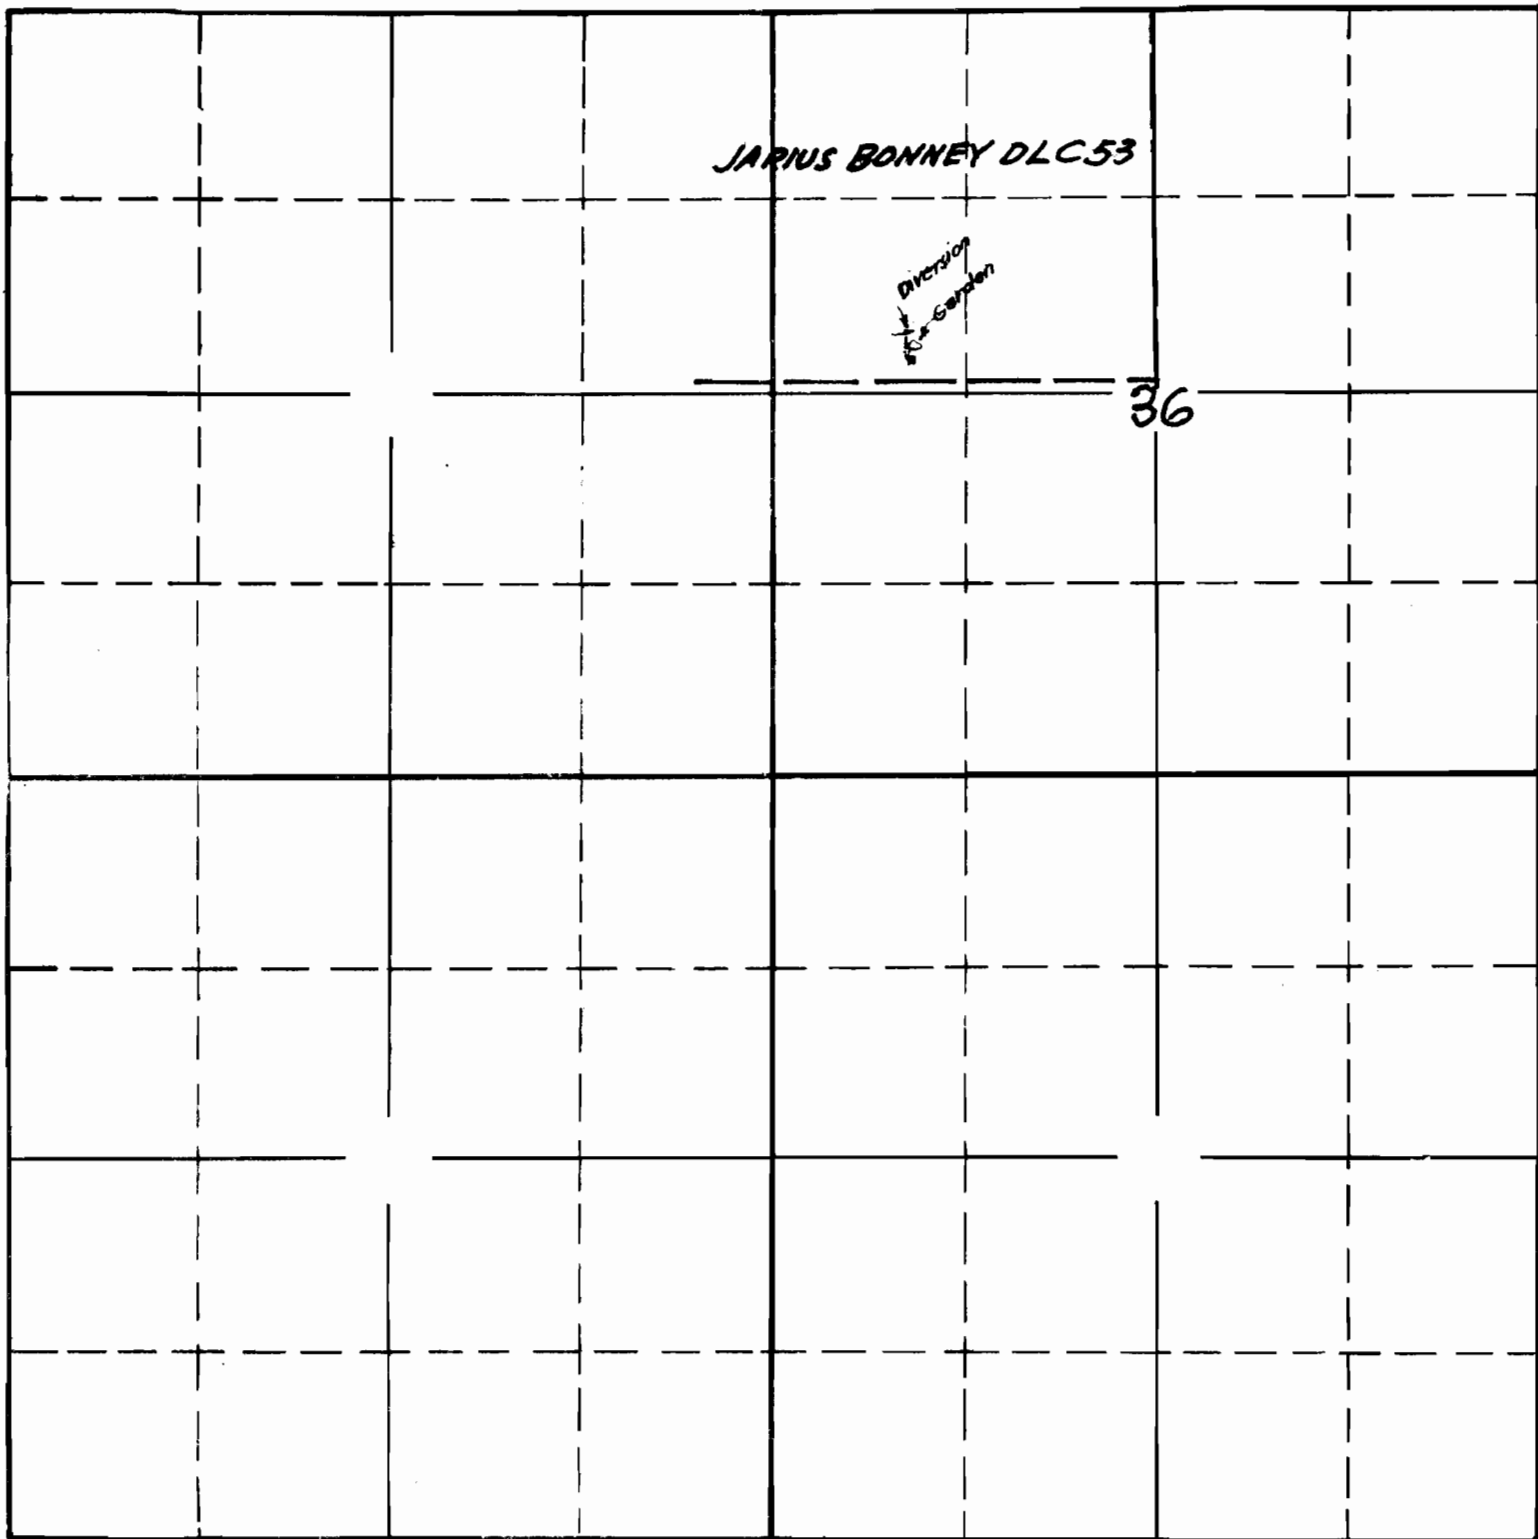

South


APPLICATION No. 17439

PERMIT No. 13125

SECTION

TOWNSHIP 45, RANGE 1W, W. M.

North

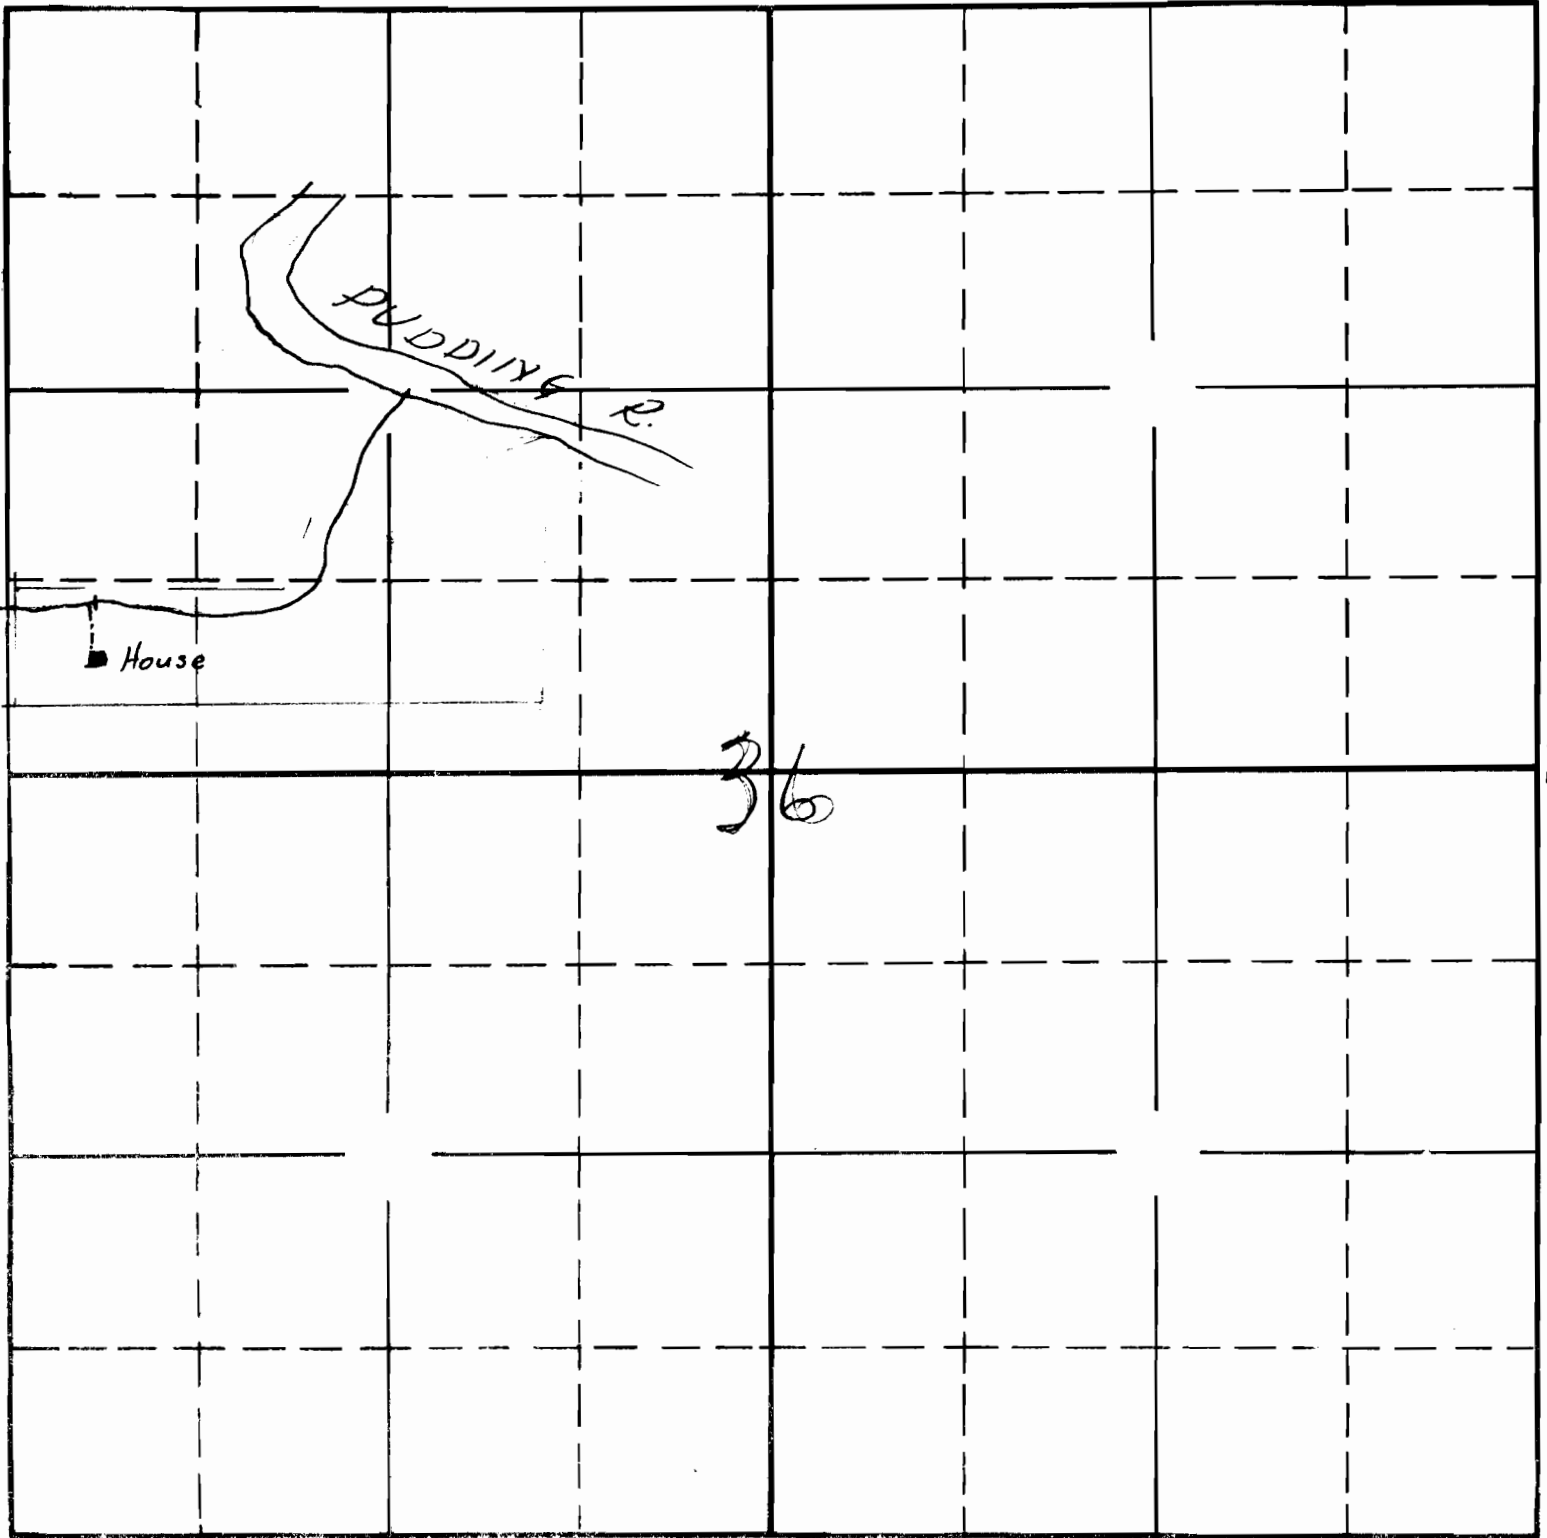

South

Sketched from data
 by applicant in State
 Eng's office 7-18-38

17434
 2-38
 APPLICATION No. 17434
 PERMIT No. 13125