

Oregon State Game Commission
 Portland Oregon
 Rock Creek Trout Hatchery


Scale 1" = 100'

Sec 1, T26S, R3W, W.M.

RECEIVED
 MAY 1 1932

APPLIC. No. 17310
 Permit No. 13138

TOWNSHIP 26S, RANGE 3W, W. M.

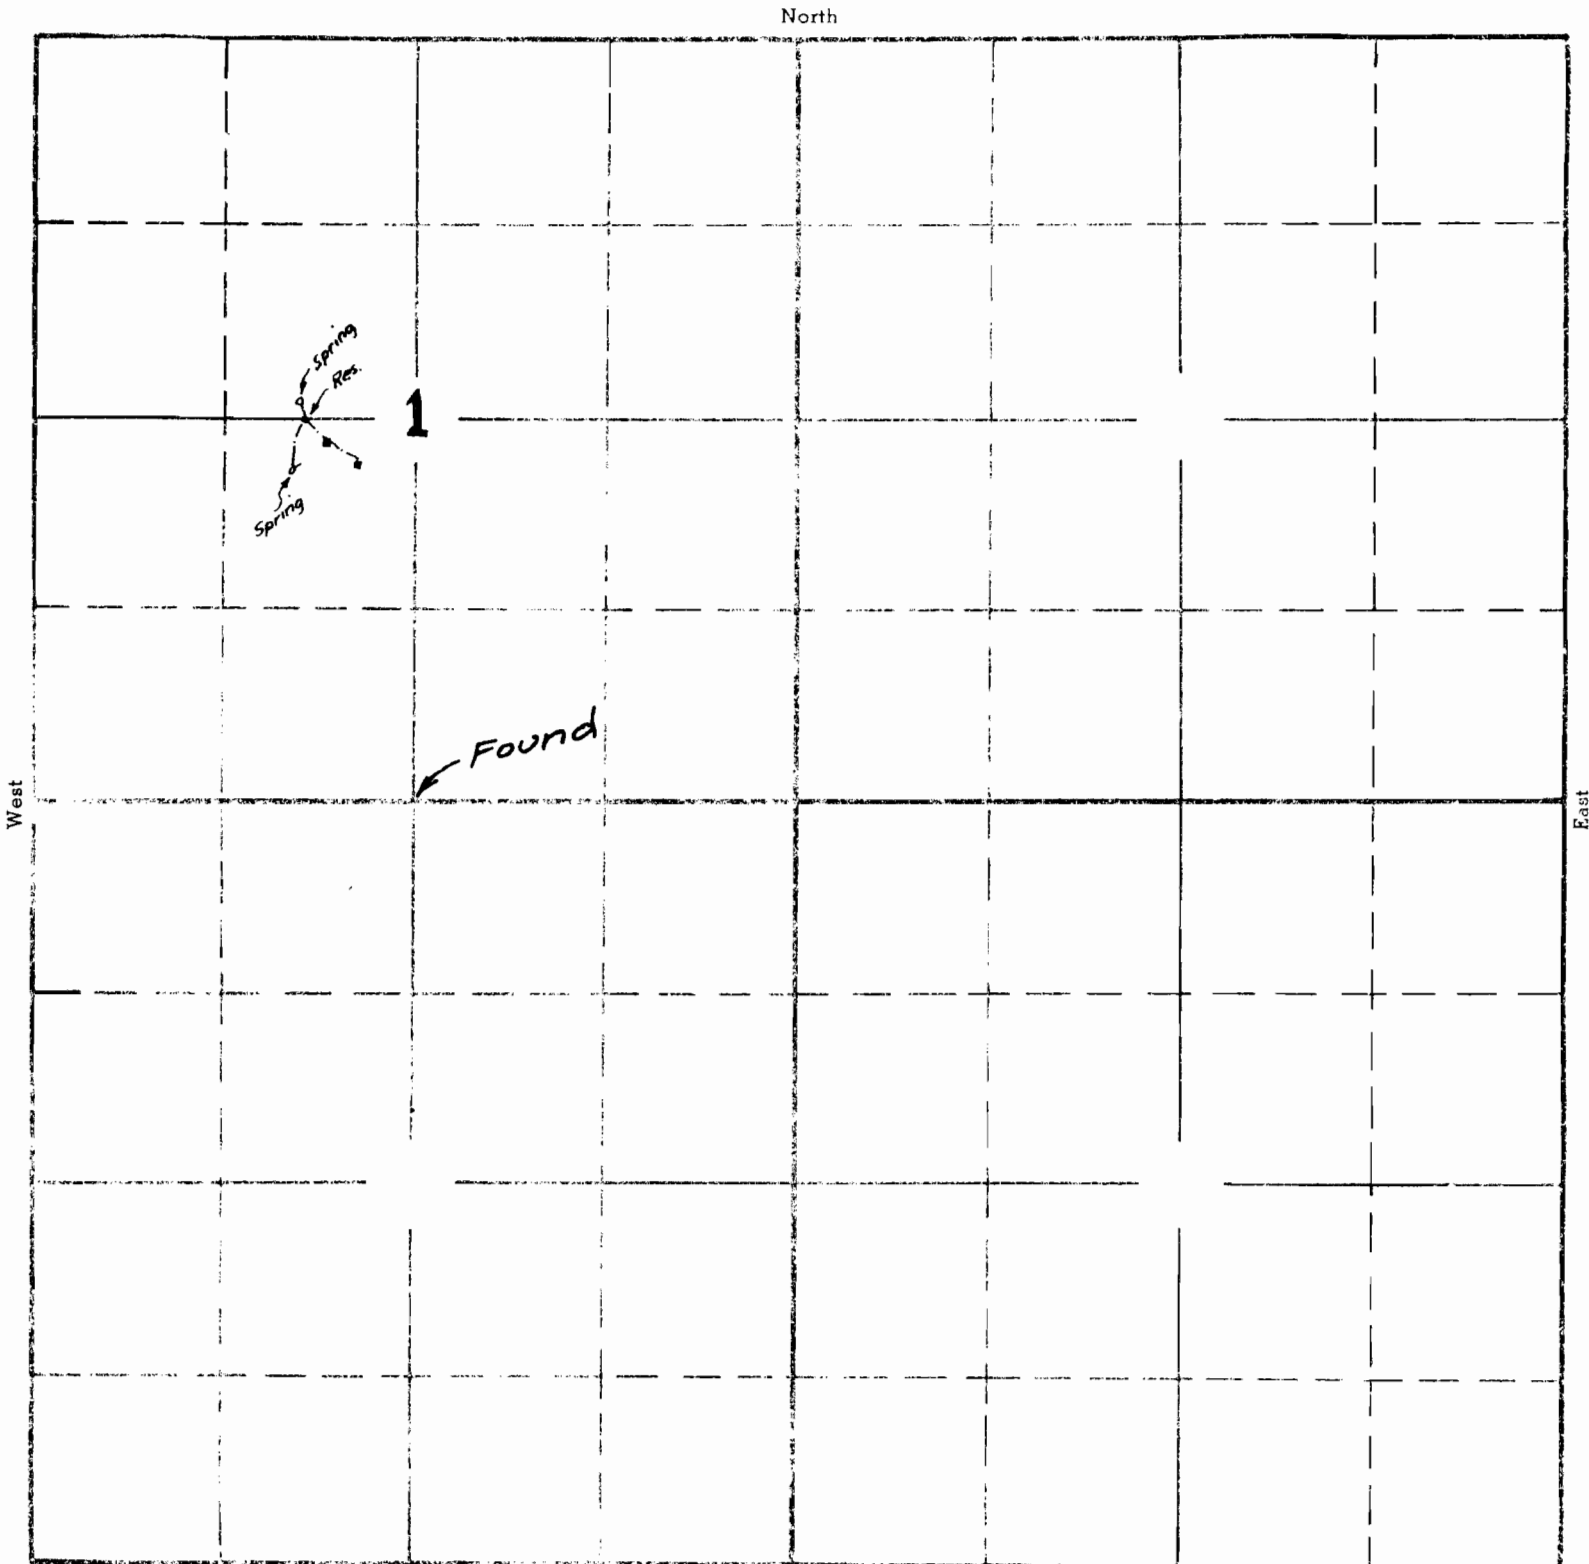

Surveyed by
C. A. Cummings
June 11, 1939

APPLICATION No. 17310
PERMIT No. 13138