


SECTION

21

TOWNSHIP 25, RANGE 9W, W. M.

North

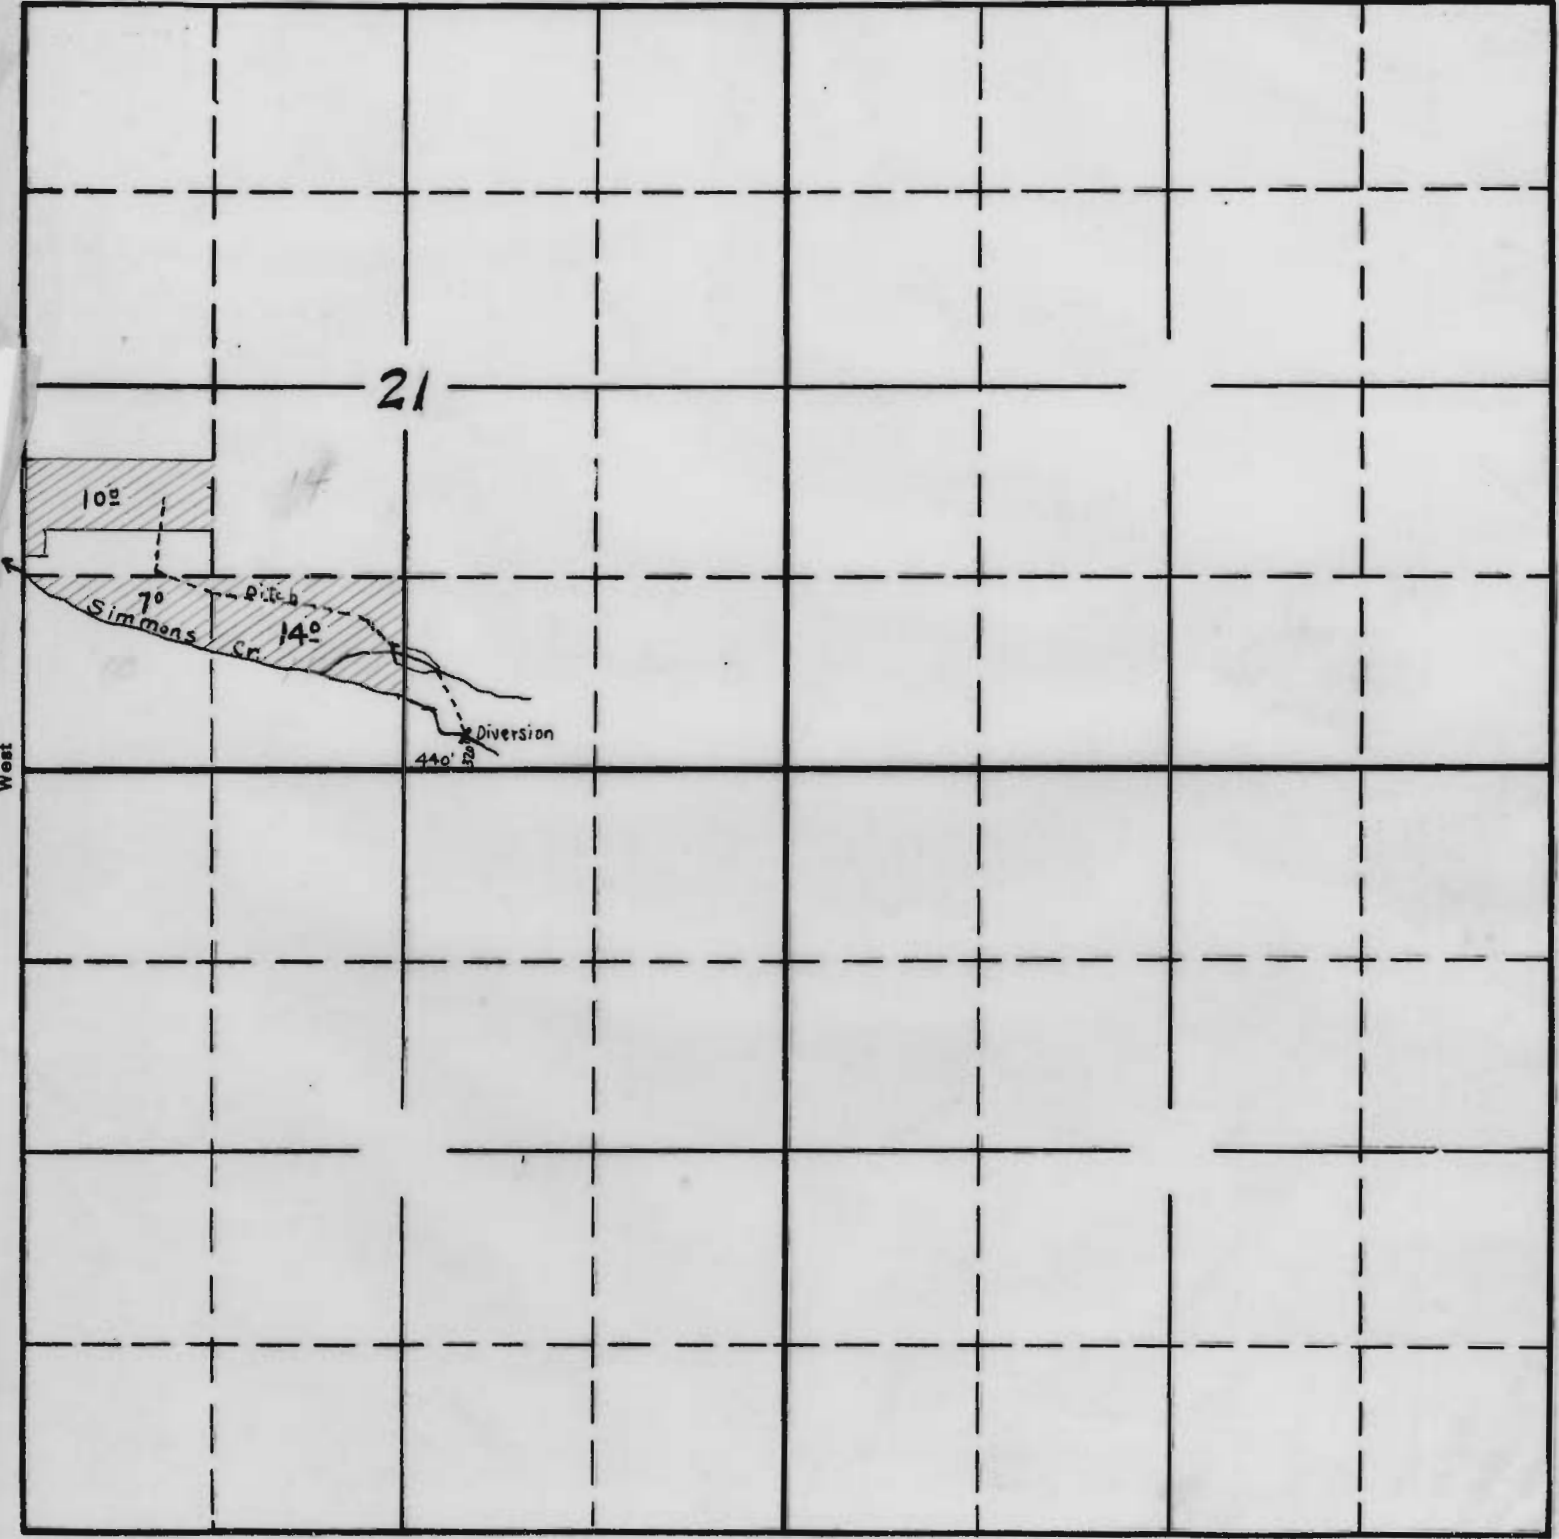

21

10°

7°

14°

440'

West

East

South


Sketch prepared from applicants map submitted with App. 558, same diversion works and ditches being used for this filing.

APPLICATION No. 17450
PERMIT No. 13163

SECTION

TOWNSHIP 25 , RANGE 9W , W. M.

North

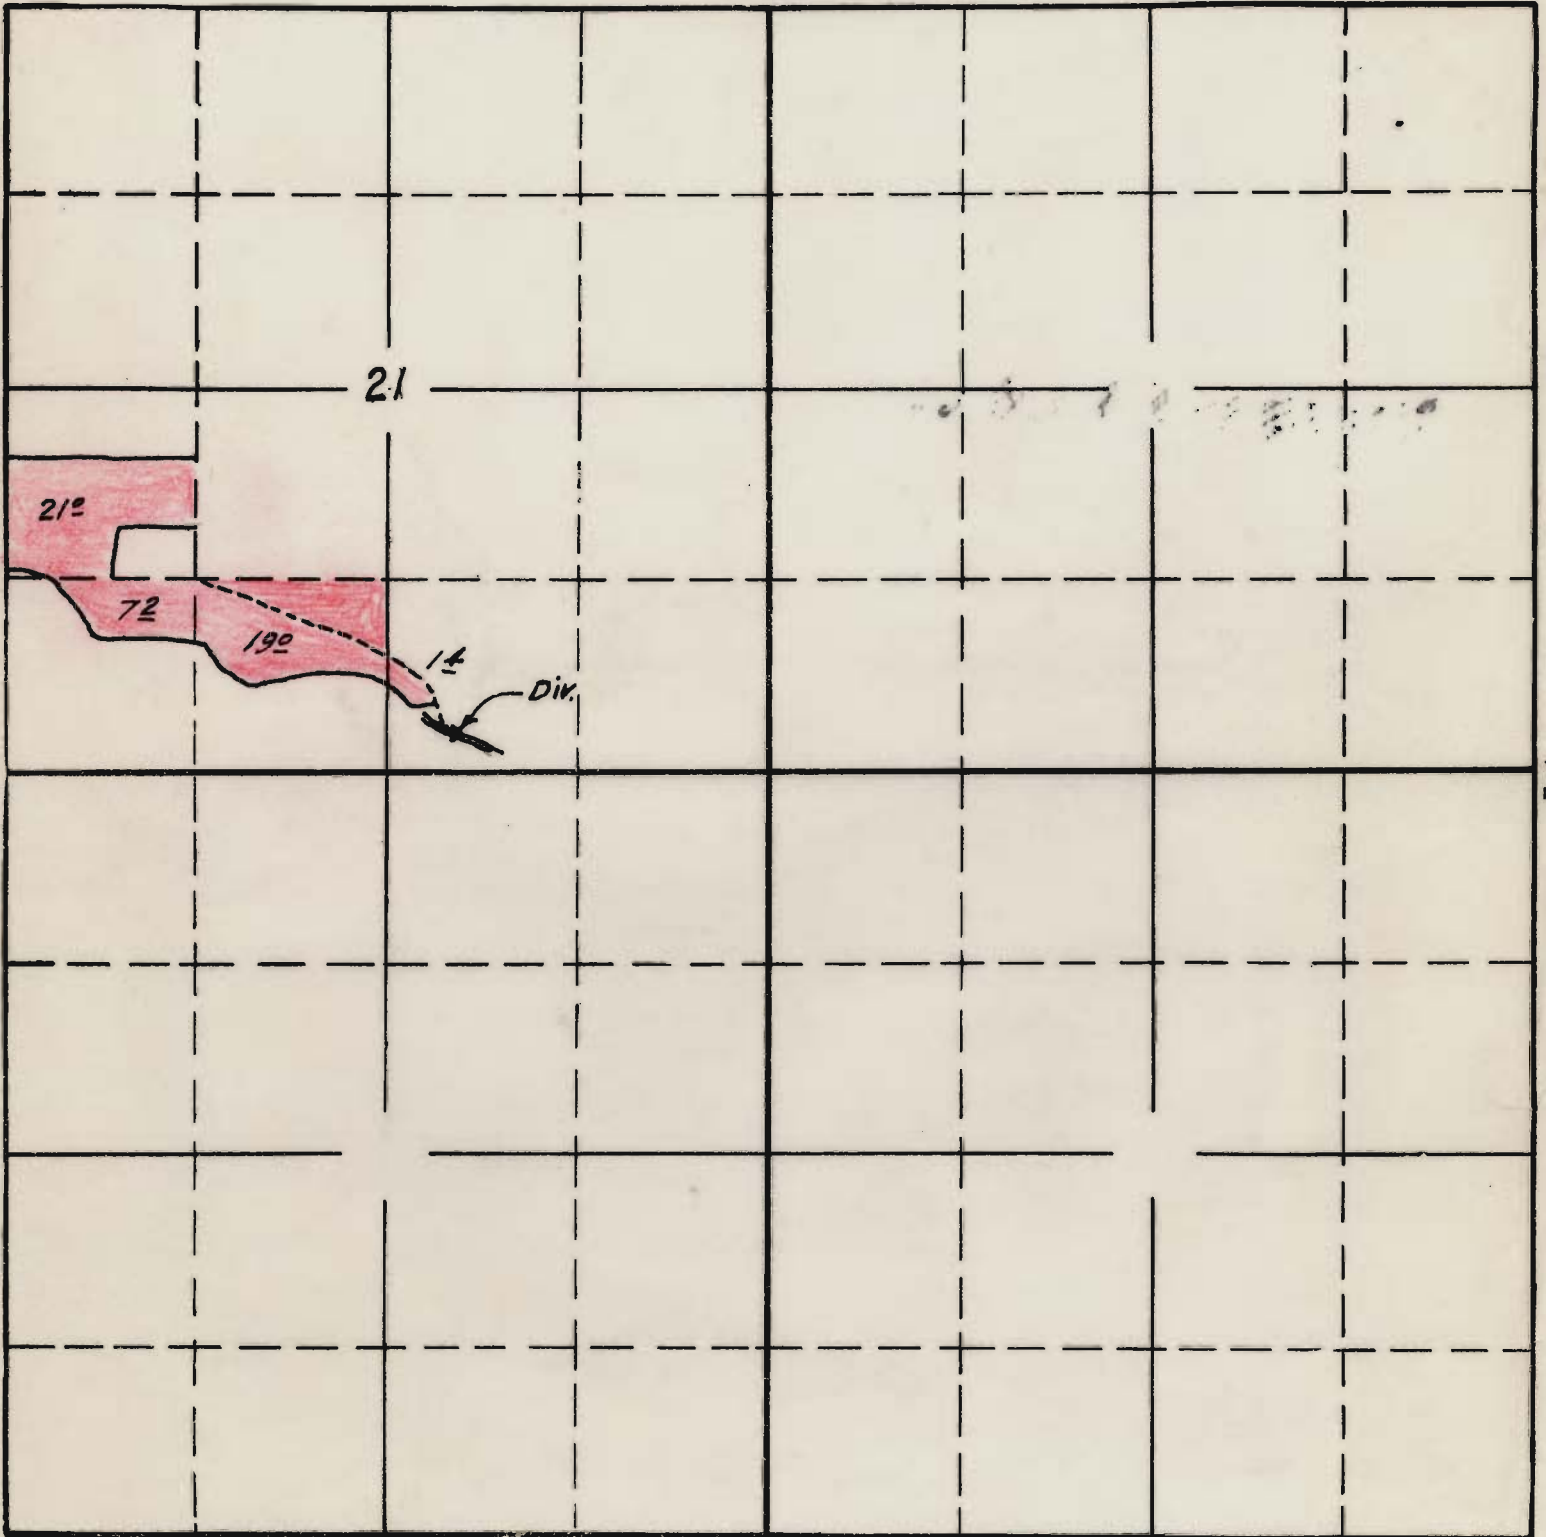

West

East

South

Surveyed by C.A.C. May 31 1959

APPLICATION No. 17450

PERMIT No. 13163