


SECTION

TOWNSHIP ⁴⁵~~1747~~, RANGE ^{2W}~~13182~~, W. M.

North

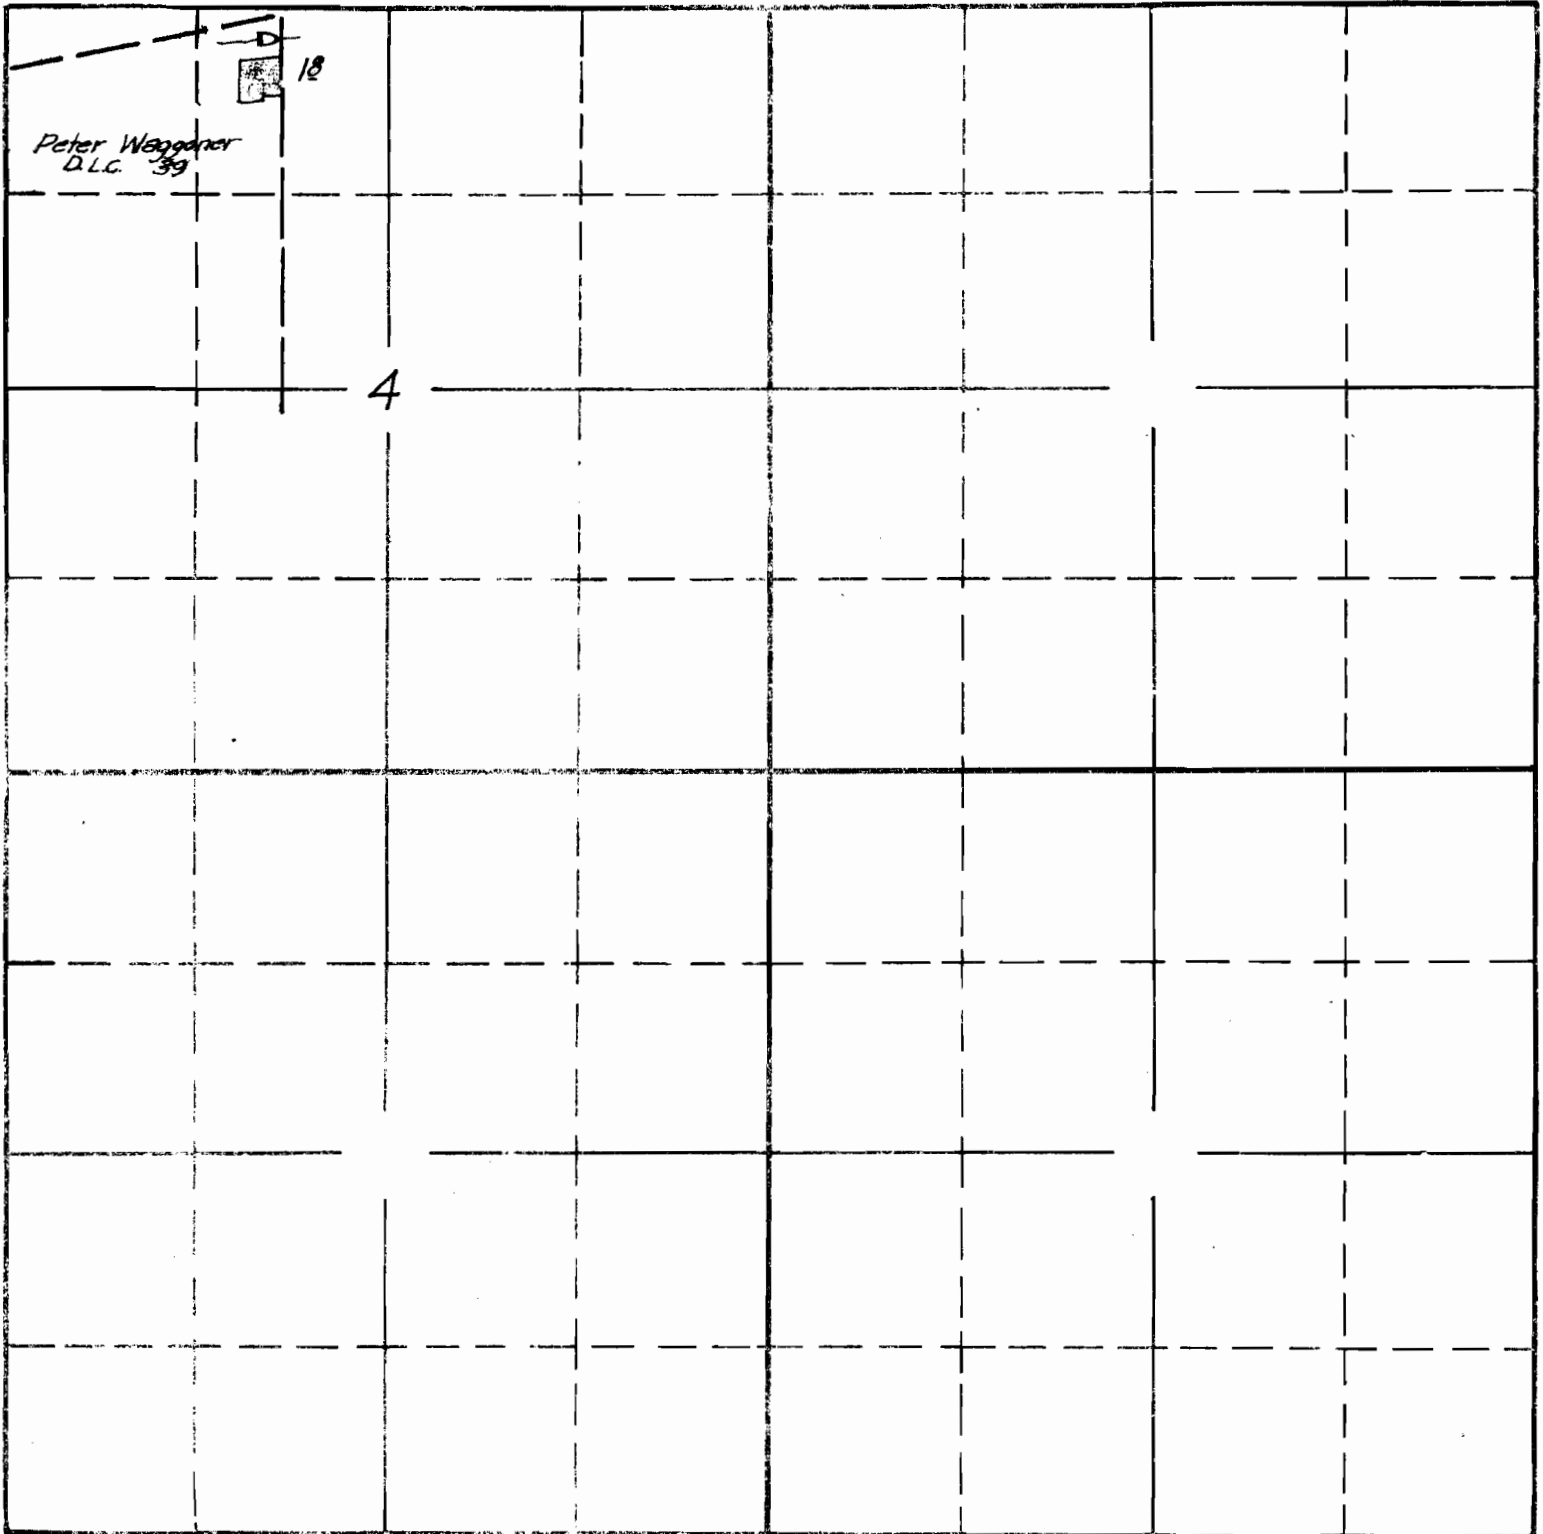

West

East

Surveyed May 24 1940 C.A.B.

South

APPLICATION No. 1747/
PERMIT No. 13182