


SECTION

TOWNSHIP 39 S, RANGE 5 W., W. M.

North

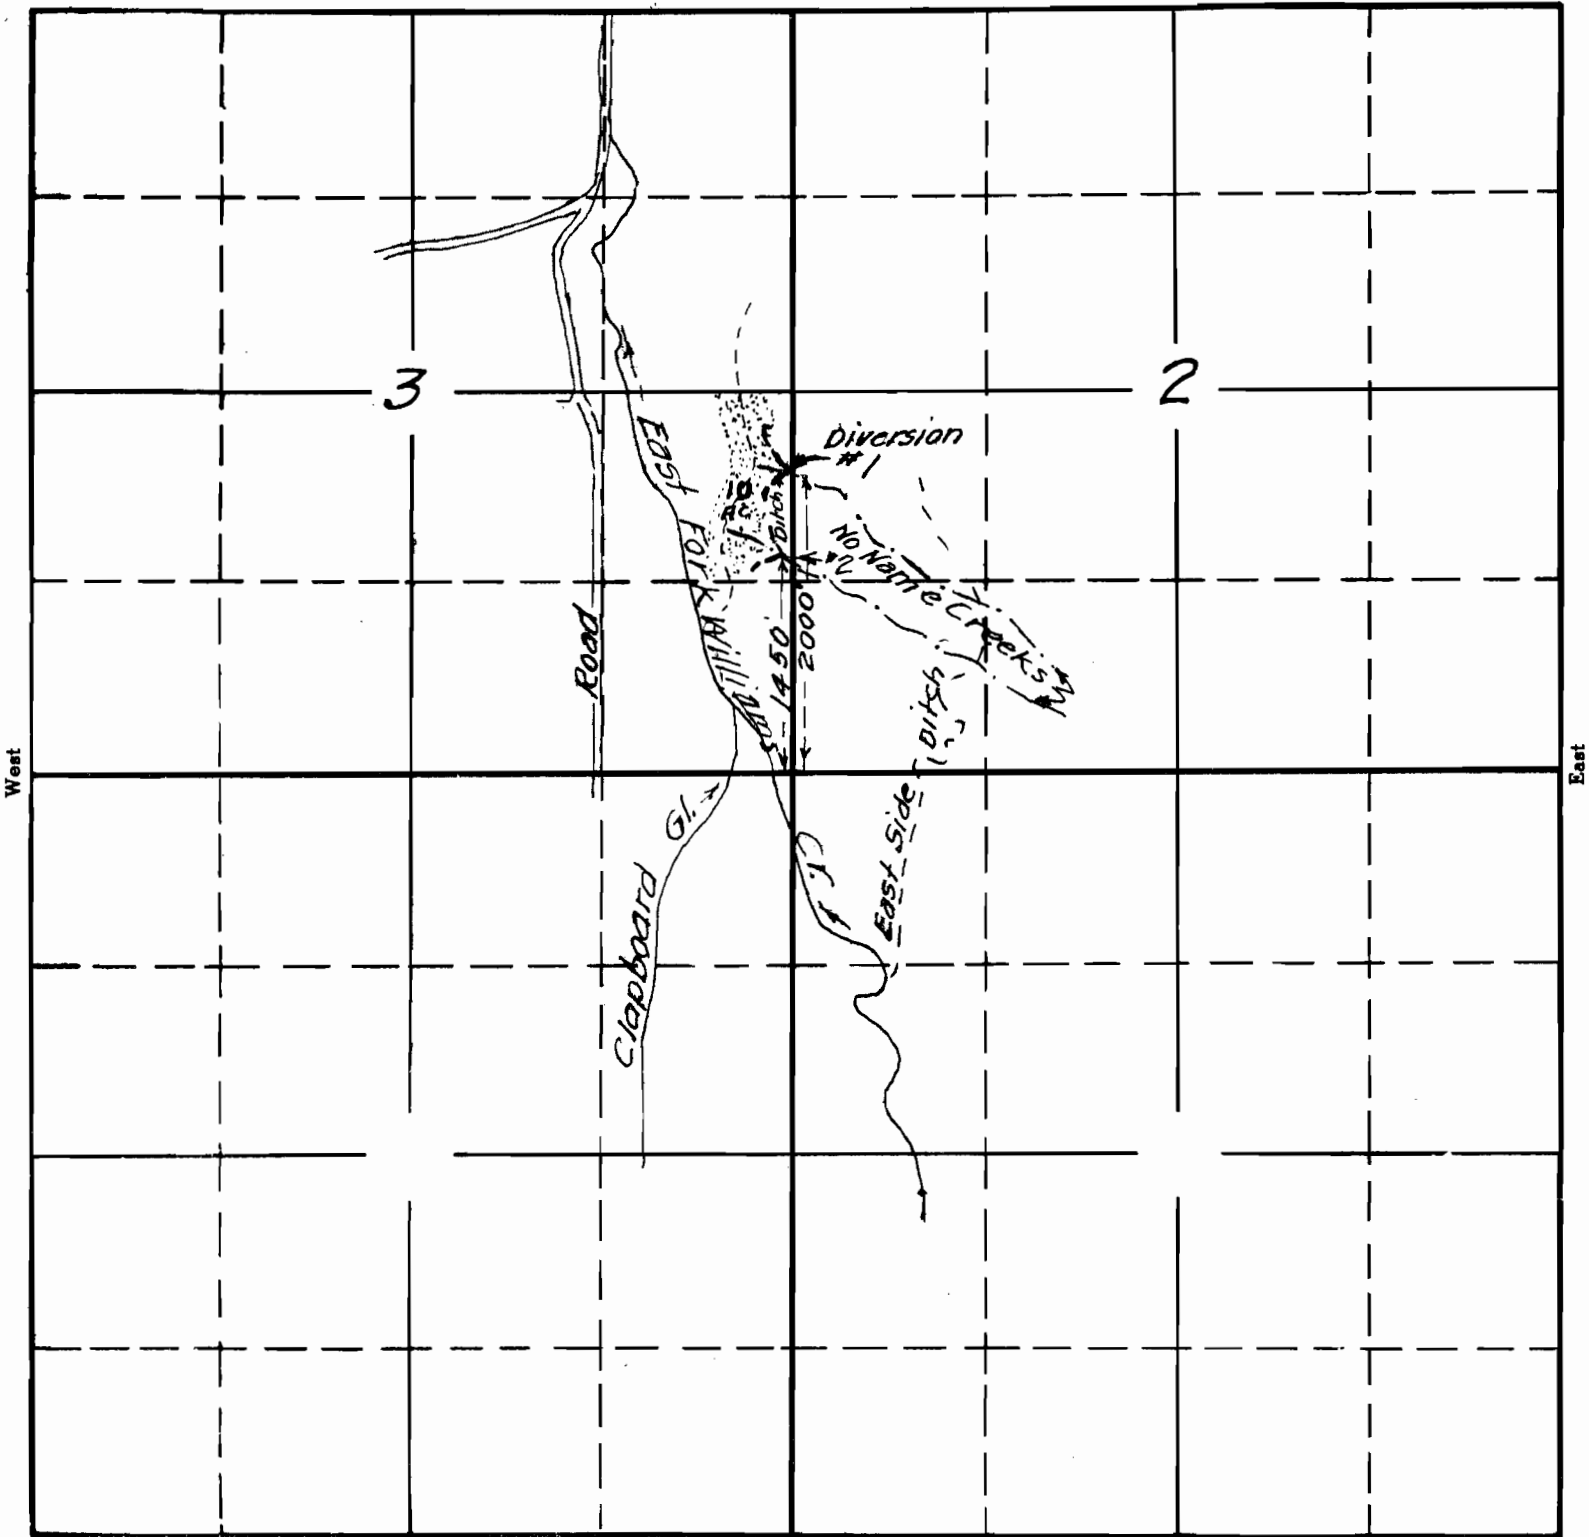

South

17503
17503

RECEIVED
DIVISION OF
STATE ENGINEERS
S. C. ...

Edna H. Preston
Aug. 1938

APPLICATION No. 17503
PERMIT No. 13208