

SECTION


RECEIVED

AUG 31 1938

STATE ENGINEER
SALEM, OREGON

TOWNSHIP 33 S, RANGE 4 W., W. M.

T 33 S. R 4 W. W. M. North

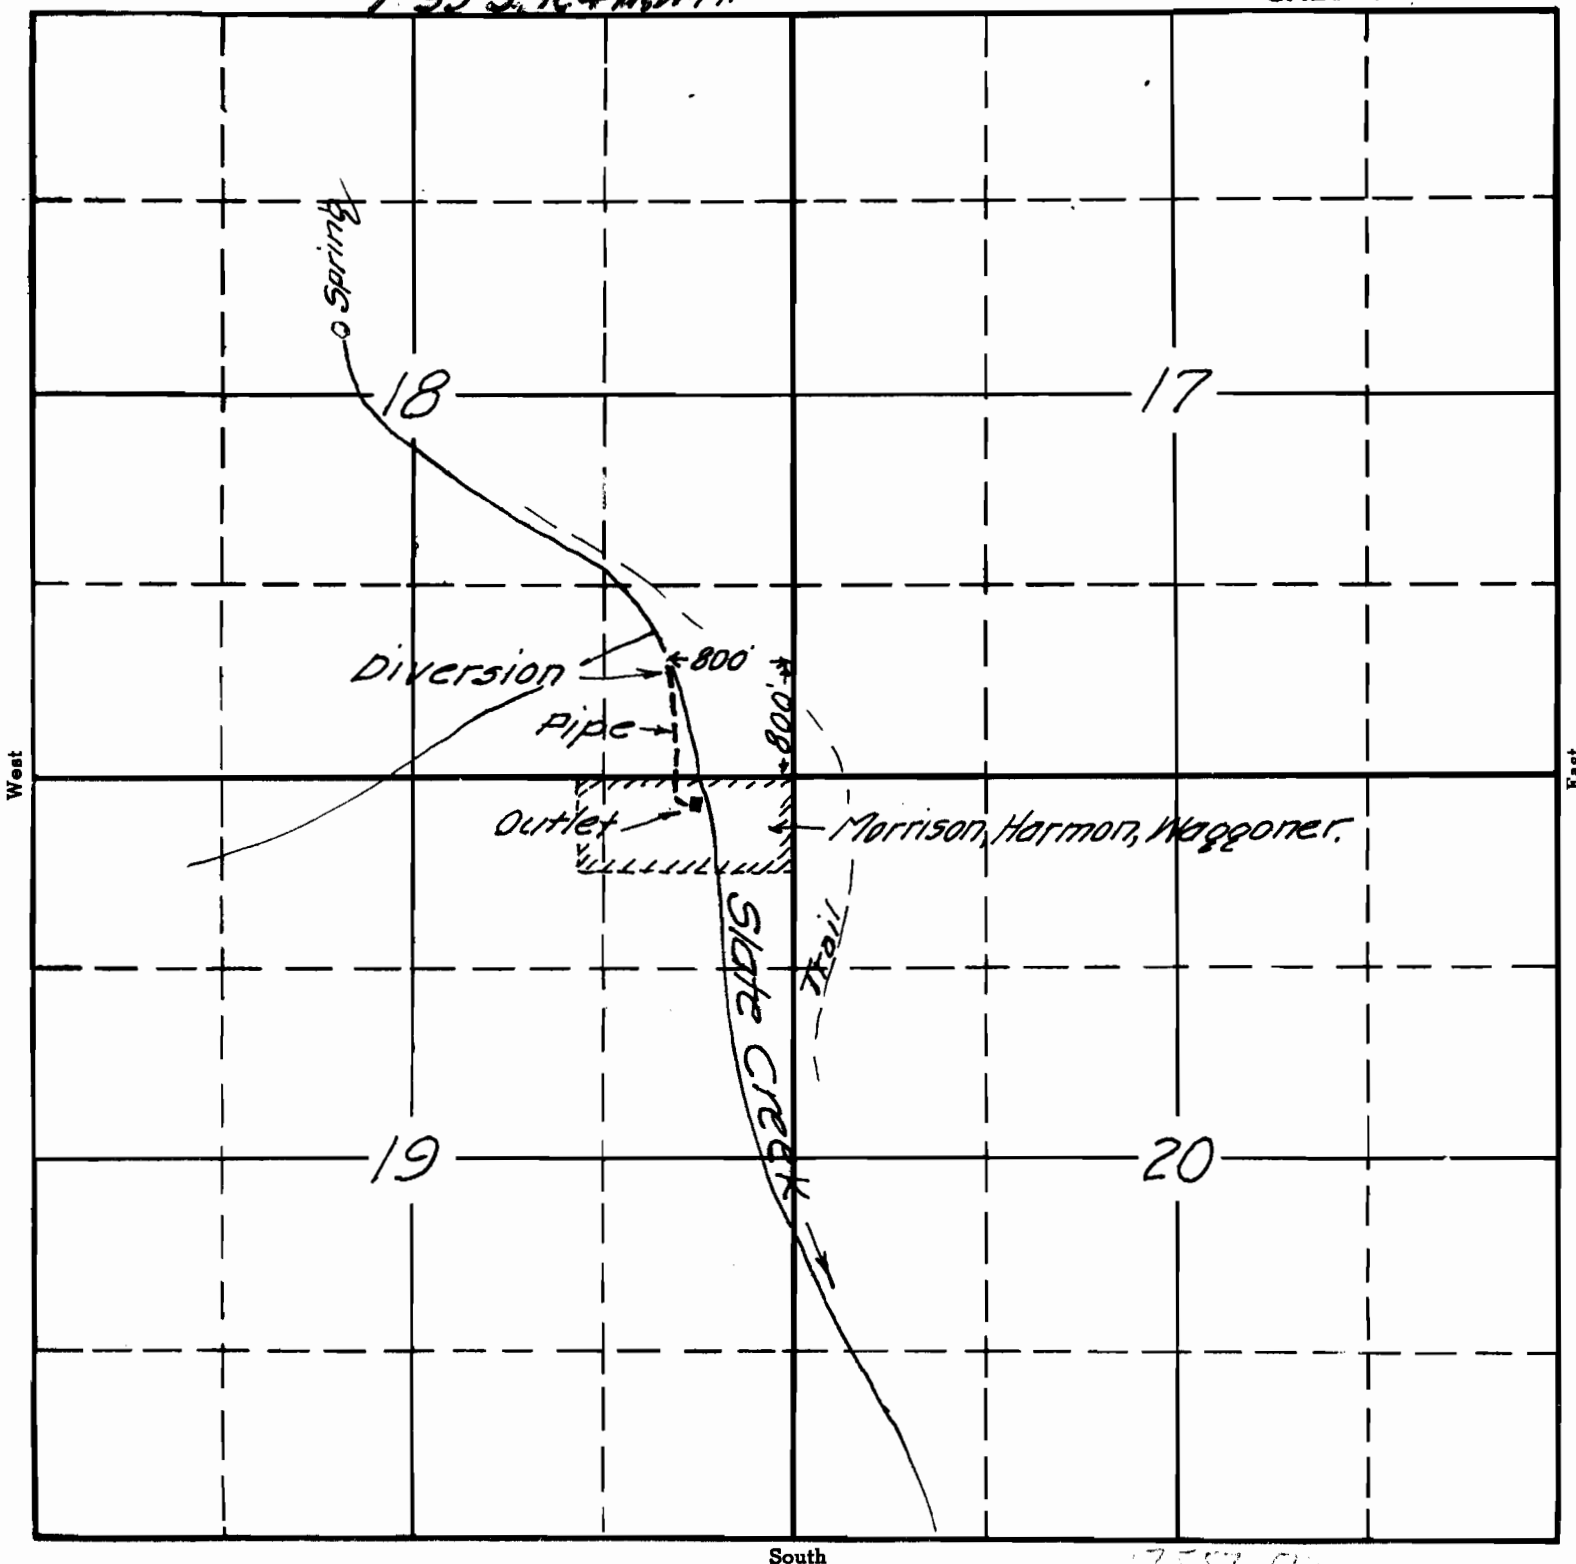

South

Arthur Waggoner APPLICATION No. 17557
AUG. 1938. PERMIT No. 13260